

- NARRATIVE -

THIS SURVEY WAS MADE IN AUGUST, OCTOBER THROUGH DECEMBER, 1991 BY DANIEL W. BAKER OF PEEL BAKER LAND SURVEYING, INC. THE PURPOSE OF THIS SURVEY WAS TO LOCATE AND MARK A PORTION OF THE PROPERTY LINES OF SENECA SAWMILLS IN SECTION 36, T21S, R7W, W.M. BEARINGS WERE BASED ON A SOLAR OBSERVATION. A MINIMUM ERROR OF CLOSURE OF 1'/20,000' WAS OBTAINED ON RANDOM TRANSIT TRAVERSES WERE RUN BETWEEN CORNERS FOR CONTROL AND ALSO ALONG THE LINES TO BE MARKED. ALL CONTROLLING CORNERS WERE MONUMENTED WITH BLM BRASS CAPS. THE SECTION WAS SUBDIVIDED ACCORDING TO THE BLM "MANUAL OF INSTRUCTIONS" AND ALL CORNERS WERE SET AND MARKED ACCORDING TO THE MANUAL. ALL CORNERS WERE MONUMENTED WITH 5/8" REBAR WITH 2" ALUMINUM CAPS. ALL TRUE PROPERTY LINES WERE BLAZED ON EITHER SIDE OF THE TRUE LINE AND BLAZES WERE PAINTED RED.


REGISTERED
**PROFESSIONAL
 LAND SURVEYOR**

Daniel W. Baker


OREGON
 JULY 16, 1982
DANIEL W. BAKER
 1978

- ① **SECTION CORNER 25, 30, 31, 36**
 FND: U.S. BLM BRASS CAP "1987"
 14" FIR, N 14-1/2° E, 15.5'
 19" HEMLOCK, S 80-1/2° E, 41.5'
 12" FIR, S 58° W, 17.5'
 38" FIR, N 71° W, 52.6'
- ② **1/4 CORNER 25 & 36**
 FND: U.S. BLM BRASS CAP "1989"
 12" FIR, N 15° E, 17.8'
 10" FIR, S 73° W, 12.5'
- ③ **SECTION CORNER 25, 26, 35, 36**
 FND: U.S. BLM BRASS CAP "1981"
 13" FIR, N 41-1/2° E, 26.2'
 19" FIR, S 68-1/2° E, 28.2'
 16" FIR, S 16° W, 25.1'
 54" FIR, N 50° W, 76.1'
 10" FIR, N 13-1/2° W, 19.8'
- ④ **NORTH 1/16 CORNER 35 & 36**
 FND: "T" IRON "HAINES 239"
 44" FIR, N 24° E, 81.8', BARK INSCRIBED
 34" FIR, S 44° E, 33.1', BARK INSCRIBED
- ⑤ **1/4 CORNER 35 & 36**
 FND: U.S. BLM BRASS CAP "1981"
 46" FIR STUMP, N 15° W, 61.6'
 14" HEMLOCK, S 7° E, 12.7'
- ⑥ **1/4 CORNER 36 & 1**
 FND: U.S. BLM BRASS CAP "1986"
 17" FIR, S 32-1/2° W, 6.9'
 21" FIR, N 13-1/2° W, 9.9'
- ⑦ **1/4 CORNER 31 & 36**
 FND: BLM BRASS CAP "1987"
 ROTTED FIR STUMP, N 52° E, 25.31'
 18" HEMLOCK, N 30° W, 16.4'
 14" HEMLOCK, S 53° E, 23.6'

- ⑧ **CENTER-NORTH 1/16 CORNER**
 SET: 5/8" X 30" REBAR AND ALUMINUM CAP
 19" FIR, N 40° E, 8.9'
 SCRIBED CN 1/16 S36 BT
 17" FIR, N 59° W, 5.7'
 SCRIBED CN 1/16 S36 BT
- ⑨ **NORTHWEST 1/16 CORNER**
 SET: 5/8" X 30" REBAR AND ALUMINUM CAP
 46" FIR, S 64° E, 28.6'
 SCRIBED NW 1/16 S36 BT
 14" FIR, N 17° W, 21.1'
 SCRIBED NW 1/16 S36 BT
- ⑩ **CENTER-WEST 1/16 CORNER**
 SET: 5/8" X 30" REBAR AND ALUMINUM CAP
 12" FIR, N 32° E, 25.1'
 SCRIBED CW 1/16 S36 BT
 11" FIR, N 87° W, 24.0'
 SCRIBED CW 1/16 S36 BT
- ⑪ **CENTER 1/4 CORNER**
 SET: 5/8" X 30" REBAR AND ALUMINUM CAP
 18" FIR, N 46° E, 21.3'
 SCRIBED C 1/4 S36 BT
 10" FIR, S 51° E, 22.7'
 SCRIBED C 1/4 S36 BT
 8" FIR, S 54° W, 25.7'
 SCRIBED C 1/4 S36 BT
 25" FIR, N 31° W, 20.9'
 SCRIBED C 1/4 S36 BT
- ⑫ **NORTH 1/16 CORNER 36 & 31**
 SET: 5/8" X 72" REBAR AND ALUMINUM CAP
 23" FIR, S 8° W, 25.0'
 SCRIBED N 1/16 S36 BT
 28" FIR, N 56° W, 18.7'
 SCRIBED N 1/16 S36 BT

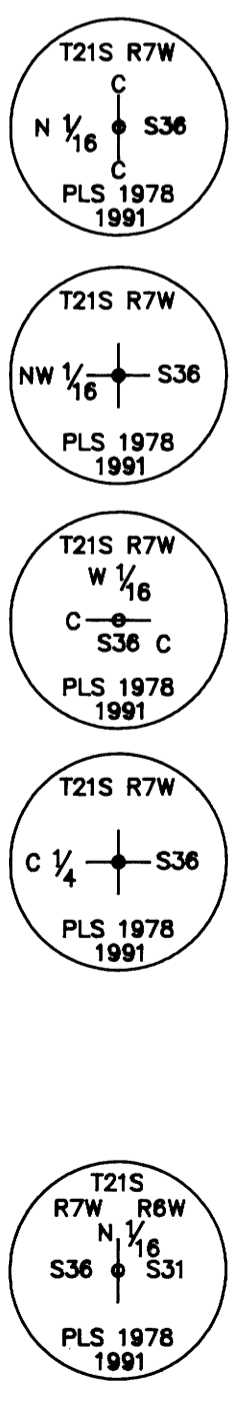

- ⑬ **NORTHEAST 1/16 CORNER**
 SET: 5/8" X 30" REBAR AND ALUMINUM CAP
 12" FIR, N 23° E, 14.5'
 SCRIBED NE 1/16 S36 BT
 15" FIR, S 88° E, 19.6'
 SCRIBED NE 1/16 S36 BT
- ⑭ **EAST 1/16 CORNER 25 & 36**
 SET: 5/8" X 30" REBAR AND ALUMINUM CAP
 16" FIR, N 33° E, 16.2'
 SCRIBED E 1/16 S25 BT
 15" FIR, S 77° E, 6.8'
 SCRIBED E 1/16 S36 BT

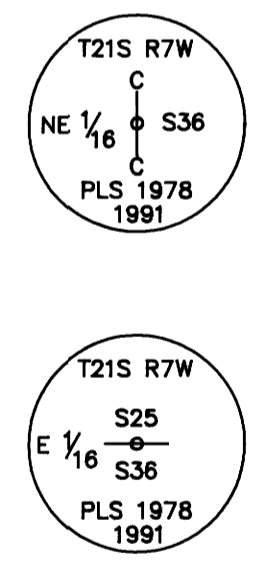

BASIS OF BEARING: SOLAR OBSERVATION

- LEGEND**
- ⊙ - CORNERS FOUND (AS NOTED)
 - - CORNERS SET (5/8" X 30" REBAR WITH ALUMINUM CAP) (UNLESS OTHERWISE NOTED)
 - - CALCULATED POINT (NOT SET)
 - - BLAZED PROPERTY LINE
 - [] - RECORD DATA - BLM OR GLO

SURVEY IN	
NORTH 1/2 OF SECTION 36, T21S, R7W, W.M.	
DOUGLAS COUNTY, OREGON	
CLIENT:	SENECA SAWMILLS
DRAWN BY: <i>Calvin</i>	PEEL BAKER LAND SURVEYING, INC.
DATE: 12.09.91	1385 OAK STREET-SUITE 3 EUGENE, OREGON

COUNTY SURVEYORS FILE DATA
 DO NOT REMOVE FROM OFFICE

MAP FILE M-114 - 26