

WITNESS CORNER TO LINE TREE, WEST LINE

FD. 1981 ALUM. PIPE & CAP AS SET IN SURVEY M91-55
50" LINE TREE STUMP BEARS N0°06'43"E, 12.00'
16" HEMLOCK, S42°W, 25.7' (SCRIBE VIS.), 1981 W.C.B.T.
24" HEMLOCK, N12°W, 50.4' (SCRIBE VIS.), 1981 W.C.B.T.

WEST 1/16 CORNER SOUTH LINE SECTION 22

FD. 1981 ALUM. PIPE & CAP AS SET IN SURVEY M91-55
12" HEMLOCK, S25°E, 35.0' (SCAR VIS.), 1981 B.T.
15" HEMLOCK, NORTH, 53.4' (SCAR VIS.), 1981 B.T.

SURVEY HISTORY, THE SURVEY HISTORY OF SECTION 22, T20S, R11W, W.M., IS AS FOLLOWS; THE EXTERIOR BOUNDARIES OF SECTION 22 WERE SURVEYED BY WILLIAM THIEL IN 1891-1892. IN 1964, DEPUTY COUNTY SURVEYOR MILO GODFREY, SET A BRASS CAP AT THE WEST 1/4 CORNER OF SECTION 22 (SEE RENEWAL NO. 37). IN 1978, PRIVATE SURVEYOR RONALD STUNTZNER, SURVEYED THE NORTH LINE OF SECTION 22 AND SET THE NORTH 1/4 CORNER AND THE EAST 1/16 CORNER AS SHOWN IN SURVEY M73-7. IN 1981, PRIVATE SURVEYOR ROBERT WARD, SURVEYED THE EAST LINE OF SECTION 22 AND SET THE EAST 1/4 CORNER AS SHOWN IN SURVEY M89-58. IN 1983, PRIVATE SURVEYOR RONALD STUNTZNER, SURVEYED THE SOUTH LINE OF SECTION 22 AND SET THE SOUTH 1/4 CORNER AND THE WEST 1/16 CORNER AS SHOWN IN SURVEY M91-55.

NARRATIVE, THE PURPOSE OF THIS SURVEY IS TO POST AND BLAZE THE PROPERTY LINE BETWEEN INTERNATIONAL PAPER COMPANY AND CHAMPION INTERNATIONAL OWNERSHIP. ALSO TO POST AND BLAZE THE PROPERTY LINE BETWEEN CHAMPION INTERNATIONAL AND U.S. FOREST SERVICE OWNERSHIP. THE EAST 1/4 CORNER, THE EAST 1/16 CORNER ON THE NORTH LINE, THE NORTH 1/4 CORNER, THE WEST 1/4 CORNER, THE WITNESS CORNER TO THE LINE TREE, THE S.W. SECTION CORNER, THE WEST 1/16 CORNER ON THE SOUTH LINE AND THE SOUTH 1/4 CORNER WERE ALL FOUND IN THE FIELD AS SHOWN. A SERIES OF CLOSED MEANDER, WILD T-16 THEODOLITE AND DI-4L E.D.M., TRAVERSES WERE RUN BETWEEN THE ABOVE MENTIONED CONTROLLING CORNERS. SECTION 22 WAS THEN SUBDIVIDED IN ACCORDANCE TO THE B.L.M. MANUAL OF INSTRUCTION FOR THE SURVEY OF THE PUBLIC LANDS OF THE UNITED STATES. THE CENTER 1/4 CORNER, CORNER "C", WAS SET AT THE INTERSECTION OF THE N-S AND E-W CENTERLINES OF SECTION 22. THE S.W. 1/16 CORNER, CORNER "A", WAS SET AT THE INTERSECTION OF THE N-S & E-W CENTERLINES OF THE SW 1/4 OF SECTION 22. THE C.S. 1/16 CORNER, CORNER "B", WAS SET HALFWAY BETWEEN THE C. 1/4 CORNER AND THE S 1/4 CORNER AS SHOWN. THE C.E. 1/16 CORNER, CORNER "D", WAS SET HALFWAY BETWEEN THE C. 1/4 CORNER AND THE EAST 1/4 CORNER AS SHOWN. PROPERTY LINES WERE MARKED WITH RED PAINTED BLAZES, U.S.F.S. FIBERGLASS POSTS & DECALS, YELLOW INTERNATIONAL PAPER COMPANY BOUNDARY LINE DECALS ATTACHED TO 72" ALUMINUM POSTS, AND BURIED FLUORESCENT ORANGE MAGNETIC MARKERS. ALUMINUM POSTS AND BURIED MAGNETIC MARKERS ARE REFERENCED BY 4" x 6" ALUMINUM BOUNDARY LINE TAGS NAILED TO A NEARBY TREE. TAG NOTES BEARING AND DISTANCE FROM TREE TO ALUMINUM POST OR BURIED MAGNETIC MARKER.

S.W. CORNER SECTION 22

FD. 1981 ALUM. PIPE & CAP AS SET IN SURVEY M91-55
28" FIR STUMP, N72°E, 16.6' (NO MARKS), 1891 B.T.
22" DOWNED CEDAR, S26°E, 26.0' (NO MARKS), 1891 B.T.
26" HEMLOCK STUB, S45°W, 18.8' (NO MARKS), 1891 B.T.
30" HEMLOCK STUB, N54°W, 13.4' (NO MARKS), 1891 B.T.
10" FIR, N37°W, 8.4' (SCAR VIS.), 1981 B.T.
12" FIR, S27°W, 3.1' (SCAR VIS.), 1981 B.T.
13" FIR, N33°E, 11.3' (SCAR VIS.), 1981 B.T.
13" FIR, S54°E, 24.3' (SCRIBE VIS.), 1981 B.T.

WEST 1/4 CORNER SECTION 22

FD. 1964 DOUGLAS COUNTY BRASS CAP LYING ON THE GROUND. RESET BRASS CAP FROM 1964 COUNTY B.T.'S.
10" HEMLOCK SNAG, S85°E, 76.0' (SCRIBE VIS.), 1964 B.T.
14" HEMLOCK SNAG, S16°W, 46.8' (SCRIBE VIS.), 1964 B.T.
7" HEMLOCK, N63°E, 29.1' (SCRIBED "1/4 S22 B.T.")
10" FIR, N76°W, 36.6' (SCRIBED "1/4 S21 B.T.")

NORTH 1/4 CORNER SECTION 22

FD. 1978 BRASS CAP AS SET IN SURVEY M73-7
15" ALDER, S01°W, 37.2' (BARK SCRIBED), 1978 B.T.
36" FIR, N82°E, 67.0' (SCAR VIS.), 1978 B.T.
36" FIR STUMP, S37°E, 31.2' (SCAR VIS.), 1978 B.T.
48" FIR SNAG, N01°W, 12.0' (NO MARKS), 1978 B.T.

EAST 1/16 CORNER NORTH LINE SECTION 22

FD. 1978 BRASS CAP AS SET IN SURVEY M73-7.
11" ALDER, S31°W, 13.3' (BARK SCRIBED), 1978 B.T.
15" FIR, S64°E, 109.0' (SCAR VIS.), 1978 B.T.


EAST 1/4 CORNER SECTION 22

FD. 1981 ALUMINUM PIPE & CAP AS SET IN SURVEY M89-58
22" HEMLOCK, N52°E, 33.2' (SCRIBE VIS.), 1981 B.T.
22" HEMLOCK, N62°W, 30.8' (SCAR VIS.), 1981 B.T.

W 1/2 NE 1/4
77.17 ACRES

CHAMPION

EXAMINED AND ACCEPTED FOR THE U.S. FOREST SERVICE ON THIS 11th DAY OF DECEMBER, 1991. *Russell M. Zavor*, C.O.R., I CERTIFY THAT THIS SURVEY WAS PERFORMED AT THE REQUEST OF THE SIUSLAU NATIONAL FOREST SUPERVISOR. *Les Roberts* DATE

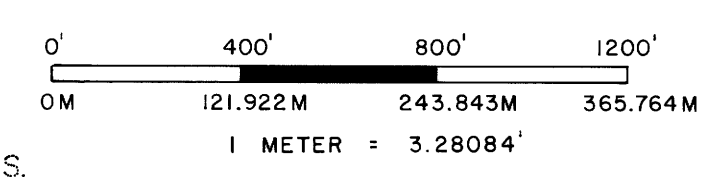

TOPOGRAPHIC FEATURES

ROAD = ----; RIDGE = - - - - -; CREEK = ~~~~~

LEGEND

- MONUMENTS FOUND AS NOTED
- MONUMENTS SET, 3/4" ALUMINUM RODS WITH 3/4" ALUMINUM CAPS OR 2 1/2" ALUMINUM PIPE AND CAP. CAPS STAMPED S-T-R, DATE AND P.L.S. 1039.
- BLAZES AND POSTED THIS SURVEY.
- () DATA OF RECORD
- BASIS OF BEARING, WEST 1/2 OF SOUTH LINE SECTION 22 FROM C.S. M91-55 (S.W. CORNER TO SOUTH 1/4 CORNER)
- DISTANCES TO B.T.'S ARE CENTER MEASURE
- (M.M.) INDICATES LOCATION OF BURIED MAGNETIC MARKERS. MARKERS ARE FLUORESCENT ORANGE IN COLOR AND ARE BURIED, 12" TO 18" DEEP, ALONG LINE AS SHOWN.
- ALL NEW B.T.'S ARE SCRIBED AND HAVE AN ALUMINUM WASHER STAMPED "P.L.S. 1039" NAILED TO LOWER BLAZE. SCRIBED BLAZES ARE PAINTED RED.
- NEW B.T.'S HAVE A 6" SPIKE DRIVEN INTO THE CENTER OF THE TREE TO SERVE AS A CHAINING POINT FOR MEASURED DISTANCES.

STATEMENT, I, LES ROBERTS, A REGISTERED LAND SURVEYOR IN THE STATE OF OREGON, HEREBY CERTIFY THAT THIS PLAT AND THE NOTES HEREON ARE A CORRECT REPRESENTATION OF THE SURVEY I PERFORMED DURING THE MONTHS OF MAY, JUNE AND JULY OF 1991. SAID SURVEY WAS DONE IN ACCORDANCE WITH THE STATUTES OF THE STATE OF OREGON AND ACCORDING TO THE ARTICLES OF MY CONTRACT WITH INTERNATIONAL PAPER COMPANY & THE U.S. FOREST SERVICE.

LOCATION OF BURIED MAGNETIC MARKERS					
W 1/16	0'	NORTH (AL. POST)	SW 1/4 22-25	403'	NORTH (M.M. & AL. POST)
SW 1/4 22-1	58'	NORTH (M.M. & AL. POST)	SW 1/4 22-26	606'	NORTH (M.M. & AL. POST)
SW 1/4 22-2	98'	NORTH (M.M. & AL. POST)	SW 1/4 22-27	896'	NORTH (M.M. & AL. POST)
SW 1/4 22-3	275'	NORTH (M.M. & AL. POST)	SW 1/4 22-28	935'	NORTH (M.M.)
SW 1/4 22-4	540'	NORTH (M.M. & AL. POST)	SW 1/4 22-29	980'	NORTH (M.M. & AL. POST)
SW 1/4 22-5	757'	NORTH (M.M. & AL. POST)	SW 1/4 22-30	1181'	NORTH (M.M. & AL. POST)
SW 1/4 22-6	850'	NORTH (M.M.)	C. 1/4 COR.	1308'	NORTH (M.M. & AL. POST)
SW 1/4 22-7	944'	NORTH (M.M. & AL. POST)	E-W 22-1	42'	EAST (M.M.)
SW 1/4 22-8	998'	NORTH (M.M.)	E-W 22-2	235'	EAST (M.M. & AL. POST)
SW 1/4 22-9	1089'	NORTH (M.M. & AL. POST)	E-W 22-3	390'	EAST (M.M.)
SW 1/4 22-10	1139'	NORTH (M.M.)	E-W 22-4	519'	EAST (M.M. & AL. POST)
SW 1/4 22-11	1205'	NORTH (M.M. & AL. POST)	E-W 22-5	595'	EAST (M.M.)
SW 1/16 COR.	1322'	NORTH (M.M. & AL. POST)	E-W 22-6	777'	EAST (M.M. & AL. POST)
SW 1/4 22-13	164'	EAST (M.M. & AL. POST)	E-W 22-7	960'	EAST (M.M. & AL. POST)
SW 1/4 22-14	447'	EAST (M.M. & AL. POST)	E-W 22-8	1077'	EAST (M.M. & AL. POST)
SW 1/4 22-15	494'	EAST (M.M.)	E-W 22-9	1250'	EAST (M.M. & AL. POST)
SW 1/4 22-16	694'	EAST (M.M. & AL. POST)	C.E. 1/16 COR	1312'	EAST (M.M. & AL. POST)
SW 1/4 22-17	818'	EAST (M.M. & AL. POST)	E-W 22-10	1457'	EAST (M.M. & AL. POST)
SW 1/4 22-18	1033'	EAST (M.M.)	E-W 22-11	1556'	EAST (M.M. & AL. POST)
SW 1/4 22-19	1078'	EAST (M.M. & AL. POST)	E-W 22-12	1607'	EAST (M.M.)
SW 1/4 22-20	1269'	EAST (M.M.)	E-W 22-13	1651'	EAST (M.M. & AL. POST)
C.S. 1/16 COR	1312'	EAST (M.M. & AL. POST)	E-W 22-14	1920'	EAST (M.M. & AL. POST)
SW 1/4 22-22	138'	NORTH (M.M.)	E-W 22-15	2110'	EAST (M.M. & AL. POST)
SW 1/4 22-23	227'	NORTH (M.M. & AL. POST)	E-W 22-16	2343'	EAST (M.M. & AL. POST)
SW 1/4 22-24	347'	NORTH (M.M.)	E. 1/4 COR.	2625'	EAST (AL. POST)

"A" S.W. 1/16 CORNER SECTION 22

SET 3/4" x 24" ALUM. ROD WITH 3/4" ALUM. CAP.
(BURIED PURPLE M.M. UNDER 24" ALUMINUM ROD)
9" ALDER, N35°E, 36.8' (BARK SCRIBED "SW 1/16 S22 B.T.")
11" ALDER, N78°W, 10.5' (BARK SCRIBED "SW 1/16 S22 B.T.")

"B" C.S. 1/16 CORNER SECTION 22

SET 3/4" x 24" ALUM. ROD WITH 3/4" ALUM. CAP.
(BURIED PURPLE M.M. UNDER 24" ALUMINUM ROD)
8" ALDER, S34°E, 17.5' (BARK SCRIBED "CS 1/16 S22 BT")
36" CEDAR, N53°W, 17.0' (SCRIBED "CS 1/16 S22 BT")

"C" CENTER 1/4 CORNER SECTION 22


SET 3/4" x 12" ALUM. ROD WITH 3/4" CAP IN ROCK CREVICE
(BURIED PURPLE M.M. UNDER 12" ALUMINUM ROD)
9" ALDER, S04°W, 30.4' (BARK SCRIBED "C 1/4 S22 BT")
18" ALDER, N45°E, 66.8' (BARK SCRIBED "C 1/4 S22 BT")
11" ALDER, N08°W, 48.2' (BARK SCRIBED "C 1/4 S22 BT")
18" ALDER, S66°E, 64.9' (BARK SCRIBED "C 1/4 S22 BT")

"D" C.E. 1/16 CORNER SECTION 22

SET 2 1/2" x 30" U.S. FOREST SERVICE ALUM. PIPE & CAP
(BURIED PURPLE M.M. UNDER 30" ALUMINUM PIPE)
9" ALDER, N10°W, 77.8' (BARK SCRIBED "CE 1/16 S22 BT")
10" ALDER, S70°W, 52.8' (BARK SCRIBED "CE 1/16 S22 BT")

SOUTH 1/4 CORNER SECTION 22

FD. 1981 ALUM. PIPE & CAP AS SET IN SURVEY M91-55
14" FIR, N52°E, 33.6' (SCAR VIS.), 1981 B.T.
15" ALDER, S73°W, 24.7' (BARK SCRIBED), 1981 B.T.
46" FIR SNAG, S21°E, 25.9' (SCRIBE VIS.), 1981 B.T.

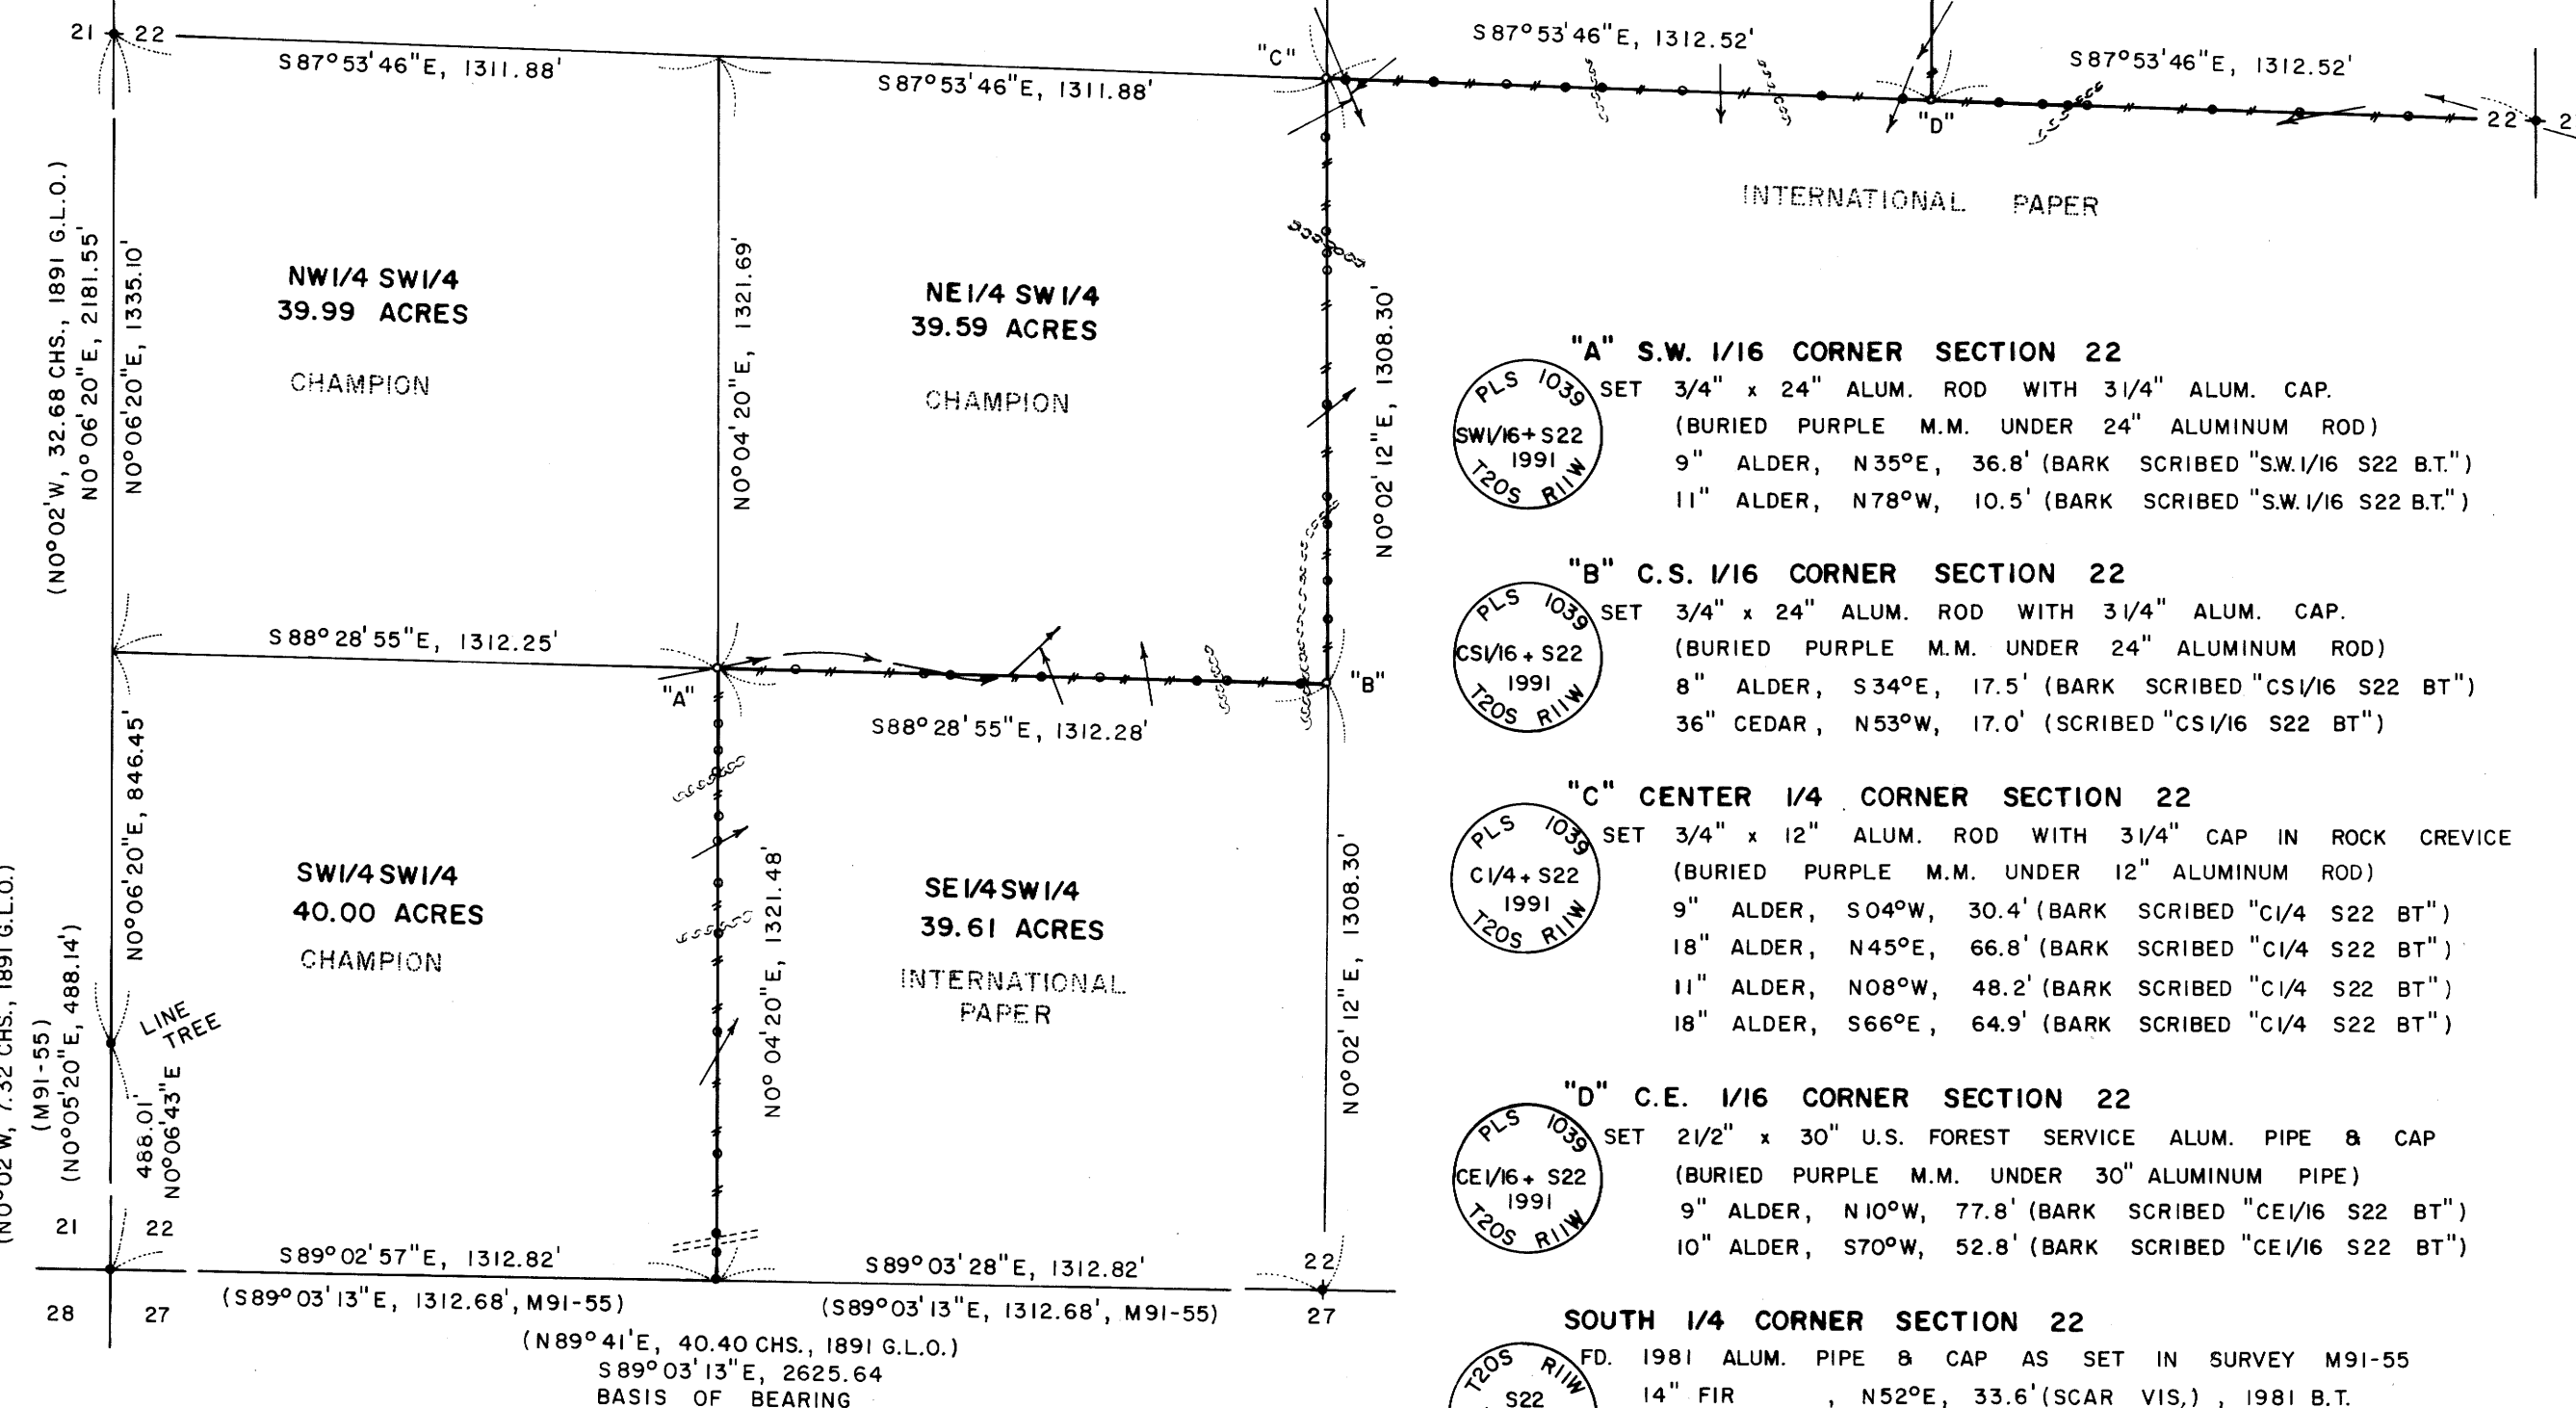

T20S R11W
W.C.B.T.
S21 S22
1981
P.L.S. 1039

T20S R11W
S21 S22
W 1/16 S22
1981
P.L.S. 1039

T20S R11W
S15 S22
P. 1978
P.L.S. 1039

T20S R11W
S15 S22
P. 1978
P.L.S. 1039

T20S R11W
S22 S23
1981
P.L.S. 1039

T20S R11W
W.C.B.T.
S21 S22
1981
P.L.S. 1039

T20S R11W
S21 S22
P.L.S. 1039

M114-29

FILED

JAN 15 1992

OREGON CORNER RESTORATION FORM

Section 22 Township 20S Range 11WCounty Douglas Date 05-22-91COUNTY SURVEYOR
DOUGLAS COUNTY, ORE.

CORNER DESIGNATION

S.W. Corner
Section 22


☒ Condition Report Only
☐ Not Found
☐ Renewed
☐ Unrecorded
☐ Surveyed In
☐ Referenced Out

Previous Renewals/Surveys, etc. Original G.L.O. Survey by William Thiel
in 1891-1892. Survey M91-55 by Ronald Stuntzner dated October-November
1981.

Monument(s) & Accessories Found: (Condition and Source)

Found 1981 Aluminum Pipe and Cap as set in Survey M91-55
28" Fir Stump, N72E, 16.6' (No Marks), 1891 BT. Rec. N65E, 16.5'
22" Downed Cedar, S26E, 26.0' (No Marks), 1891 BT. Rec. S68 $\frac{1}{2}$ E, 20.5'
26" ^{HEM.} Fir Stub, S45W, 18.8' (No Marks), 1891 BT. Rec. S53W, 15.2'
30" Hemlock Stub, N54W, 13.4' (No Marks), 1891 BT. Rec. N53W, 9.2'
10" Fir, N37W, 8.4' (Scar Vis.), 1981 BT. Rec. N38W, 8.7'
12" Fir, S27W, 3.1' (Scar Vis.), 1981 BT. Rec. S27 $\frac{1}{2}$ W, 3.3'
13" Fir, N33E, 11.3' (Scar Vis.), 1981 BT. Rec. N32E, 11.4'
13" Fir, S54E, 24.3' (Scribe Vis.), 1981 BT. Rec. S55E, 24.3'

Monument Detail

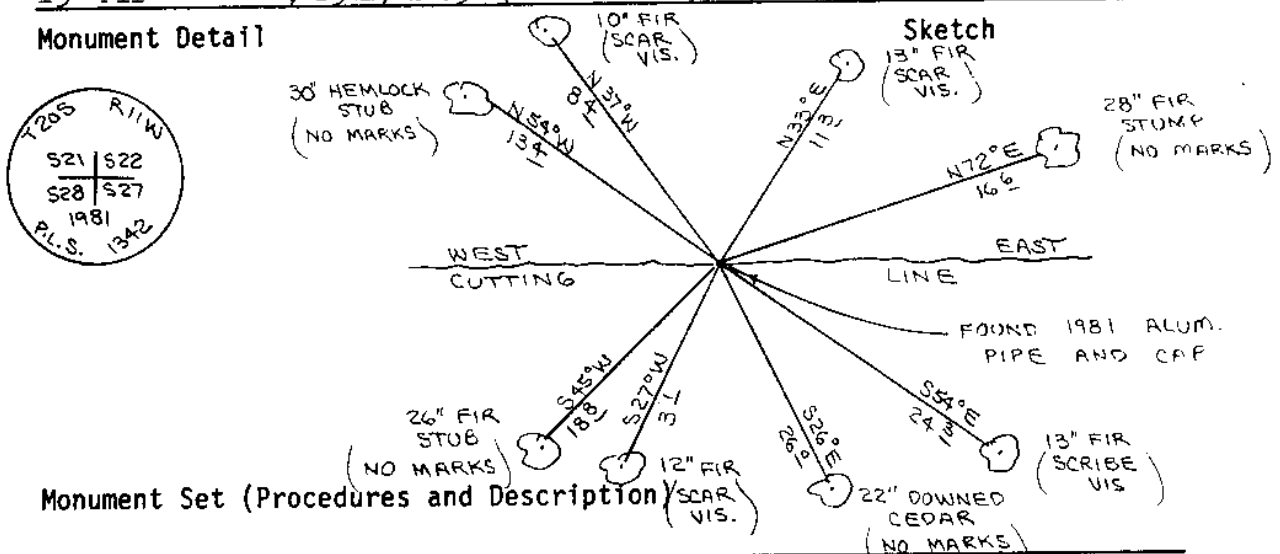

Monument Set (Procedures and Description)


New Accessories

Painted all bearing trees red.

Location & Comments

Corner lies on West slope Compass Declination 19°
at South edge of clear cut Firm/Agency Roberts
unit. Cutting line runs Surveying Inc.
East-West Address 29 West 29th St.
Eugene, Oregon 97405
Party Chief Ted Baker
Notes
Witness Harvey Christensen

Surveyor's Seal

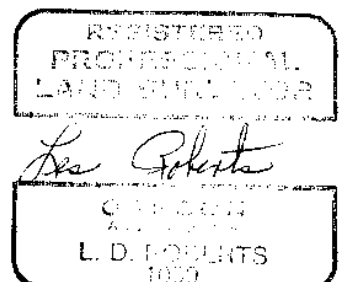C.S. File No. 63/138-2A

M 114-29

FILED

JH

OREGON CORNER RESTORATION FORM

Section 22 Township 20S Range 11W

JAN 15 1992

County Douglas Date 05-22-91COUNTY SURVEYOR
DOUGLAS COUNTY, ORE.

CORNER DESIGNATION

South 1/4 Corner
Section 22
☒ Condition Report Only
☐ Not Found
☐ Renewed
☐ Unrecorded
☐ Surveyed In
☐ Referenced Out

Previous Renewals/Surveys, etc. Original G.L.O. Survey by William Thiel
in 1891-1892. Survey M91-55 by Ronald Stuntzner dated October-November
1981.

Monument(s) & Accessories Found: (Condition and Source)


Found 1981 Aluminum Pipe and Cap as set in Survey M91-55.

14" Fir, N52E, 33.6' (Scar Vis.), 1981 BT. Record N51E, 33.9'

15" Alder, S73W, 24.7' (Bark Scribed), 1981 BT. Record S72W, 24.0'

46" Fir Snag, S21E, 25.9' (Scribe Vis.), 1981 BT. Record S23E, 25.4'

Monument Detail

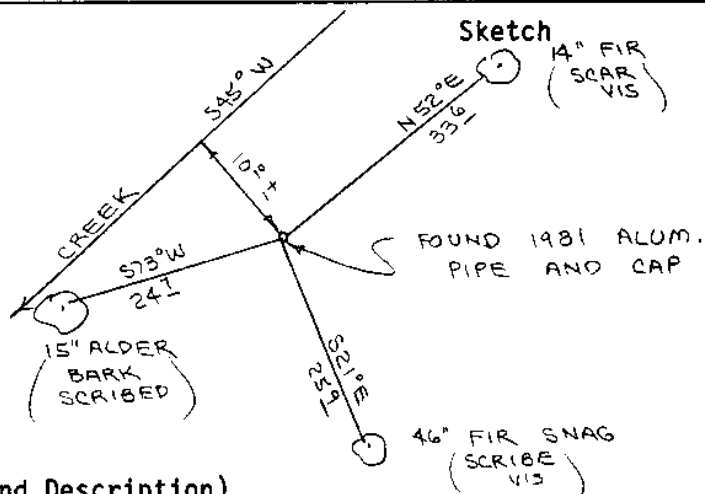

Monument Set (Procedures and Description)

New Accessories

Painted all bearing trees red.

Location & Comments

Corner lies on West slope Compass Declination 19°on South edge of creek. Firm/Agency Roberts


Creek bears S45W. Surveying, Inc.

Address 29 West 29th St.Eugene, Oregon 97405Party Chief Ted Baker

Notes

Witness Harvey Christensen

Surveyor's Seal

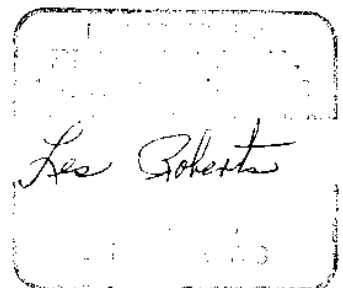C.S. File No. 63/138-28

M 114-29

FILED

v8

OREGON CORNER RESTORATION FORM

JAN 15 1992

Section 22 Township 20S Range 11WCOUNTY SURVEYOR
DOUGLAS COUNTY, ORE.County Douglas Date 06-28-91

CORNER DESIGNATION

Witness Corner to Line Tree
West Line Section 22.


- ☒ Condition Report Only
☐ Not Found
☐ Renewed
☐ Unrecorded
☐ Surveyed In
☐ Referenced Out

Previous Renewals/Surveys, etc. Original G.L.O. Survey by William Thiel
in 1891-1892. Survey M91-55 by Ronald Stuntzner dated October-November
1981.

Monument(s) & Accessories Found: (Condition and Source)

Found 1981 Aluminum Pipe and Cap set in Survey M91-55. 50" Line Tree
Stump bears N 0°06'43" E, 12.00'
16" Hemlock, S42W, 25.7' (Scribe Vis.), 1981 BT. Record S41W, 25.8'
24" Hemlock, N12W, 50.4' (Scribe Vis.), 1981 BT. Record N13W, 51.3'

Monument Detail

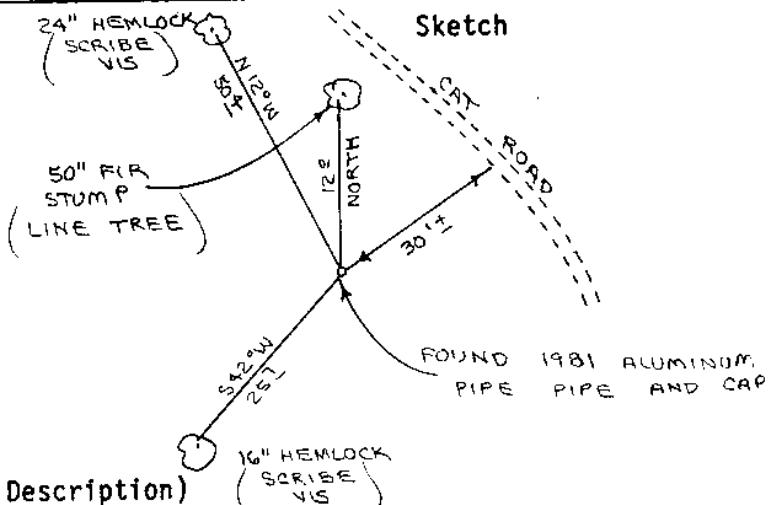

Monument Set (Procedures and Description)


New Accessories

Painted all bearing trees red.

Location & Comments

Corner lies on S.W. slope Compass Declination 19°
about 30 feet West of cat Firm/Agency Roberts
road. Cat road bears NW and Surveying Inc.
SE. Address 29 West 29th ST.
Eugene, Oregon 97405
Party Chief Ted Baker
Notes
Witness Rick Jones

Surveyor's Seal

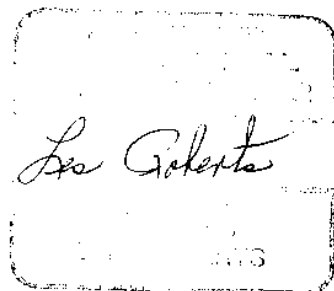C.S. File No. 63/138-2C

M114-29

FILED

JAN 15 1992

OREGON CORNER RESTORATION FORM

Section 22 Township 20S Range 11WCounty Douglas Date 06-27-91COUNTY SURVEYOR
DOUGLAS COUNTY, ORE.

CORNER DESIGNATION

West 1/4 Corner
Section 22.

☐ Condition Report Only
☐ Not Found
☒ Renewed
☐ Unrecorded
☐ Surveyed In
☐ Referenced Out

Previous Renewals/Surveys, etc. Original G.L.O. Survey by William Thiel
in 1891-1892. Corner renewal field notes C.S. 53/66.

Monument(s) & Accessories Found: (Condition and Source)


Found 1964 Douglas County Brass cap lying on the ground. Reset brass cap
from 1964 Douglas County bearing trees.

10" Hemlock Snag, S85E, 76.0' (Scribe Vis.), 1960 BT. Record S85E, 76.0

14" Hemlock Snag, S16W, 46.8' (Scribe Vis.), 1960 BT. Record S16W, 46.8'

Monument Detail

Sketch

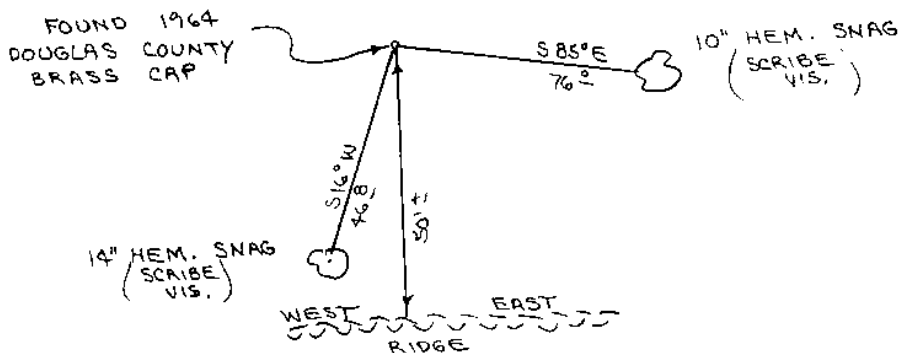

Monument Set (Procedures and Description)

New Accessories

7" Hemlock, N6E, 29.1' (Scribed 1/4 S22 BT), Painted Red
10" Fir, N76W, 36.6' (Scribed 1/4 S21 BT), Painted Red
Painted all bearing trees red and set a 72" aluminum post, with a land
survey sign attached to, beside brass cap.

Location & Comments

Corner lies on steep North Compass Declination 19°
slope about 50 feet North Firm/Agency Roberts
of East-West ridge. Surveying Inc.

Address 29 West 29th St.


Eugene, Oregon 97405

Party Chief Ted Baker

Notes

Witness Rick Jones

Surveyor's Seal

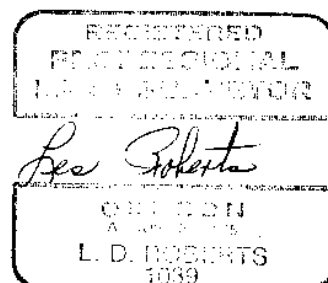C.S. File No. 63/128-2

M114-29

FILED

JAN 15 1992

OREGON CORNER RESTORATION FORM

Section 22 Township 20S Range 11WCounty Douglas Date 07-15-91COUNTY SURVEYOR
DOUGLAS COUNTY, ORE.

CORNER DESIGNATION

S.W. 1/16 Corner

Section 22


☐ Condition Report Only
☐ Not Found
☐ Renewed
☐ Unrecorded
☒ Surveyed In
☐ Referenced Out

Previous Renewals/Surveys, etc. No previous surveys or renewals

Monument(s) & Accessories Found: (Condition and Source)

None

Monument Detail

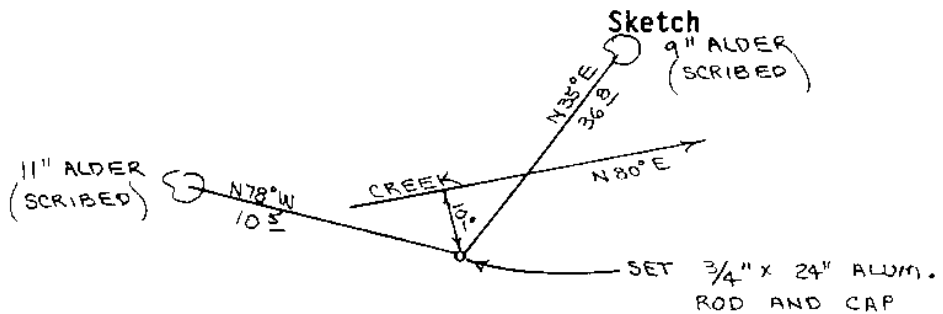

Monument Set (Procedures and Description)

Set 3/4" x 24" aluminum rod with a 3/4" aluminum cap. Buried purple magnetic marker under 24" aluminum rod. See filed survey for surveying procedures.

New Accessories

9" Alder, N35E, 36.8', Bark Scribed "SW1/16 S22 BT", Painted red.

11" Alder, N78W, 10.5', Bark Scribed "SW1/16 S22 BT", Painted red.

Set a 72" aluminum post, with a land survey monument sign attached to, beside aluminum rod.

Location & Comments

Corner lies on South edge of small creek. Creek bears N80E.

Compass Declination 19°


Firm/Agency Roberts Surveying Inc.

Address 29 West 29th St.Eugene, Oregon 97405Party Chief Ted Baker

Notes

Witness Rick Jones

Surveyor's Seal

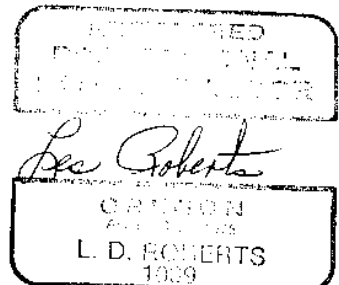C.S. File No. 63/138-2

M114-29

FILED

JH

OREGON CORNER RESTORATION FORM

JAN 15 1992

Section 22 Township 20S Range 11WCounty Douglas Date 07-15-91COUNTY SURVEYOR
DOUGLAS COUNTY, ORE.

CORNER DESIGNATION

C.S. 1/16 Corner
Section 22

☐ Condition Report Only
☐ Not Found
☐ Renewed
☐ Unrecorded
☒ Surveyed In
☐ Referenced Out


Previous Renewals/Surveys, etc. No previous surveys or renewals

Monument(s) & Accessories Found: (Condition and Source)

None

Monument Detail

Sketch

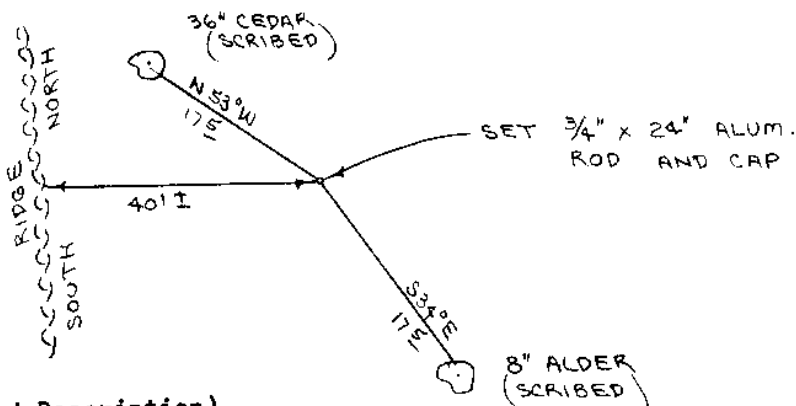

Monument Set (Procedures and Description)

Set $\frac{3}{4}$ " x 24" aluminum rod with a $\frac{3}{4}$ " aluminum cap. Buried purple magnetic marker under 24" aluminum rod. See filed survey for surveying procedures.

New Accessories

8" Alder, S34E, 17.5'. Bark Scribed "CS1/16 S22 BT". Painted red.

36" Cedar, N53W, 17.0'. Scribed "CS1/16 S22 BT". Painted red.

Set a 72" aluminum post, with a land survey monument sign attached to, beside aluminum rod.

Location & Comments

Corner lies on East slope Compass Declination 19°about 40 feet East of ridge. Firm/Agency Roberts


Ridge bears North-South. Surveying Inc.

Address 29 West 29th St.Eugene, Oregon 97405Party Chief Ted Baker

Notes

Witness Rick Jones

Surveyor's Seal

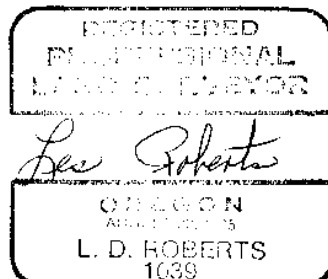C.S. File No. 63/139-2

M114-29

FILED

28

JAN 15 1992

OREGON CORNER RESTORATION FORM

Section 22 Township 20S Range 11WCounty Douglas Date 07-16-91COUNTY SURVEYOR
DOUGLAS COUNTY, ORE.

CORNER DESIGNATION

Center 1/4 Corner
Section 22


☐ Condition Report Only
☐ Not Found
☐ Renewed
☐ Unrecorded
☒ Surveyed In
☐ Referenced Out

Previous Renewals/Surveys, etc. No previous surveys or renewals

Monument(s) & Accessories Found: (Condition and Source)

None

Monument Detail

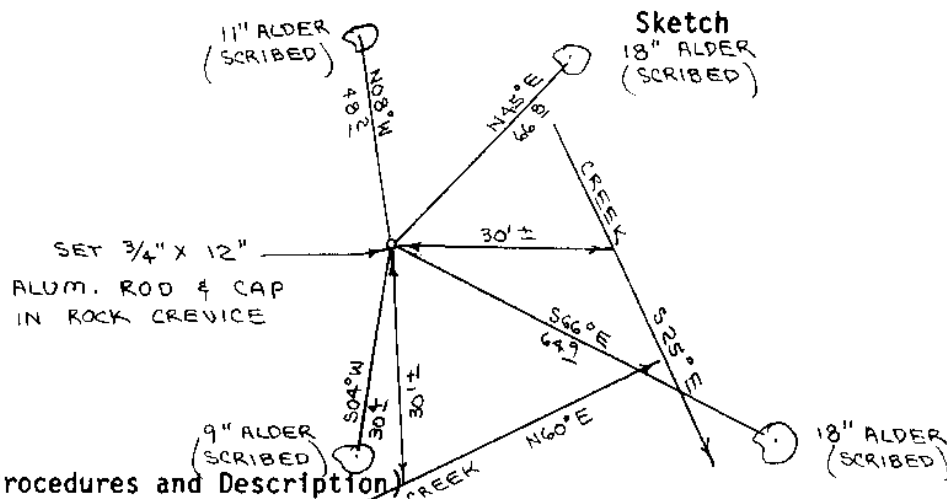

Monument Set (Procedures and Description)

Set 3/4" x 12" aluminum rod with a 3/4" aluminum cap. Buried purple magnetic marker under 12" Aluminum rod. See filed survey for surveying procedures.

New Accessories

9" Alder, S04W, 30.4', Bark Scribed "C1/4 S22 BT", Painted red.

11" Alder, N08W, 48.2', Bark Scribed "C1/4 S22 BT", Painted red.

18" Alder, N45E, 66.8', Bark Scribed "C1/4 S22 BT", Painted red.


18" Alder, S66E, 64.9', Bark Scribed "C1/4 S22 BT", Painted red.

Set a 72" aluminum post, with a land survey monument sign attached to, beside aluminum rod.

Location & Comments

Surveyor's Seal

Corner lies on East slope and Westerly of 2 small creeks.
 Compass Declination 19°
 Firm/Agency Roberts Surveying Inc.
 Address 29 West 29th St.
Eugene, Oregon 97405
 Party Chief Ted Baker
 Notes _____
 Witness Rick Jones

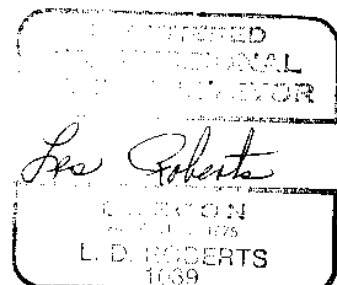C.S. File No. 63/138-2

6

FILED

28

JAN 15 1992

OREGON CORNER RESTORATION FORM

Section 22 Township 20S Range 11WCounty Douglas Date 07-16-91COUNTY SURVEYOR
DOUGLAS COUNTY, ORE.

CORNER DESIGNATION

C.E. 1/16 Corner
Section 22.


☐ Condition Report Only
☐ Not Found
☐ Renewed
☐ Unrecorded
☒ Surveyed In
☐ Referenced Out

Previous Renewals/Surveys, etc. No previous surveys or renewals

Monument(s) & Accessories Found: (Condition and Source)

None

Monument Detail

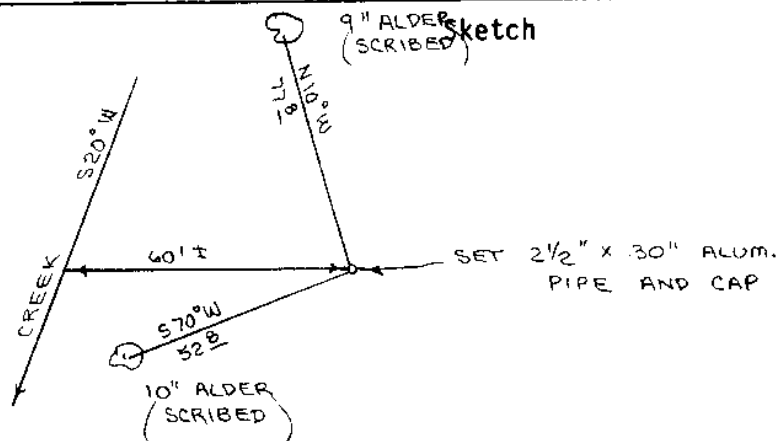

Monument Set (Procedures and Description)

Set $2\frac{1}{2}$ " x 30" U.S. Forest Service Aluminum Pipe and Cap. Buried purple magnetic marker under 30" aluminum pipe. See filed survey for surveying procedures.


New Accessories

9" Alder, N10W, 77.8', Bark Scribed "CE1/16 S22 BT", Painted red.
 10" Alder, S70W, 52.8', Bark Scribed "CE1/16 S22 BT", Painted red.
 Set a 72" aluminum post, with a land survey monument sign attached to, beside aluminum pipe.

Location & Comments

Corner lies on a N.W. slope about 60 feet East of a small creek. Creek bears S20W.
 Compass Declination 19°
 Firm/Agency Roberts Surveying Inc.
 Address 29 West 29th St.
Eugene, Oregon 97405
 Party Chief Ted Baker
 Notes _____
 Witness Rick Jones

Surveyor's Seal

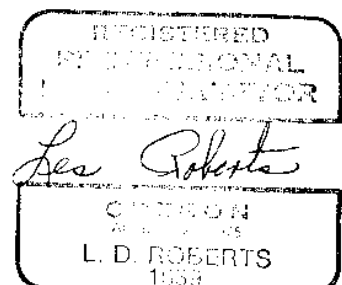O.S. File No. 63/133-2H

M 114-29

FILED

JAN 15 1992

OREGON CORNER RESTORATION FORM

Section 22 Township 20S Range 11WCounty Douglas Date 6-27-91COUNTY SURVEYOR
DOUGLAS COUNTY, ORE.

CORNER DESIGNATION

North $\frac{1}{4}$ Corner
Section 22


☒ Condition Report Only
☐ Not Found
☐ Renewed
☐ Unrecorded
☐ Surveyed In
☐ Referenced Out

Previous Renewals/Surveys, etc. Original G.L.O. Survey by William Thiel
in 1891-1892. Survey M73-7 by Ronald Stuntzner dated August 28, 1978.

Monument(s) & Accessories Found: (Condition and Source)

Found 1978 Brass Cap set in sandstone as noted in survey M73-7.
15" Alder, S01W, 37.2' (Bark Scribed), 1978 B.T. Rec. S02W, 37.67'
36" Fir, N82E, 67.0' (Scar Vis.), 1978 B.T. Rec. N84E, 67.22'
36" Fir Stump, S37E, 31.2' (Scar Vis.), 1978 B.T. Rec. S37E, 31.95'
48" Fir Snag N01W, 12.0' (No Marks), 1978 B.T. Rec. North, 12.2'

Monument Detail

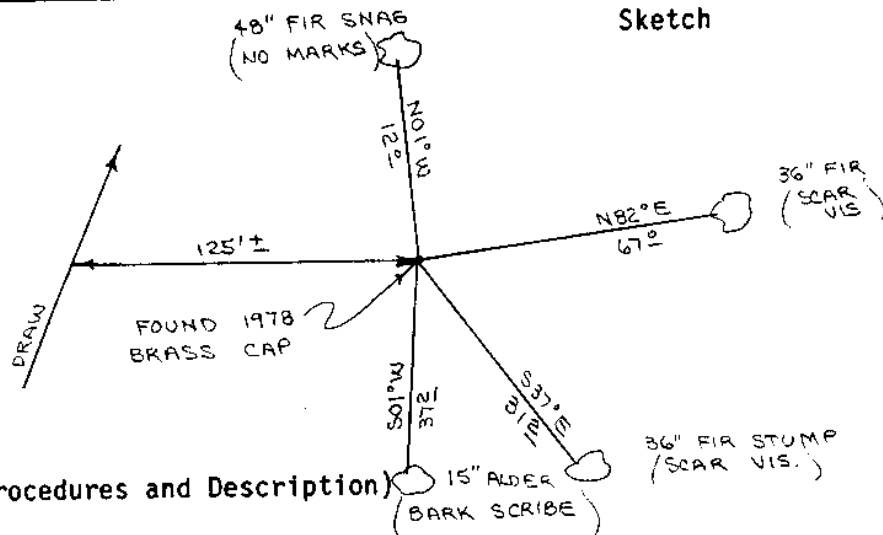

Monument Set (Procedures and Description)


New Accessories

Painted all bearing trees red.

Location & Comments

Corner lies on North slope Compass Declination 19°
about 125' East of draw. Firm/Agency Roberts
Draw bears N20E. Surveying Inc.
Address 29 West 29th St.
Eugene, Oregon 97405
Party Chief Ted Baker
Notes
Witness Rick Jones

Surveyor's Seal

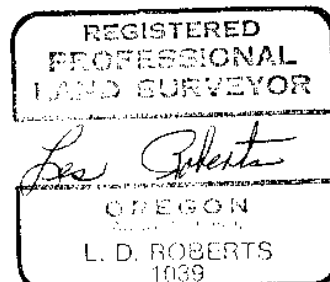C.S. File No. 63/138-2

M114-29

FILED

JR

JAN 15 1992

OREGON CORNER RESTORATION FORM

Section 22 Township 20S Range 11W

COUNTY SURVEYOR
DOUGLAS COUNTY, ORE.

County Douglas Date 05-30-91

CORNER DESIGNATION

East 1/16 corner
North line Section 22

- ☒ Condition Report Only
☐ Not Found
☐ Renewed
☐ Unrecorded
☐ Surveyed In
☐ Referenced Out


Previous Renewals/Surveys, etc. Original C.L.O. Survey by William Thiel
in 1891-1892. Survey M73-7 by Ronald Stuntzner dated August 8, 1978.

Monument(s) & Accessories Found: (Condition and Source)

Found 1978 Brass Cap as set in survey M73-7.
11" Alder, S31W, 13.3' (Bark Scribed), 1978 B.T. Record S28W, 13.0'
15" Fir, S64E, 109.0' (Scar Vis.), 1978 B.T. Record S64E, 109.26'

Monument Detail

Sketch

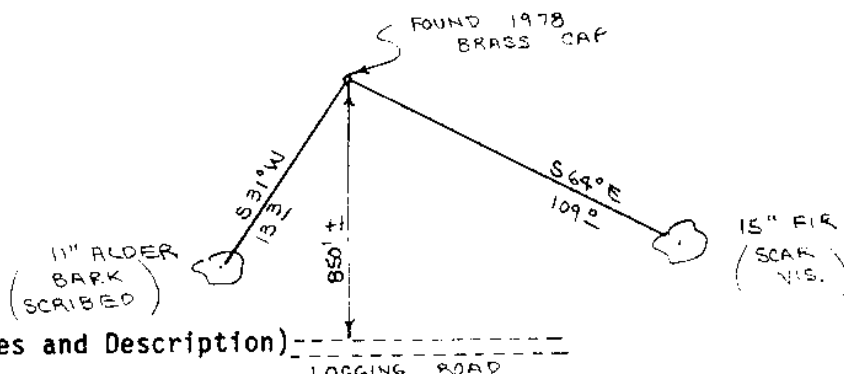

Monument Set (Procedures and Description)

New Accessories

Painted all bearing trees red.

Location & Comments

Corner lies on N.E. slope about 850 feet north of road Compass Declination 19°
Firm/Agency Roberts

Surveying Inc.

Address 29 West 29th St.


Eugene, Oregon 97504

Party Chief Ted Baker

Notes

Witness Harvey Christensen

Surveyor's Seal

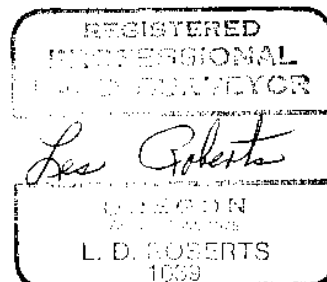

C.S. File No. 63/138-2
J

FILED

JAN 15 1992

M114-29

OREGON CORNER RESTORATION FORM

COUNTY SURVEYOR
DOUGLAS COUNTY, ORE.Section 22 Township 20S Range 11WCounty Douglas Date 07-11-91

CORNER DESIGNATION

East 1/4 Corner
Section 22

- ☒ Condition Report Only
☐ Not Found
☐ Renewed
☐ Unrecorded
☐ Surveyed In
☐ Referenced Out

Previous Renewals/Surveys, etc. Original G.L.O. Survey by William Thiel
in 1891-1892. Survey M89-58 by Robert Ward dated May-September 1981.


Monument(s) & Accessories Found: (Condition and Source)

Found 1981 Aluminum Pipe and Cap as set in survey M89-58.

22" Hemlock, N52E, 33.2' (Scribe Vis.), 1981 BT. Record N52E, 33.1'

22" Hemlock, N62W, 30.8' (Scar Vis.), 1981 BT. Record N62W, 29.0'

Monument Detail

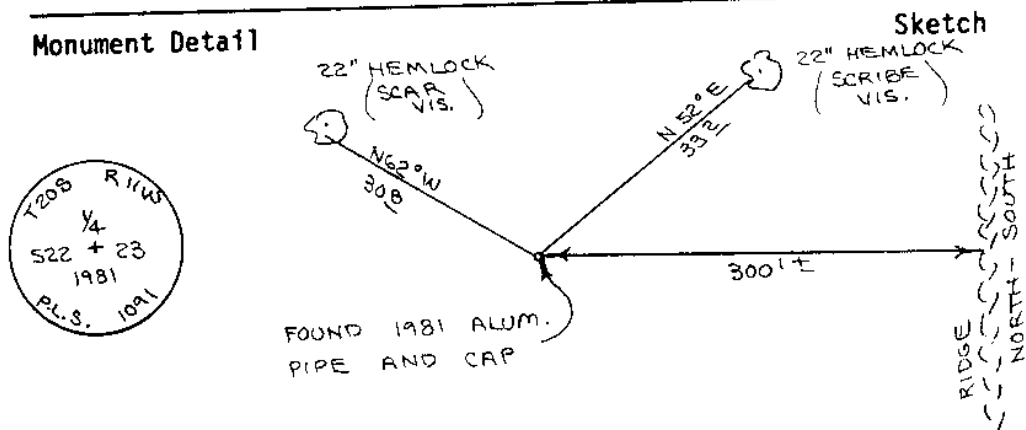

Monument Set (Procedures and Description)

New Accessories

Painted all bearing trees red.

Location & Comments

Corner lies on S.W. slope Compass Declination 19°about 300' West of ridge. Firm/Agency Roberts


Ridge bears North-South. Surveying Inc.

Address 29 West 29th St.Eugene, Oregon 97405Party Chief Ted Baker

Notes

Witness Rick Jones

Surveyor's Seal

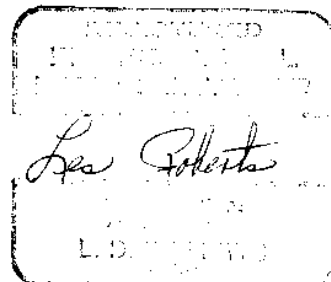C.S. File No. 63/138-2
K

M114-29

FILED

OREGON CORNER RESTORATION FORM

JAN 15 1992

Section 22 Township 20S Range 11WCounty Douglas Date 07-01-91COUNTY SURVEYOR
DOUGLAS COUNTY, ORE.

CORNER DESIGNATION

West 1/16 Corner
South Line Section 22.


☒ Condition Report Only
☐ Not Found
☐ Renewed
☐ Unrecorded
☐ Surveyed In
☐ Referenced Out

Previous Renewals/Surveys, etc. Original G.L.O. Survey by William Thiel
in 1891-1892. Survey M91-55 by Ronald Stuntzner dated October-November
1981.

Monument(s) & Accessories Found: (Condition and Source)

Found 1981 Aluminum Pipe and Cap as set in Survey M91-55.
12" Hemlock, S25E, 35.0' (Scar Vis.), 1981 BT. Record S25E, 35.2'
15" Hemlock, North, 53.4' (Scar Vis.), 1981 BT. Record N01W, 53.6'

Monument Detail

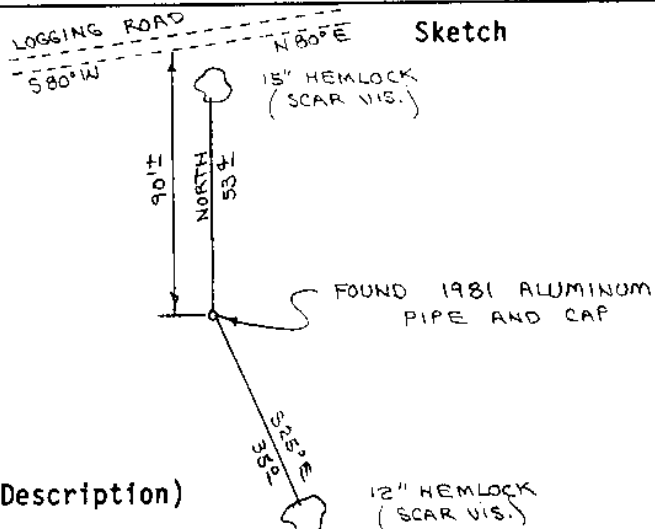

Monument Set (Procedures and Description)

New Accessories

Painted all bearing trees red

Location & Comments

Corner lies on North slope Compass Declination 19°
about 90 feet South of Firm/Agency Roberts
road. Road bears N80E and Surveying Inc.
S80W. Address 29 West 29th St.


Eugene, Oregon 97405

Party Chief Ted Baker

Notes

Witness Rick Jones

Surveyor's Seal

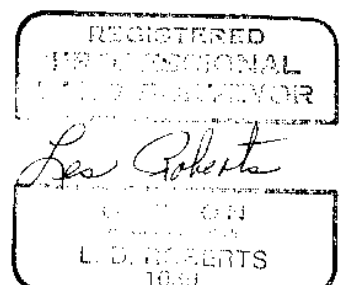C.S. File No. 63/138-2