


NARRATIVE:

USED PREVIOUS SURVEY AND CONTROL TO ESTABLISH TWO CORNERS SHOWN. FLAGGED LINE BETWEEN CORNERS  
FIELD CREW: M. HOLT, R. McCALLESTER  
EQUIP: SET 4 TOTAL STATION  
DRAFTING: M. RADCLIFFE  
OFFICE: D. BENTZ  
REF. MAP: M107-48

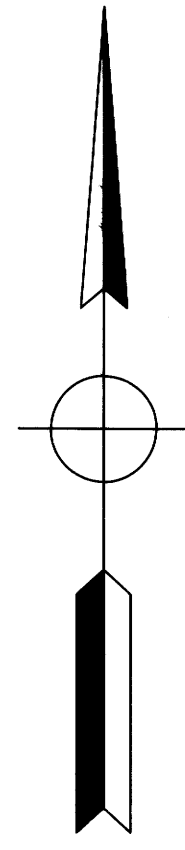

LEGEND:

- SET 5/8" x 30" I.R. W/CAP STAMPED "i.e. ENGINEERING"

REGISTERED OREGON LAND SURVEYOR		SURVEY LYING IN THE NW 1/4 OF SEC. 22, T28S, R4W, W.M., DOUGLAS COUNTY, OREGON	
 JULY 12, 1968 DONALD A. BENTZ 839		SURVEYED FOR: PHILIP R. OSBORNE 813 CORTEZ ST. COSTA MESA, CA. 92626	SURVEYED BY: i.e. ENGINEERING 1205 S.E. COURT ROSEBURG, OR. 97470 (503) 673-0166
SCALE: 1" = 200'	DATE: AUG, 1992	PAGE: 1 OF 1	

COUNTY SURVEYORS FILE DATA  
DO NOT REMOVE FROM OFFICE