

NORTH 1/4 CORNER SECTION 15

FD. 1954 G.L.O. BRASS CAP AND 72" STEEL POST
60" DOWNED CEDAR, S22°W, 47.0' (SCAR VIS.), 1954 B.T.
66" CEDAR, N56°E, 24.6' (SCAR VIS.), 1954 B.T.
SET 14" FIR, S23°E, 35.2' (SCRIBED/PAINTED RED)

N.E. CORNER SECTION 15

FD. 1954 G.L.O. BRASS CAP
20" FIR STUMP, S30°W, 27.5' (SCAR VIS.), 1954 B.T.
22" FIR STUMP, S32°E, 4.5' (SCAR VIS.), 1954 B.T.
40" FIR, N43°E, 18.0' (SCAR VIS.), 1967 B.T.
SET 8" ALDER, N89°E, 23.6' (SCRIBED/PAINTED RED)
8" ALDER, WEST, 22.4' (SCRIBED/PAINTED RED)
9" ALDER, N59°E, 16.6' (SCRIBED/PAINTED RED)


NORTH 1/4 CORNER SECTION 14

FD. 1954 G.L.O. BRASS CAP AND 72" STEEL POST
15" FIR SNAG, S57°W, 35.0' (SCAR VIS.), 1954 B.T.
17" FIR SNAG, N45°W, 12.0' (SCAR VIS.), 1954 B.T.
12" FIR SNAG, S75°E, 33.3' (SCAR VIS.), 1967 B.T.
20" FIR SNAG, N34°E, 17.5' (SCAR VIS.), 1967 B.T.
SET 6" FIR, S02°W, 23.3' (SCRIBED/PAINTED RED)
7" FIR, N73°W, 22.0' (SCRIBED/PAINTED RED)

SURVEY FOR
INTERNATIONAL PAPER COMPANY
IN
SE1/4 SECTION 10, T20S, R8W
NW1/4 SECTION 14, T20S, R8W
DOUGLAS COUNTY, OREGON


BY
ROBERTS SURVEYING INC.
29 WEST 29TH STREET
EUGENE, OREGON 97405
PHONE 345-1112

FEBRUARY 10, 1993
SCALE 1" = 400'

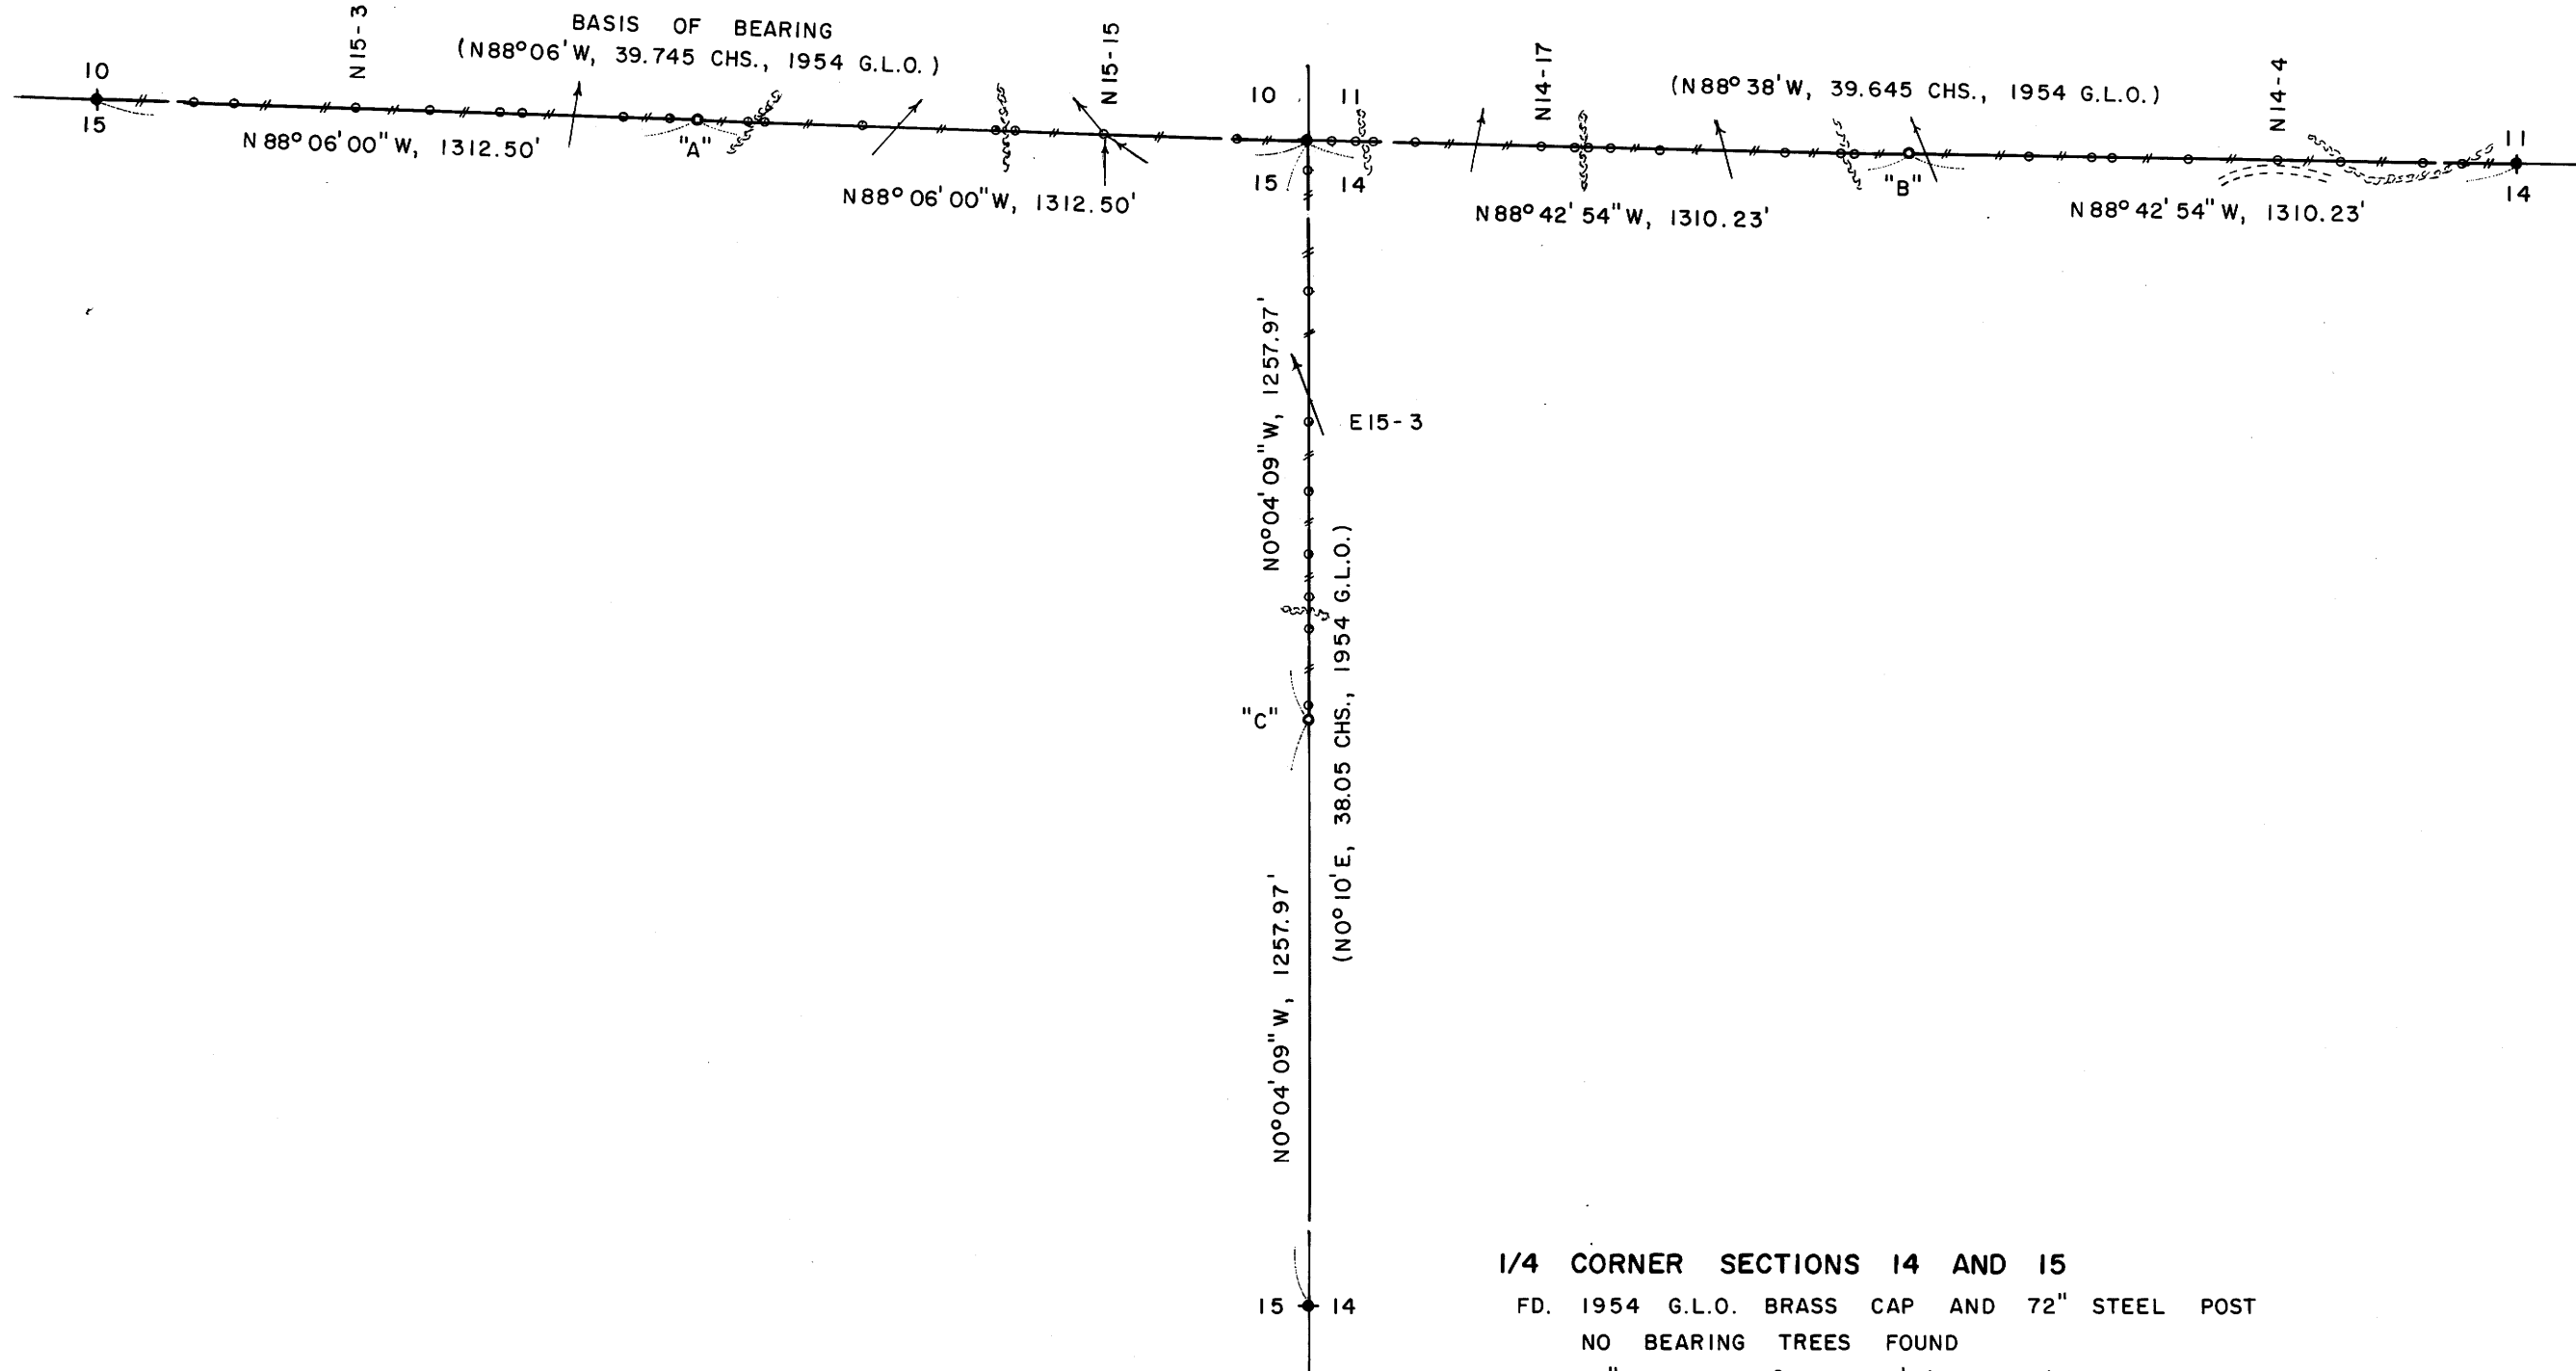

LEGEND,

- MONUMENTS FOUND AND USED FOR CONTROL
- MONUMENTS SET, 3/4" x 30" ALUMINUM RODS WITH 3/4" ALUMINUM CAPS. CAPS STAMPED S-T-R, DATE AND P.L.S. 1039
- LINES POSTED AND BLAZED THIS SURVEY
- () DATA OF RECORD, 1954 G.L.O. SURVEY
- BASIS OF BEARING, EAST 1/2 OF SOUTH LINE SECTION 10 FROM 1954 G.L.O. SURVEY.
- DISTANCES TO B.T.'S ARE CENTER MEASURE
- M.M. INDICATES LOCATION OF BURIED MAGNETIC MARKERS. MARKERS ARE FLUORESCENT ORANGE IN COLOR AND ARE BURIED, 12" TO 18" DEEP, ALONG LINE AS SHOWN.
- ALL NEW B.T.'S ARE SCRIBED AND HAVE A METAL WASHER STAMPED "P.L.S. 1039" NAILED TO LOWER BLAZE. SCRIBED BLAZES ARE PAINTED RED.
- ALL NEW B.T.'S HAVE A 6" STEEL SPIKE DRIVEN INTO THE CENTER OF THE TREE TO SERVE AS A CHAINING POINT FOR MEASURED DISTANCES.

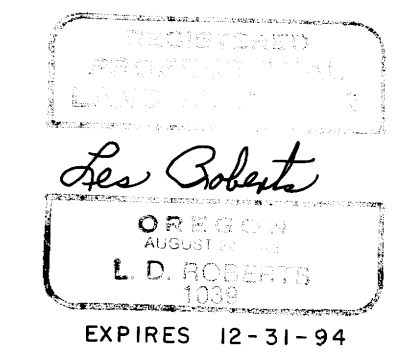

1/4 CORNER SECTIONS 14 AND 15

FD. 1954 G.L.O. BRASS CAP AND 72" STEEL POST
NO BEARING TREES FOUND
SET 8" FIR, S66°W, 48.6' (SCRIBED/PAINTED RED)
10" FIR, S33°E, 8.4' (SCRIBED/PAINTED RED)

"A" EAST 1/16 CORNER SECTION 15

SET 3/4" x 36" ALUM. ROD WITH 3/4" ALUM. CAP
(BURIED PURPLE M.M. UNDER 36" ALUM. ROD)
6" FIR, S29°W, 8.9' (SCRIBED/PAINTED RED)
6" FIR, N73°W, 20.9' (SCRIBED/PAINTED RED)

"B" WEST 1/16 CORNER SECTION 14

SET 3/4" x 42" ALUM. ROD WITH 3/4" ALUM. CAP
(BURIED PURPLE M.M. UNDER 42" ALUM. ROD)
22" FIR, S09°W, 27.4' (SCRIBED/PAINTED RED)
26" FIR, N89°E, 46.5' (SCRIBED/PAINTED RED)

"C" NORTH 1/16 CORNER SECTIONS 14 & 15

SET 3/4" x 42" ALUM. ROD WITH 3/4" ALUM. CAP
(BURIED PURPLE M.M. UNDER 42" ALUM. ROD)
7" FIR, S53°W, 18.3' (SCRIBED/PAINTED RED)
8" FIR, S17°E, 11.2' (SCRIBED/PAINTED RED)

NARRATIVE, THE PURPOSE OF THIS SURVEY IS TO BLAZE AND POST THE EAST 1/2 OF THE SOUTH LINE OF SECTION 10. ALSO TO BLAZE AND POST THE NORTH AND WEST LINES OF THE NW1/4 OF SECTION 14. ALSO 1/16 CORNERS "A", "B" AND "C" WERE SET IN THIS SURVEY. THE FOLLOWING CORNERS WERE FOUND IN THE FIELD AND USED FOR CONTROL; 1) NORTH 1/4 CORNER SECTION 15, 2) N.E. CORNER SECTION 15, 3) NORTH 1/4 CORNER SECTION 14 AND 4) WEST 1/4 CORNER SECTION 14. A SERIES OF CLOSED RANDOM CONTROL TRAVERSES, USING A WILD T-16 THEODOLITE AND A WILD DI-4L E.D.M., WERE RUN BETWEEN THE ABOVE FOUND CONTROLLING CORNERS. INVERSES WERE COMPUTED BETWEEN SAID CONTROLLING CORNERS WITH THE RESULTING BEARINGS AND DISTANCES AS SHOWN HEREON. A CLOSED RANDOM PROPERTY LINE TRAVERSE, USING A WILD T-16 THEODOLITE AND A WILD DI-4L E.D.M., WAS RUN ALONG ALL PROPERTY LINES TO BE BLAZED AND POSTED. OFFSETS WERE COMPUTED FROM THIS PROPERTY LINE TRAVERSE TO THE TRUE PROPERTY LINE. PROPERTY LINES WERE MARKED WITH RED PAINTED BLAZES, RED RIBBON, YELLOW INTERNATIONAL PAPER COMPANY BOUNDARY LINE DECALS ATTACHED TO 72" ALUMINUM POSTS AND BURIED FLUORESCENT ORANGE MAGNETIC MARKERS. ALUMINUM POSTS AND BURIED MAGNETIC MARKERS ARE REFERENCED BY A 4" x 6" ALUMINUM BOUNDARY LINE TAG NAILED TO A NEARBY TREE. TAG NOTES BEARING AND DISTANCE FROM TREE TO ALUMINUM POST OR BURIED MAGNETIC MARKER. THE EAST 1/16 CORNER TO SECTIONS 10 AND 15, MONUMENT "A", WAS SET HALFWAY BETWEEN THE FOUND NORTH 1/4 CORNER AND THE FOUND N.E. SECTION CORNER AS SHOWN. THE WEST 1/16 CORNER TO SECTIONS 11 AND 14, MONUMENT "B", WAS SET HALFWAY BETWEEN THE FOUND NORTH 1/4 CORNER AND THE FOUND N.W. SECTION CORNER AS SHOWN. THE NORTH 1/16 CORNER TO SECTIONS 14 AND 15, MONUMENT "C", WAS SET HALFWAY BETWEEN THE FOUND WEST 1/4 CORNER AND THE FOUND N.W. SECTION CORNER AS SHOWN.

LOCATION OF BURIED MAGNETIC MARKERS

N1/4 COR.	0'	EAST	(STEEL POST)	N1/4 COR.	0'	WEST	(STEEL POST)
N15-1	212'	EAST	(M.M. & AL. POST)	N14-1	118'	WEST	(M.M.)
N15-2	298'	EAST	(M.M. & AL. POST)	N14-2	202'	WEST	(M.M. & AL. POST)
N15-3	564'	EAST	(M.M. & AL. POST)	N14-3	382'	WEST	(M.M.)
N15-4	720'	EAST	(M.M. & AL. POST)	N14-4	513'	WEST	(M.M. & AL. POST)
N15-5	876'	EAST	(M.M.)	N14-5	710'	WEST	(M.M.)
N15-6	923'	EAST	(M.M. & AL. POST)	N14-6	873'	WEST	(M.M. & AL. POST)
N15-7	1145'	EAST	(M.M. & AL. POST)	N14-7	918'	WEST	(M.M.)
N15-8	1245'	EAST	(M.M.)	N14-8	1055'	WEST	(M.M. & AL. POST)
E1/16 COR.	1312'	EAST	(M.M. & AL. POST)	W1/16 COR.	1310'	WEST	(M.M. & AL. POST)
N15-10	1417'	EAST	(M.M. & AL. POST)	N14-10	1435'	WEST	(M.M.)
N15-11	1450'	EAST	(M.M.)	N14-11	1463'	WEST	(M.M. & AL. POST)
N15-12	1659'	EAST	(M.M. & AL. POST)	N14-12	1586'	WEST	(M.M. & AL. POST)
N15-13	1951'	EAST	(M.M. & AL. POST)	N14-13	1855'	WEST	(M.M. & AL. POST)
N15-14	1991'	EAST	(M.M.)	N14-14	1962'	WEST	(M.M.)
N15-15	2183'	EAST	(M.M. & AL. POST)	N14-15	2008'	WEST	(M.M.)
N15-16	2472'	EAST	(M.M. & AL. POST)	N14-16	2041'	WEST	(M.M. & AL. POST)
N.E. COR.	2625'	EAST	(STEEL POST)	N14-17	2109'	WEST	(M.M. & AL. POST)
E15-1	64'	SOUTH	(M.M. & AL. POST)	N14-18	2387'	WEST	(M.M. & AL. POST)
E15-2	322'	SOUTH	(M.M. & AL. POST)	N14-19	2473'	WEST	(M.M.)
E15-3	605'	SOUTH	(M.M. & AL. POST)	N14-20	2512'	WEST	(M.M. & AL. POST)
E15-4	754'	SOUTH	(M.M. & AL. POST)	N14-21	2561'	WEST	(M.M.)
E15-5	891'	SOUTH	(M.M.)	N.W. COR.	2620'	WEST	(STEEL POST)
E15-6	985'	SOUTH	(M.M. & AL. POST)				
E15-7	1050'	SOUTH	(M.M.)				
E15-8	1233'	SOUTH	(M.M. & AL. POST)				
N1/16 COR.	1258'	SOUTH	(M.M. & AL. POST)				
E1/4 COR.	2516'	SOUTH	(STEEL POST)				

U.S. FILE 631149
 M116-53

U.S. FILE 631149
 M116-53

OREGON CORNER RESTORATION FORM

FILED JP

Section 14 Township 20S Range 8W

MAR 9 1993

County Douglas Date 01-21-93

COUNTY SURVEYOR

CORNER DESIGNATION

West $\frac{1}{4}$ Corner
Section 14

- Condition
- Not Found
- Renewed
- Unrecorded
- Surveyed In
- Referenced Out

DOUGLAS COUNTY, ORE.

Previous Renewals/Surveys, etc. Original G.L.O. Survey by William P. Wright in 1883-1884. 1953-1954 B.L.M. Survey by Thomas Tillman and a 1967 B.L.M. Remonumentation Survey.


Monument(s) & Accessories Found: (Condition and Source)

Found 1954 G.L.O. Brass Cap set firmly in the ground.

Also found 6' steel fence post beside brass cap. No 1954 bearing trees found.

Monument Detail

Sketch

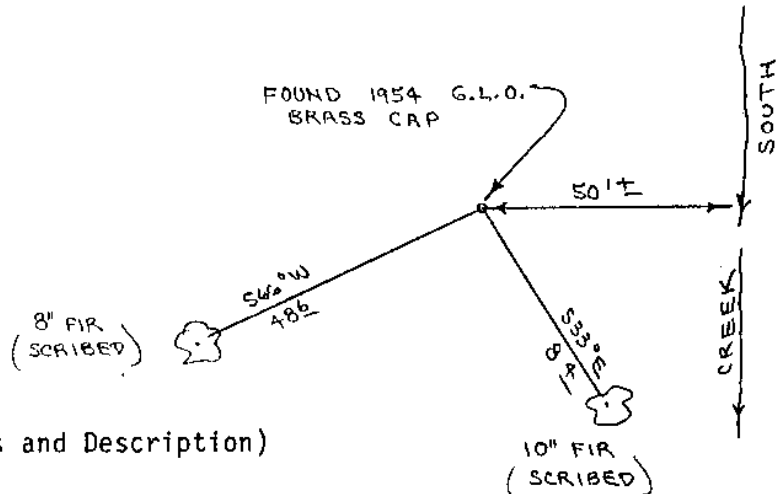

Monument Set (Procedures and Description)

New Accessories

Set 8" Fir, S66W, 48.6' (Scribed/Painted Red)

10" Fir, S33E, 8.4' (Scribed/Painted Red)

Painted both bearing trees red.

Location & Comments

Corner lies on S.E. slope Compass Declination 20 $\frac{1}{2}$

about 50' West of Creek. Firm/Agency Roberts

Creek bears North-South Surveying, Inc.

Address 29 West 29th St.


Eugene, Oregon 97405

Party Chief Stuart Duce

Notes

Witness Brad Cole

Surveyor's Seal

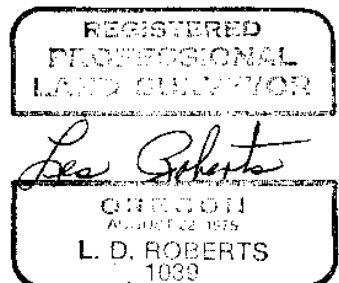

MAR 9 1993

OREGON CORNER RESTORATION FORM

Section 10 Township 20S Range 8W

COUNTY SURVEYOR
DOUGLAS COUNTY, ORE.

County Douglas Date 01-18-93

CORNER DESIGNATION

S.E. Corner
Section 10


- Condition Report Only
- Not Found
- Renewed
- Unrecorded
- Surveyed In
- Referenced Out

Previous Renewals/Surveys, etc. Original G.L.O. Survey by William P. Wright in 1883-1884. 1953-1954 B.L.M. Survey by Thomas Tillman and a 1967 B.L.M. Remonumentation Survey.

Monument(s) & Accessories Found: (Condition and Source)

Found 1954 G.L.O. Brass Cap set firmly in the ground.
20" Fir Stump, S30W, 27.5' (Scar Vis.), 1954 BT. Record S30W, 27.7'
22" Fir Stump, S32E, 4.5' (Scar Vis.), 1954 BT. Record S313/4E, 4.6'
40" Fir, N43E, 18.0' (Scar Vis.), 1967 BT. Record N43 1/2 E, 17.8'
Painted all bearing trees red.

Monument Detail

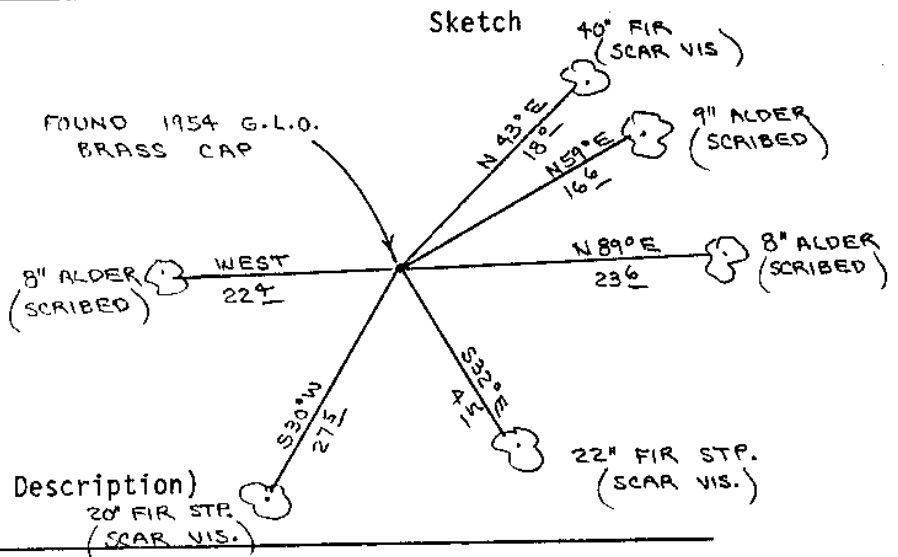

Monument Set (Procedures and Description)


New Accessories

Set 8" Alder, N89E, 23.6' (Scribed/Painted Red)
8" Alder, West, 22.4' (Scribed/Painted Red)
9" Alder, N59E, 16.6' (Scribed/Painted Red)
Painted all bearing trees red.

Location & Comments

Corner lies on S.W. slope about 120' West of spur ridge. Ridge bears N10W and S10E.
Compass Declination 20 1/2
Firm/Agency Roberts Surveying, Inc.
Address 29 West 29th St. Eugene, Oregon 97405
Party Chief Ted Baker
Notes
Witness Stuart Duce

Surveyor's Seal

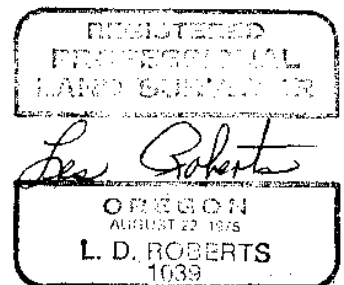

23
+

MAR 9 1993

OREGON CORNER RESTORATION FORM

Section 14 Township 20S Range 8W

COUNTY SURVEYOR
DOUGLAS COUNTY, ORE.

County Douglas Date 01-25-93

CORNER DESIGNATION

North $\frac{1}{4}$ Corner
Section 14


- Condition Report Only
- Not Found
- Renewed
- Unrecorded
- Surveyed In
- Referenced Out

Previous Renewals/Surveys, etc. Original G.L.O. Survey by William P. Wright in 1883-1884. 1953-1954 B.L.M. Survey by Thomas Tillman and a 1967 B.L.M. Remonumentation Survey.

Monument(s) & Accessories Found: (Condition and Source)

Found 1954 G.L.O. Brass Cap set firmly in the ground.
15" Fir Snag, S57W, 35.0' (Scar Vis.), 1954 BT. Record S57W, 35.6'
17" Fir Snag, N45W, 12.0' (Scar Vis.), 1954 BT. Record N43 $\frac{1}{2}$ W, 11.2'
12" Fir Snag, S75E, 33.3' (Scar Vis.), 1967 BT. Record S76E, 33.0'
20" Fir Snag, N34E, 17.5' (Scar Vis.), 1967 BT. Record N34 $\frac{1}{2}$ E, 17.2'
Painted all bearing trees red. Also found 6' steel fence post beside brass cap.

Monument Detail

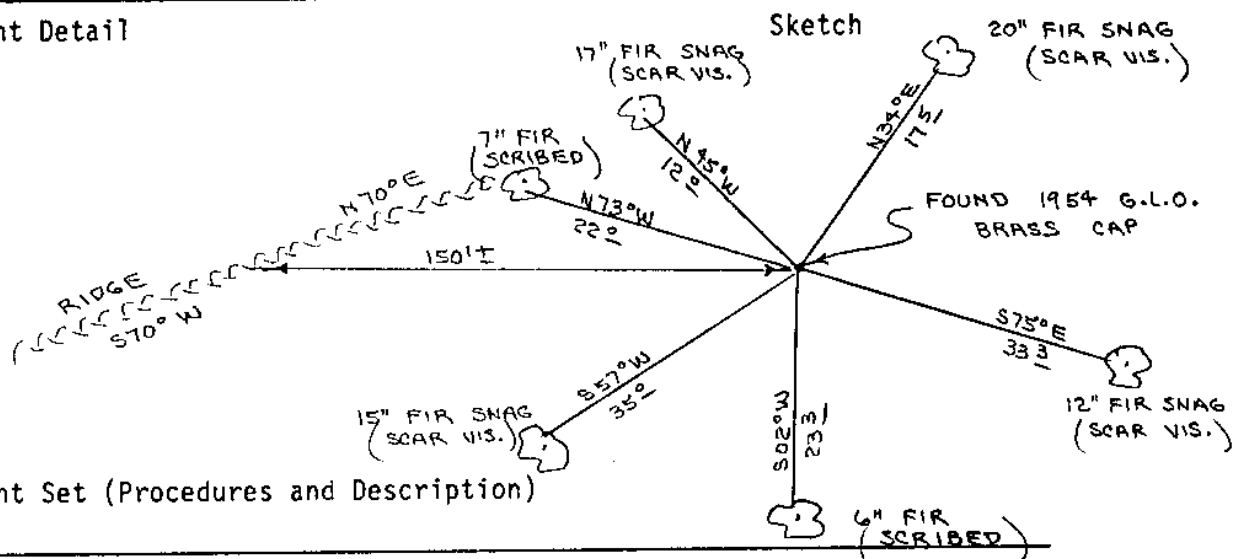

Monument Set (Procedures and Description)


New Accessories

Set 6" Fir, S02W, 23.3' (Scribed/Painted Red)
7" Fir, N73W, 22.0' (Scribed/Painted Red)
Painted all bearing trees red.

Location & Comments

Corner lies on South slope about 150' East of ridge. Compass Declination 20 $\frac{1}{2}$
Ridge bears N70E and S70W Firm/Agency Roberts
Surveying, Inc.
Address 29 West 29th St.
Eugene, Oregon 97405
Party Chief Stuart Duce
Notes
Witness Brad Cole

Surveyor's Seal

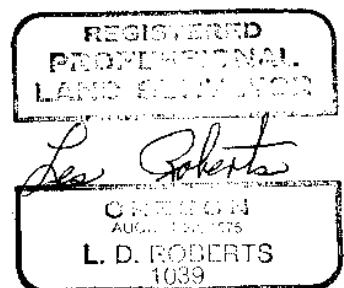

#24

MAR 9 1993

OREGON CORNER RESTORATION FORM

Section 10 Township 20S Range 8W

COUNTY SURVEYOR
DOUGLAS COUNTY, ORE.

County Douglas Date 01-18-93

CORNER DESIGNATION

South $\frac{1}{4}$ Corner
Section 10


- Condition Report Only
- Not Found
- Renewed
- Unrecorded
- Surveyed In
- Referenced Out

Previous Renewals/Surveys, etc. Original G.L.O. Survey by William P. Wright in 1883-1884. 1953-1954 B.L.M. Survey by Thomas Tillman and a 1967 B.L.M. remonumentation survey.

Monument(s) & Accessories Found: (Condition and Source)

Found 1954 G.L.O. Brass Cap set firmly in the ground.
60" Downed Cedar, S22W, 47.0' (Scar Vis.), 1954 BT. Record S22W, 46.9' ✓
66" Cedar, N56E, 24.6' (Scar Vis.), 1954 BT. Record N57E, 23.8' ✓
Also found 6' steel fence post beside brass cap. Painted all bearing trees red.


Monument Detail Sketch

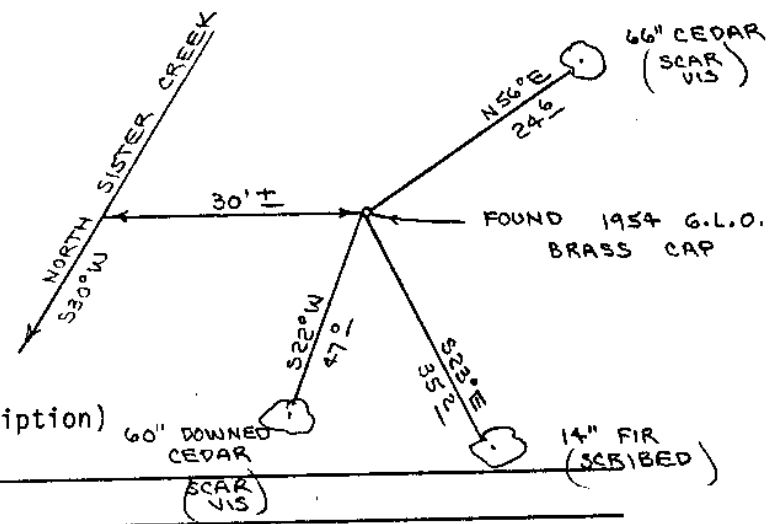

Monument Set (Procedures and Description)

New Accessories
Set 14" Fir, S23E, 35.2' (Scribed/Painted red). Painted all bearing trees red.

Location & Comments
 Corner lies on N.W. slope Compass Declination 20 $\frac{1}{2}$
 about 30' East on North Firm/Agency Roberts
Sister Creek, Surveying, Inc.
 Address 29 West 29th St.
Eugene, Oregon 97405
 Party Chief Ted Baker
 Notes _____
 Witness Stuart Duce.

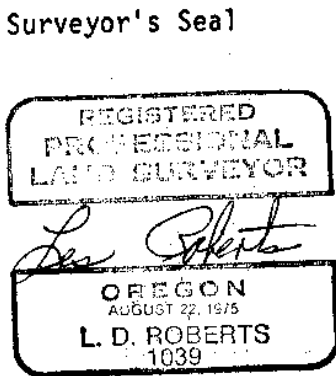

#21

MAR 9 1993

OREGON CORNER RESTORATION FORM

Section 14 Township 20S Range 8W

County Douglas Date 01-27-93

COUNTY SURVEYOR
DOUGLAS COUNTY, ORE.

CORNER DESIGNATION

West 1/16 Corner, North
Line Section 14

- Condition Report Only
- Not Found
- Renewed
- Unrecorded
- Surveyed In
- Referenced Out


Previous Renewals/Surveys, etc. Original G.L.O. Survey by William P. Wright in 1883-1884. 1953-1954 B.L.M. Survey by Thomas Tillman and a 1967 B.L.M. Remonumentation Survey.

Monument(s) & Accessories Found: (Condition and Source)

None

Monument Detail

Sketch

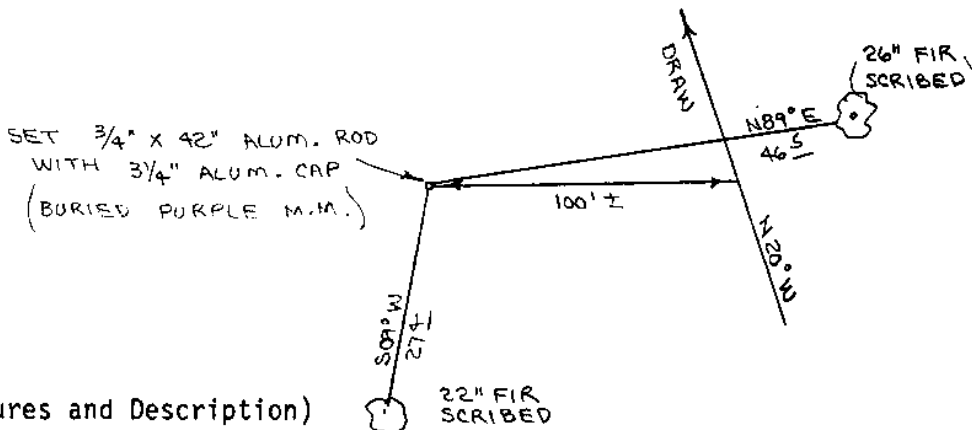

Monument Set (Procedures and Description)

Set 3/4" x 42" Aluminum Rod with a 3/4" Aluminum Cap. Buried purple magnetic marker under 42" Aluminum Rod. See filed survey for survey procedures.

New Accessories

- Set 22" Fir, S09W, 27.4' (Scribed/Painted Red)
- 26" Fir, N89E, 46.5' (Scribed/Painted Red)
- Set 72" Aluminum Post, with land monument survey sign attached to, beside brass cap. Painted both bearing trees red.

Location & Comments

Corner lies on N.E. slope about 30' West of draw. Compass Declination 20 1/2

Draw bears N20W and S20E Firm/Agency Roberts Surveying, Inc.

Address 29 West 29th St.


Eugene, Oregon 97405

Party Chief Stuart Duce

Notes

Witness Brad Cole

Surveyor's Seal

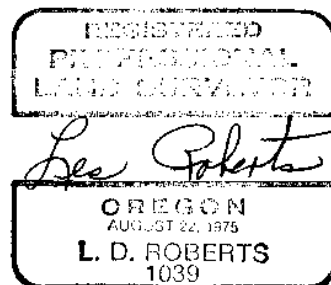

OREGON CORNER RESTORATION FORM

MAR 9 1993

Section 15 Township 20S Range 8W

COUNTY SURVEYOR
DOUGLAS COUNTY, ORE.

County Douglas Date 01-29-93

CORNER DESIGNATION

East 1/16 Corner, North
Line Section 15

- Condition Report Only
- Not Found
- Renewed
- Unrecorded
- Surveyed In
- Referenced Out


Previous Renewals/Surveys, etc. Original G.L.O. Survey by William P. Wright in 1883-1884. 1953-1954 B.L.M. Survey by Thomas Tillman and a 1967 B.L.M. Remonumentation Survey.

Monument(s) & Accessories Found: (Condition and Source)

None

Monument Detail

Sketch

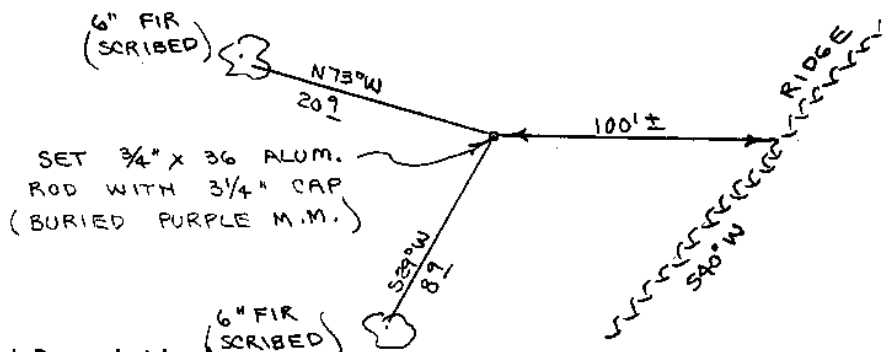

Monument Set (Procedures and Description)

Set 3/4" x 36" Aluminum Rod with a 3/4" Aluminum Cap. Buried purple magnetic marker under 36" Aluminum Rod. See filed survey for survey procedures.

New Accessories

- 6" Fir, S29W, 8.9' (Scribed/Painted Red)
- 6" Fir, N73W, 20.9' (Scribed/Painted Red)
- Set 72" Aluminum Post with land monument survey sign attached to, beside brass cap. Painted both bearing trees red.

Location & Comments

Corner lies on N.W. slope about 100' West of ridge. Ridge bears N40E and S40W

Compass Declination 20 1/2

Firm/Agency Roberts Surveying, Inc.


Address 29 West 29th St. Eugene, Oregon 97405

Party Chief Stuart Duce

Notes _____

Witness Brad Cole

Surveyor's Seal

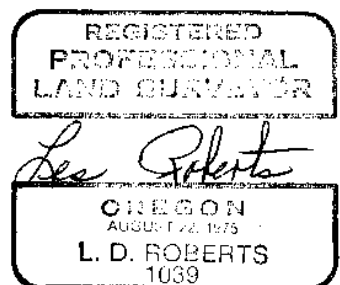

OREGON CORNER RESTORATION FORM

MAR 9 1993

Section 14 Township 20S Range 8W

COUNTY SURVEYOR
DOUGLAS COUNTY, ORE.

County Douglas Date 01-28-93

CORNER DESIGNATION

North 1/16 Corner, West
Line Section 14


- Condition Report Only
- Not Found
- Renewed
- Unrecorded
- Surveyed In
- Referenced Out

Previous Renewals/Surveys, etc. Original G.L.O. Survey by William P. Wright in 1883-1884. 1953-1954 B.L.M. Survey by Thomas Tillman and a 1967 B.L.M. Remonumentation Survey.

Monument(s) & Accessories Found: (Condition and Source)

None

Monument Detail

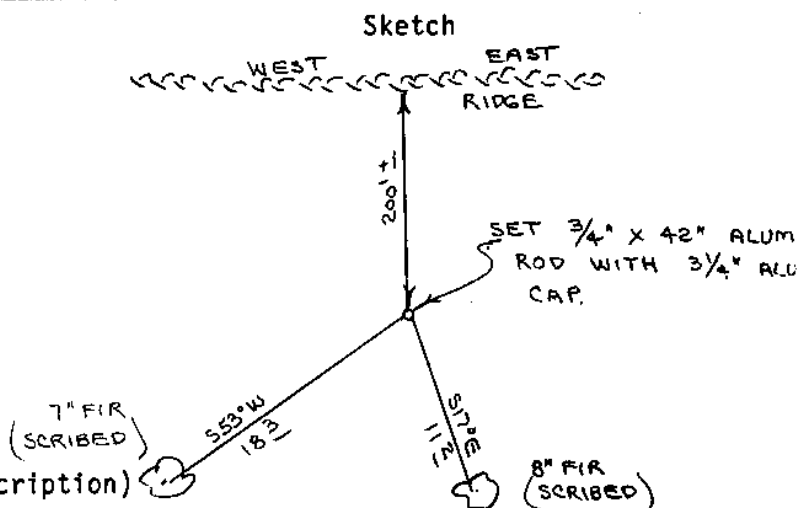

Monument Set (Procedures and Description) Set 3/4" x 42" Aluminum Rod with a 3/4" Aluminum Cap. Buried purple magnetic marker under 42" Aluminum Rod. See filed survey for survey procedures.

New Accessories

- Set 7" Fir, S53W, 18.3' (Scribed/Painted Red)
- 8" Fir, S17E, 11.2' (Scribed/Painted Red)
- Set 72" Aluminum Post, with land monument survey sign attached to, beside brass cap. Painted both bearing trees red.

Location & Comments

Corner lies on South slope Compass Declination 20 1/2
 about 200' South of ridge. Firm/Agency Roberts
Ridge bears East-West Surveying, Inc.
Address 29 West 29th St.
Eugene, Oregon 97405
Party Chief Stuart Duce
Notes
Witness Brad Cole

Surveyor's Seal

