

BOUNDARY LINE SURVEY IN LOT 13, BLOCK 2, PLAT C, S.L. & W. CO., LOCATED IN THE S.W. 1/4 OF SECTION 20,
T.25S., R.5W., W.M., SUTHERLIN, OREGON

PROPERTY SURVEYORS FILE DATA
DO NOT REMOVE FROM OFFICE


FOR: LINFORD COULTAS
416 S. CALPOOYA
SUTHERLIN, OR. 97479

BY: ROBERT L. DOLAN
3614 NONPARIEL RD.
SUTHERLIN, OR. 97479

DATE: MARCH 1993

SCALE: 1" = 100'

Legend: ○ FD. 1/2" IRON ROD OR AS NOTED
● SET 5/8" x 30" IRON ROD W/CAP (L.S. 219)

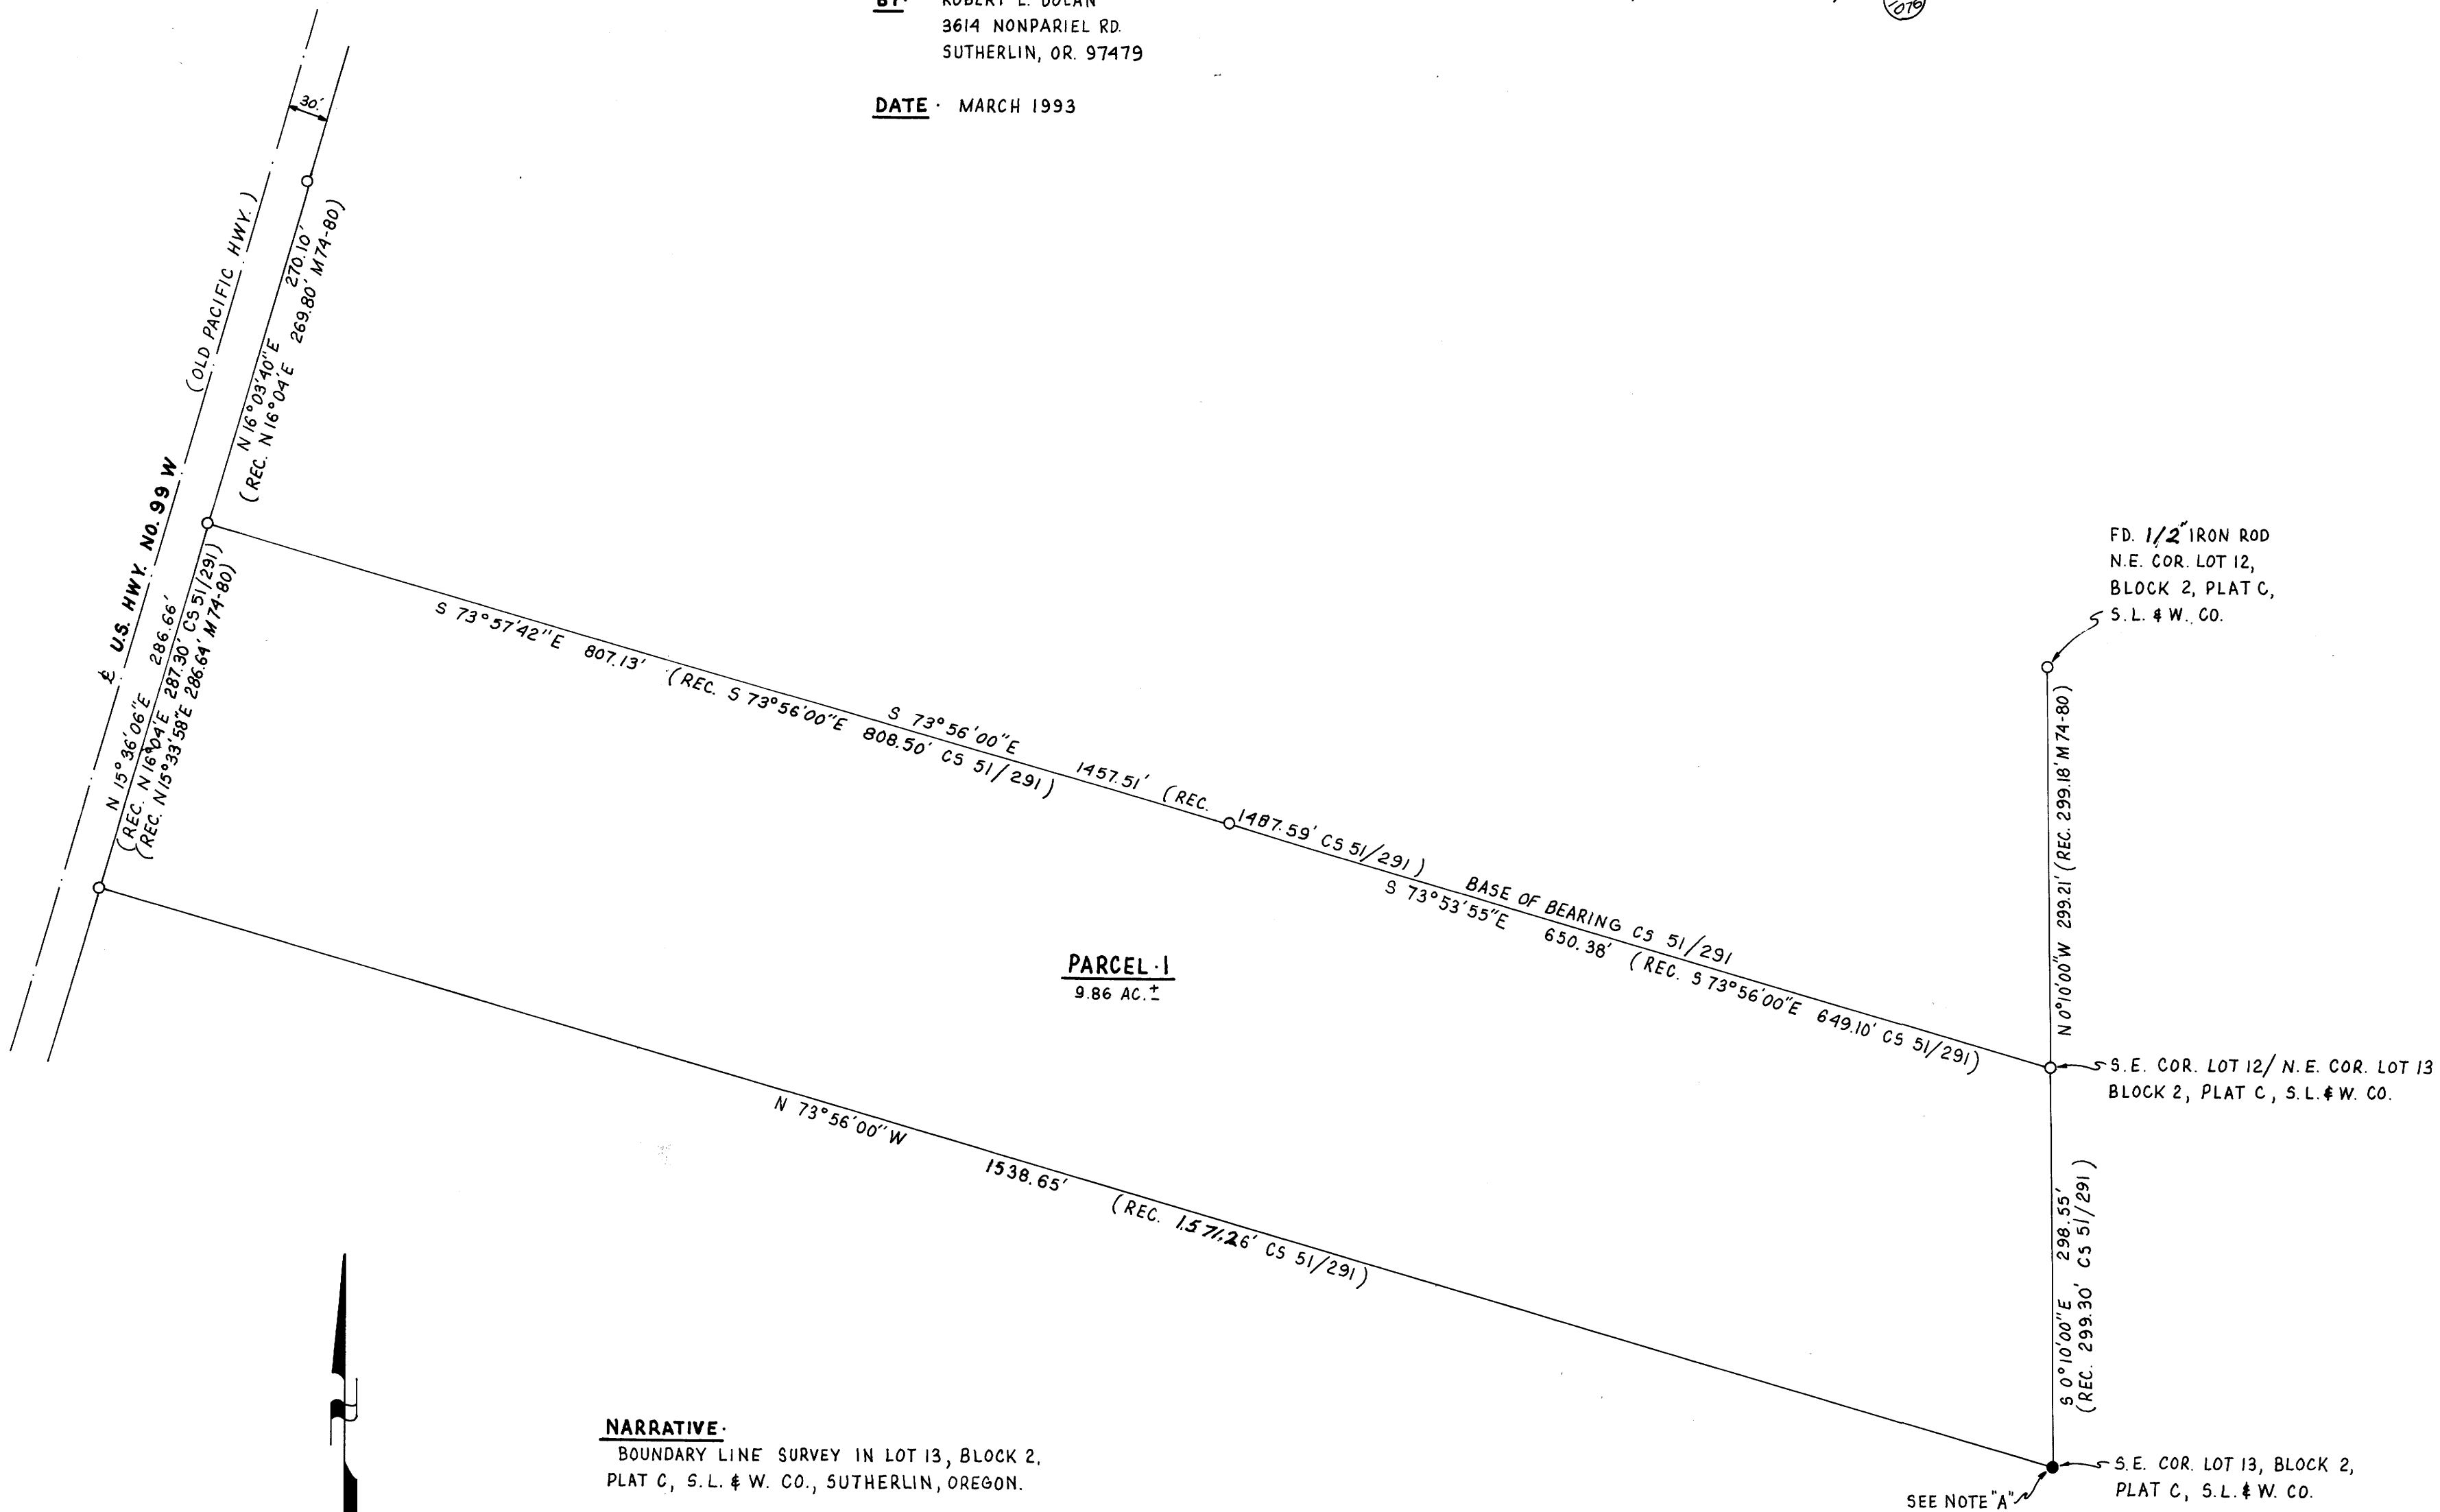

NARRATIVE:
BOUNDARY LINE SURVEY IN LOT 13, BLOCK 2,
PLAT C, S.L. & W. CO., SUTHERLIN, OREGON.

INSTRUMENTS: THEODOLITE & DISTANCE METER

NOTE "A":
POINT COMPUTED BY BEARING-BEARING
INTERSECTION FROM FOUND MONUMENTS

PROFESSIONAL
LAND SURVEYOR

ROBERT L. DOLAN
OREGON
July 30, 1976
1076

EXP. 12-93

MAP FILE M1166-76

MAP FILE M1166-76