

COMMON BOUNDARY LINE ADJUSTMENT

APPROVAL:

Alberta J. Pritchett
CANYONVILLE CITY RECORDER
(DEPUTY)

6-21-93
DATE

Located in the:
S.W. 1/4 of SECTION 27,
TOWNSHIP 30 SOUTH, RANGE 5 WEST,
WILLAMETTE MERIDIAN, DOUGLAS COUNTY, OREGON.
" CITY OF CANYONVILLE "

APPLICANT:
RAYMOND E. HANKS
P.O. BOX 23
CANYONVILLE, OREGON 97417

PREPARED BY:
RAYMOND F. BROWN - P.L.S. # 2391
P.O. BOX 539
CANYONVILLE, OREGON 97417
Phone: (503) 839 - 6185

LEGEND:


- FD. 5/8" IRON ROD AS PER M 103-25, UNLESS OTHERWISE NOTED.
- ⊙ FD. 5/8" IRON ROD AS PER 1990-0017
- SET 5/8" X 30" IRON ROD WITH PLASTIC CAP ATTACHED, MKD. " R. BROWN, PLS 2391 "
- () RECORD AS PER 1990-0017.
- (()) RECORD AS PER M 51-6.

REGISTERED
PROFESSIONAL
LAND SURVEYOR

Raymond F. Brown

OREGON
JULY 26, 1989
RAYMOND F. BROWN
2391

EXP. 12/31/93

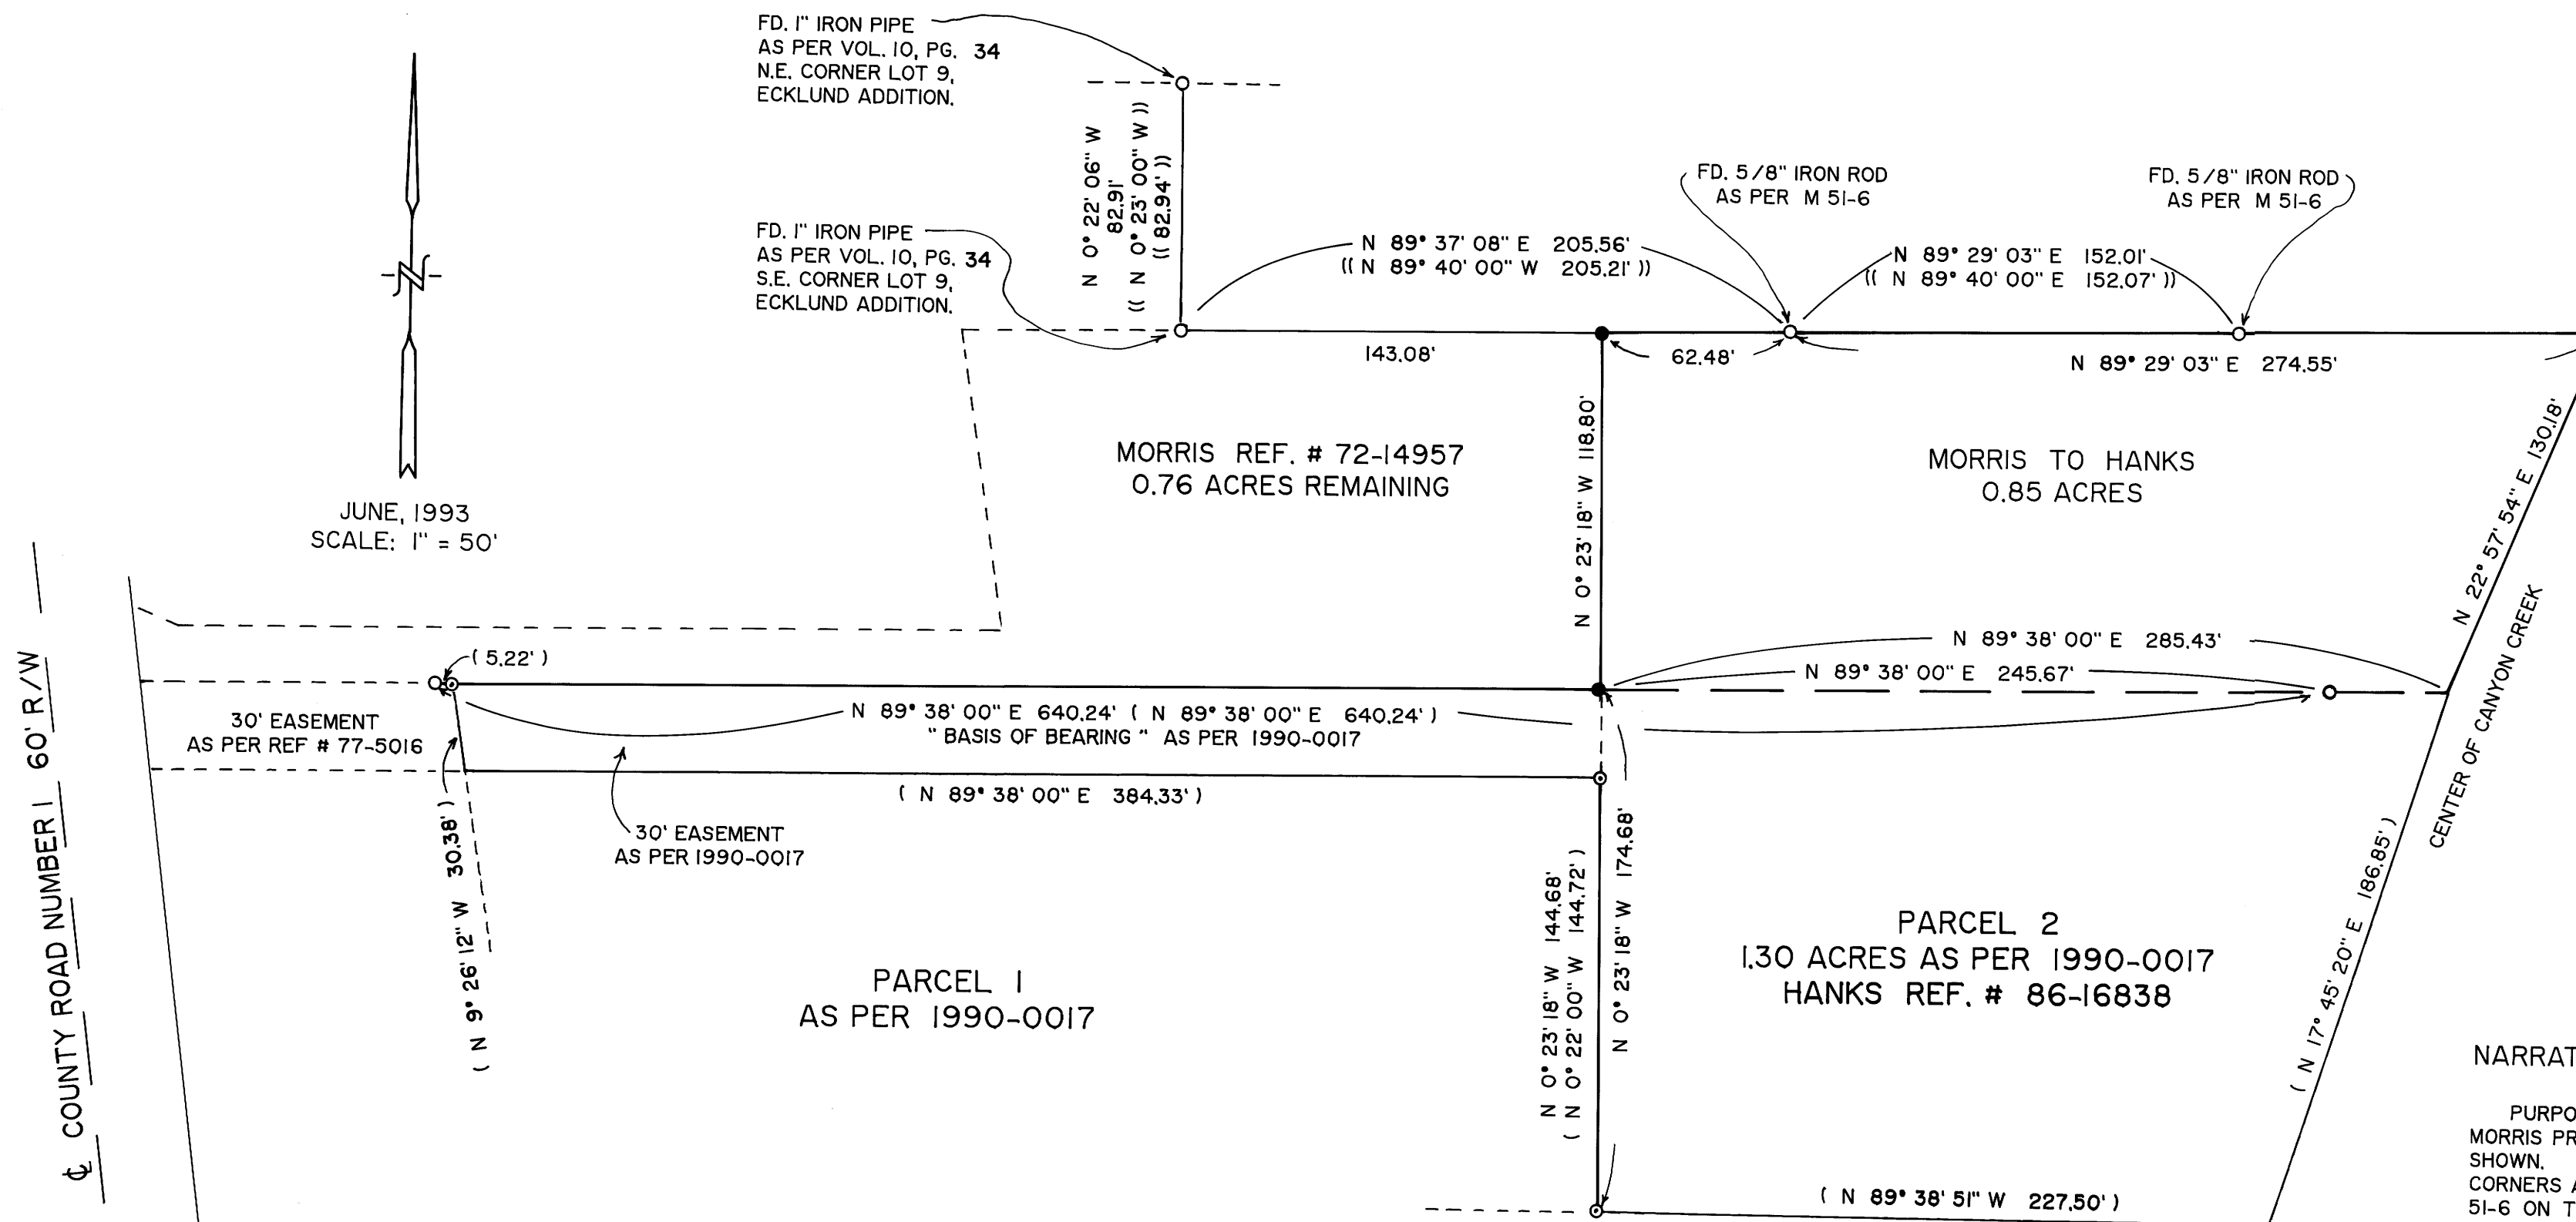

NARRATIVE:

PURPOSE OF THE SURVEY WAS TO ADD THAT PART OF THE MORRIS PROPERTY TO PARCEL 2 OF THE HANKS PROPERTY AS SHOWN. FIELD INVESTIGATION LOCATED THE SAID FOUND CORNERS AND CONDITIONS. CONTROL FOR THE SURVEY WAS M 51-6 ON THE NORTH BOUNDARY, AGREED PLACEMENT ON THE WEST BOUNDARY, THE CENTER OF CANYON CREEK ON THE EAST BOUNDARY, AND 1990-0017 CONTROLLED THE SOUTH BOUNDARY AND WAS USED AS " BASIS OF BEARING ".

COUNTY SURVEYORS FILE DATA
DO NOT REMOVE FROM OFFICE