

PROPERTY SURVEY IN LOTS 5 AND 6, BLOCK "M", BROWN'S 2ND ADDITION TO THE RAILROAD ADDITION TO OAKLAND, LOCATED IN THE S.E. 1/4 OF SECTION 4, T.25S, R.5W, W.M., OAKLAND, OREGON

FOR: CORRINE WOODWARD


DATE: SEPTEMBER 1993

SCALE: 1" = 50'

FILED JP
NOV 1 1993 JC
COUNTY SURVEYORS
OFFICE
SC

BY: ROBERT L DOLAN
3614 NONPARIEL RD.
SUTHERLIN, OR. 97479

- Legend:**
- FD. 5/8" IRON ROD OR AS NOTED
 - POINT COMPUTED AS PER M 115-25 NOT SET
 - SET 5/8" x 30" IRON ROD W/CAP (LS 016)
 - () RECORD DATA FROM M115-25 AND LOTS 5 & 6, BLOCK M, BROWNS 2ND ADDITION TO THE RAILROAD ADDITION TO OAKLAND

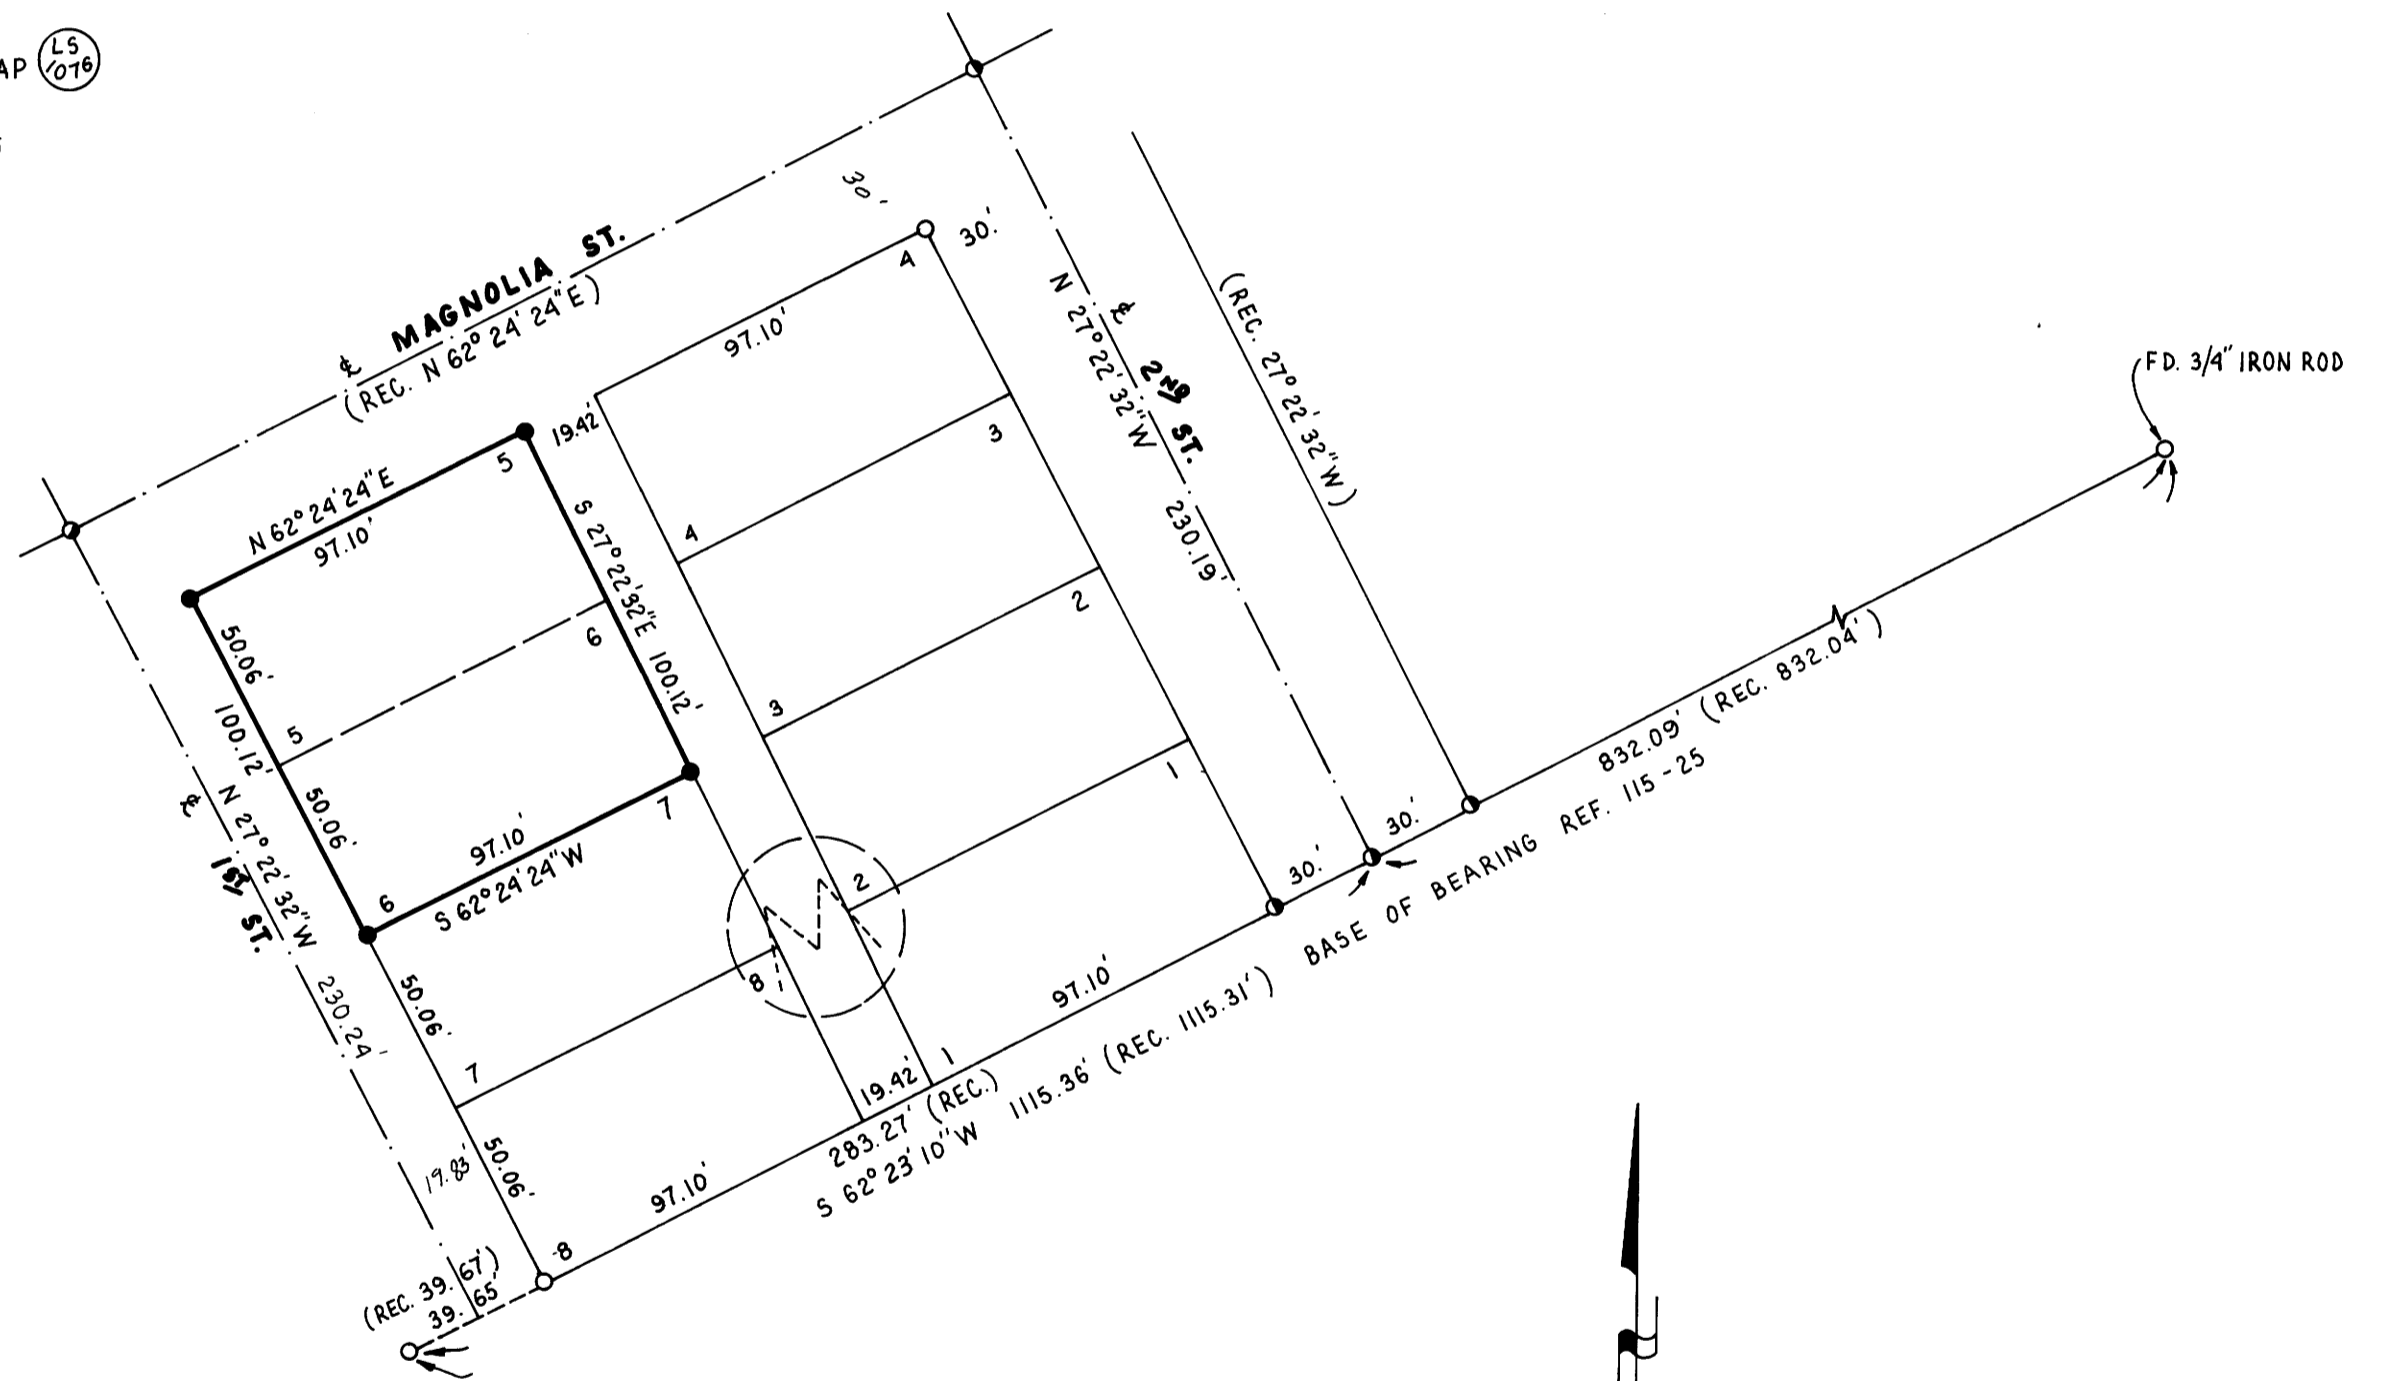

NARRATIVE: SURVEY TO MONUMENT PROPERTY CORNERS. 1ST ST. WAS COMPUTED BY PARRALLELING 1ST ST.

INSTRUMENT: NIKON DTM A10 L6 TOTAL STATION

**COUNTY SURVEYORS FILE DATA
DO NOT REMOVE FROM OFFICE**

REGISTERED
PROFESSIONAL
LAND SURVEYOR
Robert L Dolan
OREGON
JUN 20 1976
ROBERT L. DOLAN
1976

EXP 12-98

MAP FILE M117-74

M117-74