


Boundary Survey
in Section 3 and Section 4,
Township 26 South, Range 3 West, W.M.
For Western Timber Company
21 JAN 1994

FILED
Date: 3/7/94 By: JP
This survey consists of:
Map: M 118-33
Narrative: _____
Corner Rpt: _____

DOUGLAS COUNTY
SURVEYOR

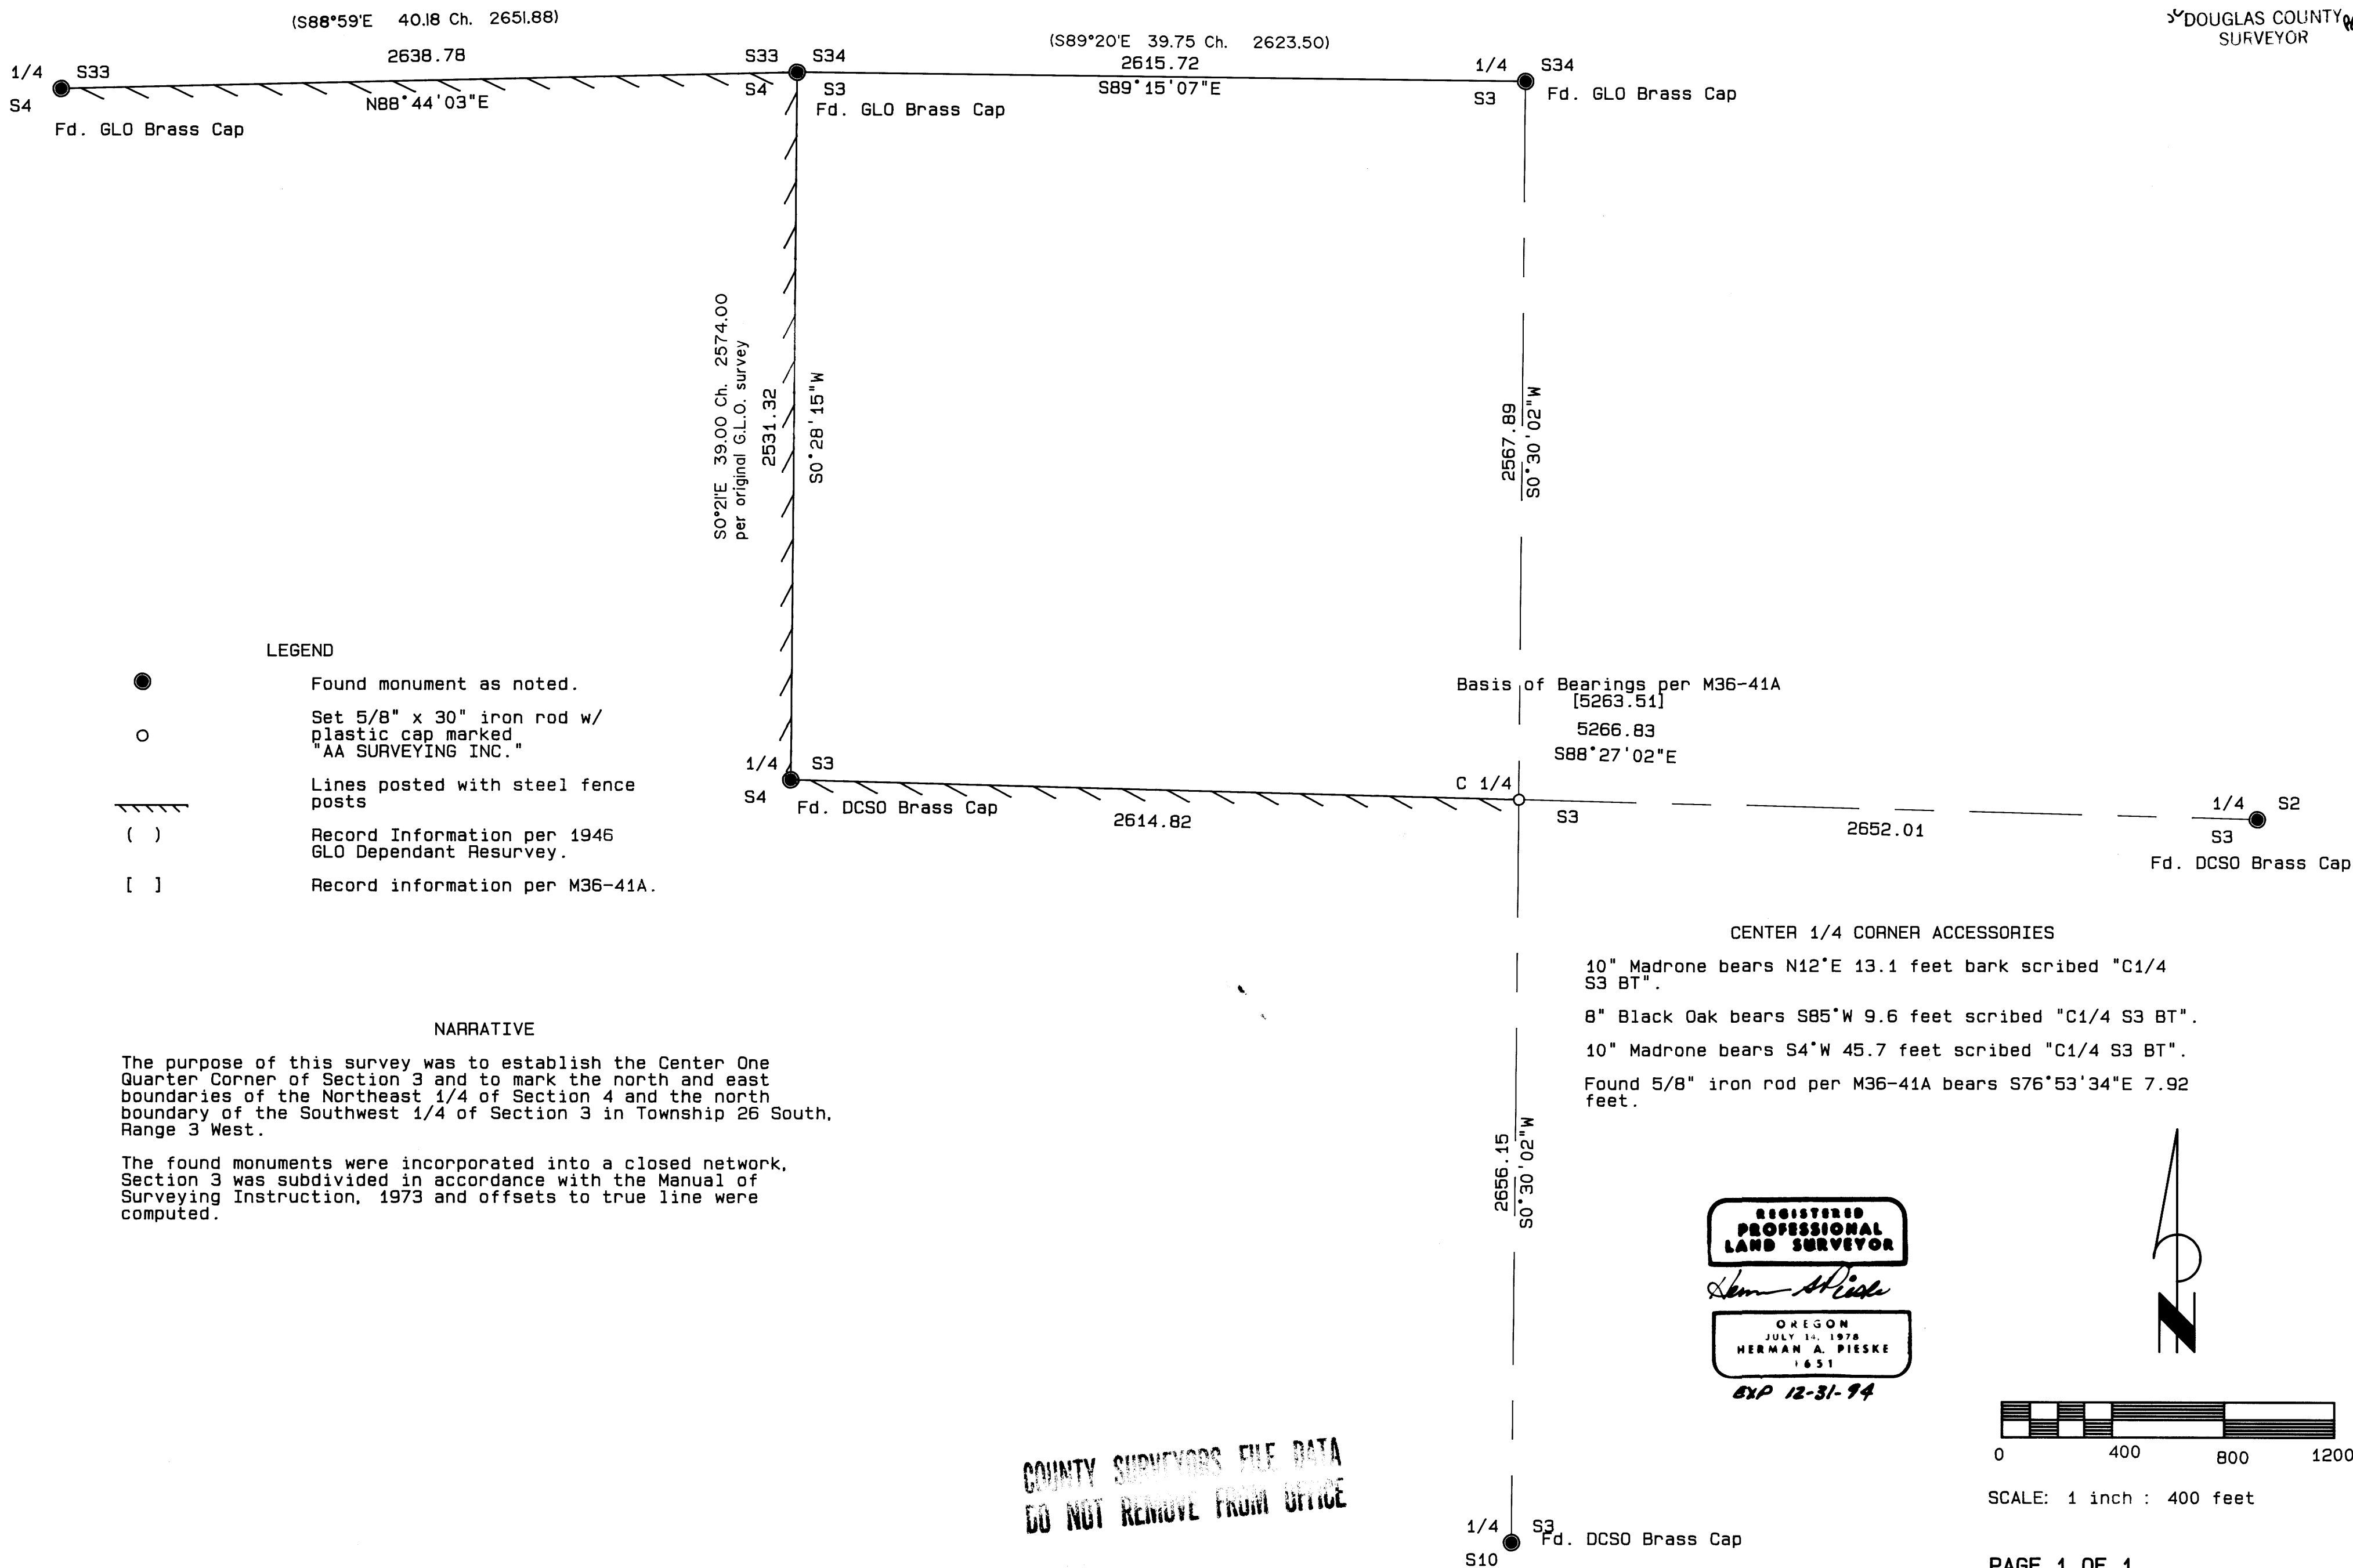

**COUNTY SURVEYORS FILE DATA
DO NOT REMOVE FROM OFFICE**

MAP FILE M 118-33