

Date: 9-27-94 By: JP  
This survey consists of:  
Map: M 120-64  
Narrative:  
Corner Plat:


LEGEND,

- MONUMENTS FOUND AND USED FOR CONTROL
- MONUMENTS SET, 5/8" x 30" IRON PINS WITH YELLOW PLASTIC CAPS. CAPS MARKED "ROBERTS P.L.S. 1039"
- ( ) DATA OF RECORD, 1856 G.L.O. SURVEY AND 1990 B.L.M. SURVEY.

LINES MARKED WITH RED PAINTED BLAZES, RED PLASTIC RIBBON AND RED METAL FENCE POSTS.

BASIS OF BEARING, EAST 1/2 OF EAST 1/2 NORTH LINE SECTION 10 FROM 1990 B.L.M. SURVEY - LINE "A-B"

DISTANCES TO BEARING TREES ARE CENTER MEASURE ALL NEW B.T.'S ARE SCRIBED AND HAVE A BRASS WASHER STAMPED "P.L.S. 1039" NAILED TO LOWER BLAZE. SCRIBED BLAZES ARE PAINTED RED.

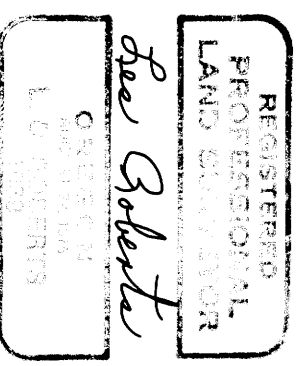


EXPIRES 12-31-94

SURVEY FOR  
GIUSTINA RESOURCES INC. & DOUGLAS COUNTY  
AND  
SENECA SAWMILL COMPANY  
OF  
EAST LINE SECTION 10, T21S, R5W, W.M.  
AND  
NORTH LINE SEC. 10, T21S, R5W, W.M.  
DOUGLAS COUNTY, OREGON  
BY  
ROBERTS SURVEYING INC.  
29 WEST 29TH STREET  
EUGENE, OREGON 97405  
PHONE 345-1112

**NARRATIVE,** THE PURPOSE OF THIS SURVEY IS TO BLAZE AND POST THE EAST LINE OF SECTION 10. ALSO TO BLAZE AND POST THE E1/2 OF THE E1/2 OF THE NORTH LINE OF SECTION 10. THE S.E. SECTION CORNER, THE EAST 1/4 CORNER, THE N.E. SECTION CORNER AND THE EAST 1/16 CORNER WERE FOUND IN THE FIELD AS SHOWN. A CLOSED RANDOM, WILD T-16 THEODOLITE AND A WILD DI-4L E.D.M., PROPERTY LINE TRAVERSE WAS RUN ALONG ALL PROPERTY LINES TO BE BLAZED AND POSTED. OFFSETS WERE COMPUTED FROM THIS RANDOM PROPERTY LINE TRAVERSE TO THE TRUE PROPERTY LINE. PROPERTY LINES WERE MARKED WITH RED PAINTED BLAZES, RED PLASTIC RIBBON AND RED METAL FENCE POSTS.

AUGUST 15, 1994  
SCALE 1" = 400'

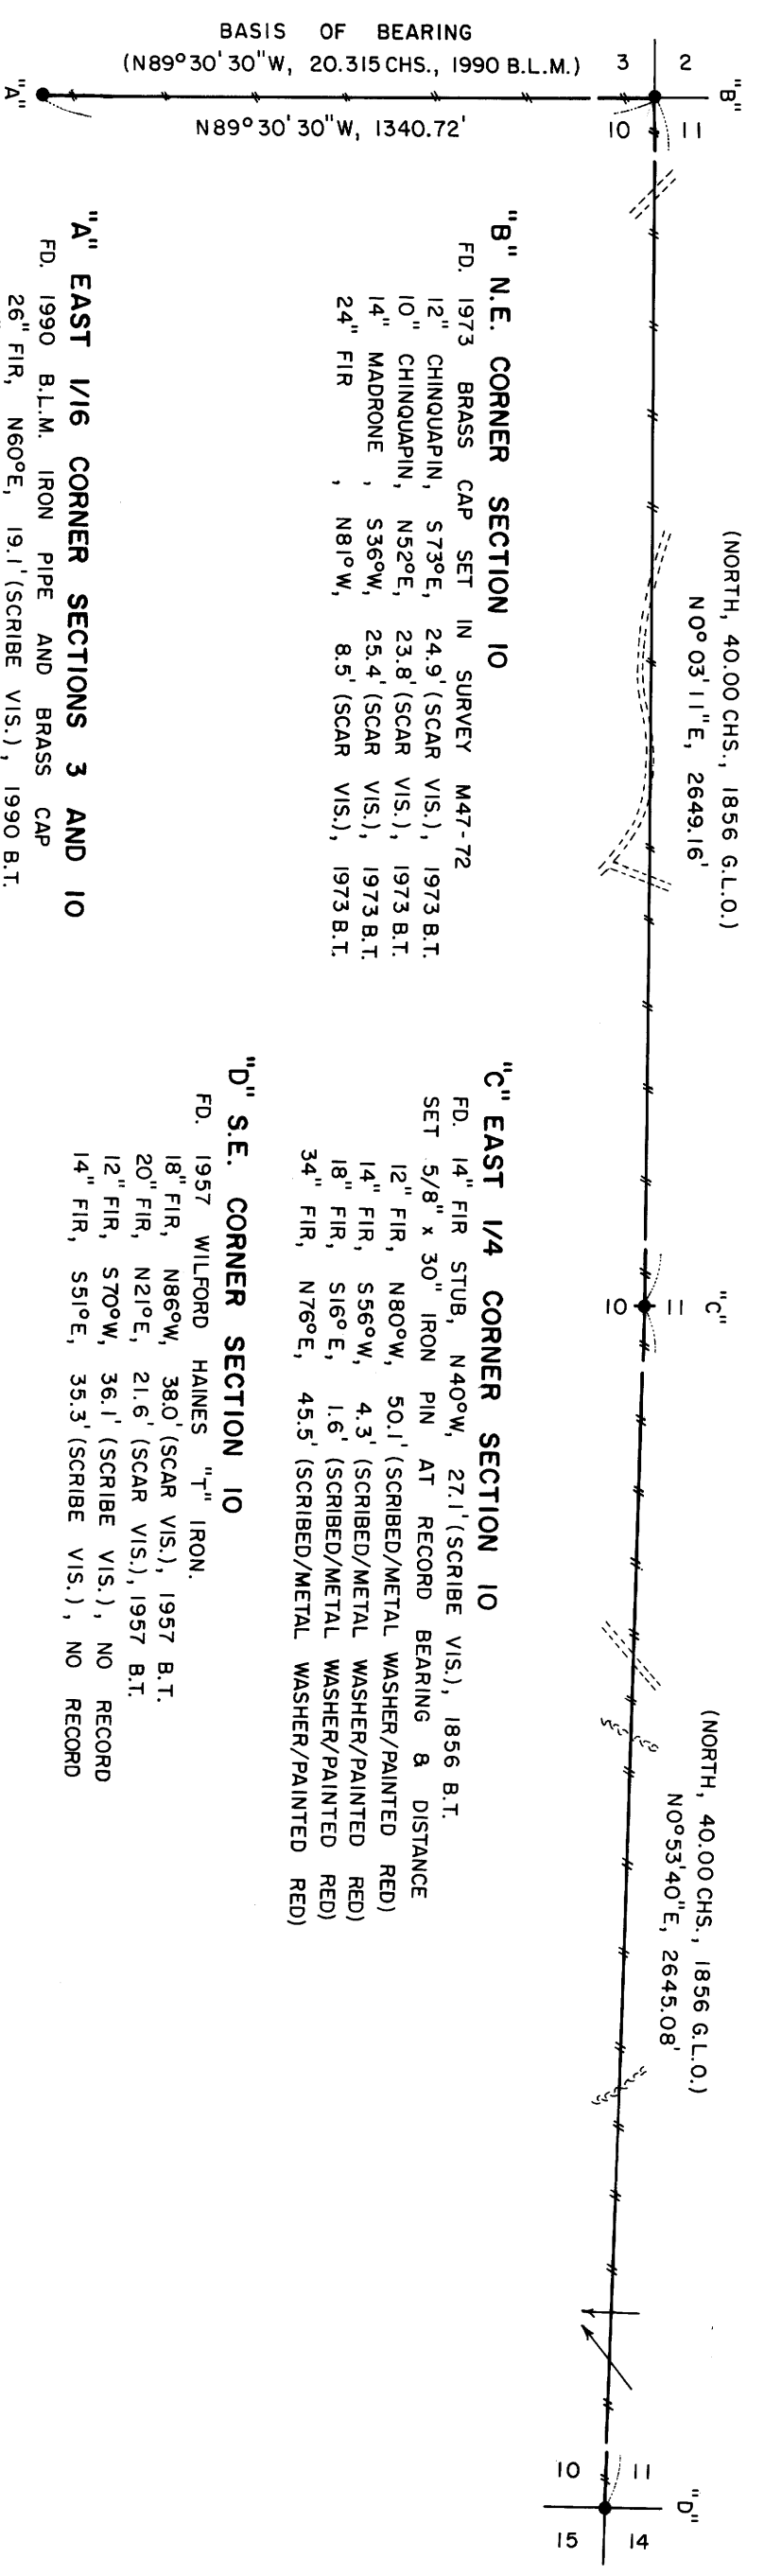

**"B" N.E. CORNER SECTION 10**  
FD. 1973 BRASS CAP SET IN SURVEY M47-72  
12" CHINGUAPIN, S73°E, 24.9' (SCAR VIS.), 1973 B.T.  
10" CHINGUAPIN, N52°E, 23.8' (SCAR VIS.), 1973 B.T.  
14" MADRONE, S36°W, 25.4' (SCAR VIS.), 1973 B.T.  
24" FIR, N81°W, 8.5' (SCAR VIS.), 1973 B.T.

**"C" EAST 1/4 CORNER SECTION 10**  
FD. 14" FIR STUB, N40°W, 27.1' (SCRIBE VIS.), 1856 B.T.  
SET 5/8" x 30" IRON PIN AT RECORD BEARING & DISTANCE  
12" FIR, N80°W, 50.1' (SCRIBED/METAL WASHER/PAINTED RED)  
14" FIR, S56°W, 4.3' (SCRIBED/METAL WASHER/PAINTED RED)  
18" FIR, S16°E, 1.6' (SCRIBED/METAL WASHER/PAINTED RED)  
34" FIR, N76°E, 45.5' (SCRIBED/METAL WASHER/PAINTED RED)

**"D" S.E. CORNER SECTION 10**  
FD. 1957 WILFORD HAINES "T" IRON.  
18" FIR, N86°W, 38.0' (SCAR VIS.), 1957 B.T.  
20" FIR, N21°E, 21.6' (SCAR VIS.), 1957 B.T.  
12" FIR, S70°W, 36.1' (SCRIBE VIS.), NO RECORD  
14" FIR, S51°E, 35.3' (SCRIBE VIS.), NO RECORD

**"A" EAST 1/16 CORNER SECTIONS 3 AND 10**  
FD. 1990 B.L.M. IRON PIPE AND BRASS CAP  
26" FIR, N60°E, 19.1' (SCRIBE VIS.), 1990 B.T.  
32" FIR, S28°W, 27.1' (SCRIBE VIS.), 1990 B.T.

COUNTY SUPERVISOR FOR DATA  
DO NOT REMOVE FROM FILE