


Date: 1-5-95 By: JP
This survey consists of:
Map: M 121-26
Narrative:
Corner Rpt: _____

DOUGLAS COUNTY SURVEYOR

WEST 1/6 CORNER SECTIONS 6 AND 31
FD. 1988 B.L.M. IRON PIPE AND BRASS CAP
8" FIR, S19°W, 20.5' (SCAR VIS.), 1988 B.T.
16" FIR, N07°E, 25.7' (SCAR VIS.), 1988 B.T.



NORTH 1/4 CORNER SECTION 6
FD. 1988 B.L.M. IRON PIPE AND BRASS CAP.
32" FIR, N24°W, 34.5' (SCAR VIS.), 1962 B.T. - GODFREY
26" FIR, S85°W, 29.8' (SCAR VIS.), ORIGIN UNKNOWN
8" FIR, N80°E, 7.0' (SCAR VIS.), 1988 B.T.

N.E. CORNER SECTION 6
FD. 1962 DOUGLAS COUNTY IRON PIPE & BRASS CAP
16" FIR STUMP, S32°E, 31.0' (NO MARKS), 1962 B.T. - GODFREY
18" WHITE FIR, N32°E, 18.0' (SCAR VIS.), 1962 B.T. - GODFREY
24" FIR, S17°W, 58.5' (SCAR VIS.), 1962 B.T. - GODFREY
26" FIR, N51°W, 15.0' (SCAR VIS.), 1962 B.T. - GODFREY
6" FIR, S57°E, 25.4' (SCAR VIS.), 1988 B.T.

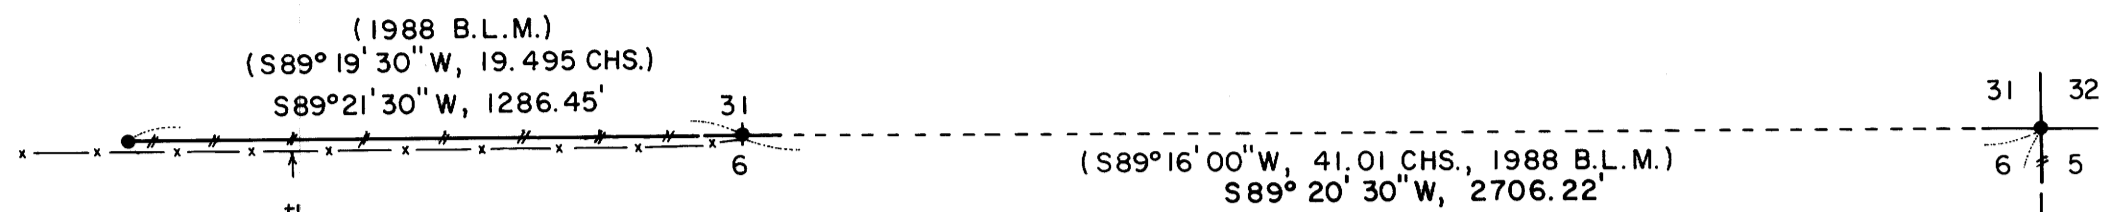

BOUNDARY SURVEY
FOR
SENECA JONES TIMBER COMPANY
IN
SECTION 6, T22S, R4W, W.M.
DOUGLAS COUNTY, OREGON
BY
ROBERTS SURVEYING INC.
29 WEST 29TH STREET
EUGENE, OREGON 97405
PHONE 345-1112


DECEMBER 16, 1994
SCALE 1" = 400'

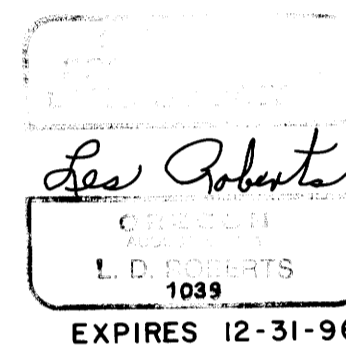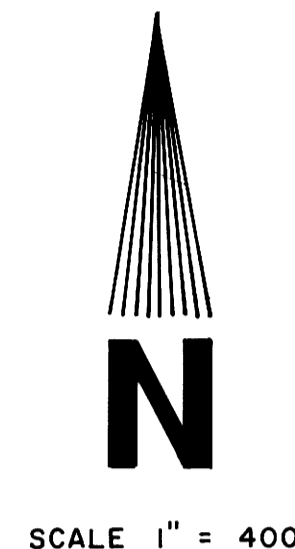

LEGEND,

- MONUMENTS FOUND AND USED FOR CONTROL
 - MONUMENTS SET, 5/8" x 30" IRON PINS WITH YELLOW PLASTIC CAPS. CAPS STAMPED "ROBERTS P.L.S. 1039"
 - () DATA OF RECORD, 1855 G.L.O. SURVEY, COUNTY SURVEY 4/221 AND 1988 B.L.M. SURVEY.
 - LINES BLAZED, PAINTED AND MARKED WITH RED METAL FENCE POSTS
- BASIS OF BEARING, SOUTH 1/2 OF EAST LINE SECTION 6 FROM 1855 G.L.O. SURVEY
- DISTANCES TO BEARING TREES ARE CENTER MEASURE
- ALL NEW B.T.'S ARE SCRIBED AND HAVE A METAL WASHER STAMPED "P.L.S. 1039" NAILED TO LOWER BLAZE. SCRIBED BLAZES ARE PAINTED RED.

EAST 1/4 CORNER SECTION 6
FD. 24" FIR STUMP, S75°W, 19.8' (SCRIBE VIS.), 1855 B.T.
24" FIR STUMP, N37°E, 29.0' (SCRIBE VIS.), 1855 B.T.
SET 5/8" x 30" IRON PIN WITH YELLOW PLASTIC CAP.
26" FIR, S85°W, 34.5' (SCAR VIS.), 1953 B.T. - GARDNER
36" I. CEDAR, S70°E, 30.3' (SCAR VIS.), 1953 B.T. - GARDNER

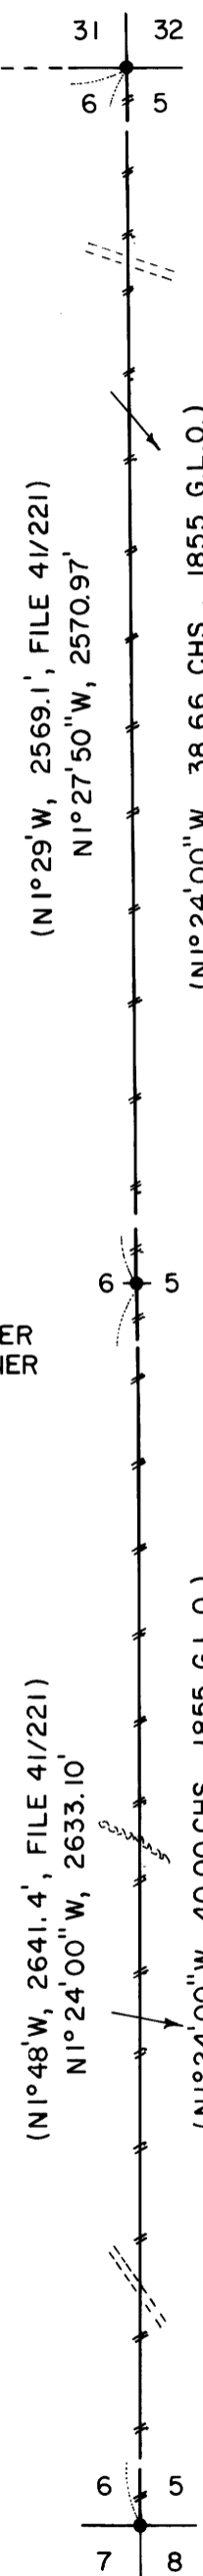

NARRATIVE, THE PURPOSE OF THIS SURVEY IS TO BLAZE AND POST THE EAST LINE OF SECTION 6, T22S, R4W, W.M. ALSO TO BLAZE AND POST THE EAST 1/2 OF THE WEST 1/2 OF THE NORTH LINE OF SAID SECTION 6. THE S.E. SECTION CORNER, THE EAST 1/4 CORNER, THE N.E. SECTION CORNER, THE NORTH 1/4 CORNER AND THE WEST 1/6 CORNER WERE FOUND IN THE FIELD AND USED AS CONTROL FOR THIS SURVEY. A CLOSED RANDOM PROPERTY LINE TRAVERSE, USING A WILD T-16 THEODOLITE AND A DI-4L E.D.M., WAS RUN ALONG THE PROPERTY LINES TO BE BLAZED AND POSTED. OFFSETS WERE COMPUTED FROM THIS PROPERTY LINE TRAVERSE TO THE TRUE PROPERTY LINE. PROPERTY LINES WERE MARKED WITH RED PAINTED BLAZES, RED RIBBON AND RED METAL FENCE POSTS. NOTE, AN OLD WIRE FENCE IS LOCATED 20' SOUTH, MORE OR LESS, OF THE NORTH LINE OF SECTION 6 AS SHOWN HEREON.

S.E. CORNER SECTION 6
FD. 1962 DOUGLAS COUNTY IRON PIPE & BRASS CAP
36" FIR STUMP, WEST, 21.5' (NO MARKS), 1855 B.T.
36" FIR STUMP, S81°E, 22.6' (SCAR VIS.), 1855 B.T.
22" FIR, S19°E, 34.5' (SCAR VIS.), 1962 B.T.
22" WHITE FIR, S10°W, 80.4' (SCAR VIS.), 1962 B.T.
28" FIR STUMP, N16°E, 35.5' (NO MARKS), 1962 B.T.

COUNTY SURVEYORS FILE DATA
DO NOT REMOVE FROM OFFICE