

Date: 1-5-95 By: MP
This survey consists of
Map: M 121-27
Narrative:
Corner Rpt:

DOUGLAS COUNTY
SURVEYOR JC

MAP FILE M 121-27



N.W. CORNER SECTION 6
FD. 1986 B.L.M. IRON PIPE AND BRASS CAP
28" FIR SNAG, N59°E, 37.0' (SCRIBE VIS.), 1855 B.T.
FD. 1966 DOUGLAS COUNTY BRASS CAP 0.55', SOUTH
OF 1986 B.L.M. IRON PIPE AND BRASS CAP
14" HEMLOCK, N26°W, 13.2' (SCAR VIS.), 1966 B.T.
15" HEMLOCK, N80°E, 25.0' (SCAR VIS.), 1966 B.T.
30" CEDAR, S61°E, 30.0' (SCAR VIS.), 1966 B.T.

N.E. CORNER SECTION 6
FD. 1961 DOUGLAS COUNTY BRASS CAP
44" FIR, S33°E, 34.9' (SCAR VIS.), 1855 B.T.
80" FIR STUMP, N56°E, 13.0' (NO MARKS), 1855 B.T.
12" HEMLOCK, N20°E, 20.3' (SCAR VIS.), 1961 B.T.
24" HEMLOCK, S49°W, 28.7' (SCAR VIS.), 1961 B.T.
38" CEDAR, N69°W, 17.4' (SCAR VIS.), 1961 B.T.
44" FIR, S33°E, 34.9' (SCAR VIS.), 1961 B.T.


EAST 1/4 CORNER SECTION 6
SET 5/8" x 30" IRON PIN WITH YELLOW PLASTIC CAP
6" FIR, S61°W, 16.1' (SCRIBED/WASHER/PAINTED RED)
6" FIR, S01°E, 20.5' (SCRIBED/WASHER/PAINTED RED)
6" FIR, N54°W, 10.9' (SCRIBED/WASHER/PAINTED RED)
8" FIR, N49°E, 27.7' (SCRIBED/WASHER/PAINTED RED)

WEST 1/4 CORNER SECTION 6
FD. HAINES "T" IRON SET IN SURVEY M3-22
18" FIR SNAG, S87°W, 15.0' (SCRIBE VIS.), 1855 B.T.
24" CEDAR STUMP, N84°E, 14.0' (NO MARKS), 1855 B.T.
24" FIR STUMP, N60°W, 73.0' (SCAR VIS.), 1956 B.T.

S.W. CORNER SECTION 6
FD. HAINES "T" IRON SET IN SURVEY M3-22
24" FIR, N17°W, 21.5' (SCAR VIS.), 1956 B.T.
36" FIR, S43°E, 51.5' (SCAR VIS.), 1956 B.T.
40" FIR, S06°E, 45.7' (SCAR VIS.), 1956 B.T.

SOUTH 1/4 CORNER SECTION 6
SET 5/8" x 30" IRON PIN WITH YELLOW PLASTIC CAP
10" MAPLE, N32°E, 19.0' (SCRIBED/WASHER/PAINTED RED)
12" HEMLOCK, SOUTH, 22.6' (SCRIBED/WASHER/PAINTED RED)
14" MAPLE, N88°W, 23.1' (SCRIBED/WASHER/PAINTED RED)
24" HEMLOCK, S72°W, 29.9' (SCRIBED/WASHER/PAINTED RED)

S.E. CORNER SECTION 6
FD. 1961 DOUGLAS COUNTY IRON PIPE & BRASS CAP
18" FIR SNAG, N63°E, 23.5' (SCRIBE VIS.), 1855 B.T.
26" FIR, S23°E, 11.5' (SCAR VIS.), 1855 B.T.
26" FIR SNAG, N41°E, 21.1' (SCAR VIS.), 1961 B.T.
12" FIR, N61°W, 18.5' (SCAR VIS.), 1986 B.T.
SET 12" FIR, N61°W, 18.5' (SCRIBED/WASHER/PAINTED RED)
14" FIR, N35°E, 29.8' (SCRIBED/WASHER/PAINTED RED)
18" FIR, S59°W, 32.8' (SCRIBED/WASHER/PAINTED RED)

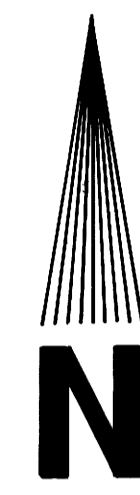

SCALE 1" = 400'

**BOUNDARY SURVEY
FOR
SENECA JONES TIMBER COMPANY
IN
SECTION 6, T22S, R6W, W.M.
DOUGLAS COUNTY, OREGON
BY
ROBERTS SURVEYING INC.
29 WEST 29TH STREET
EUGENE, OREGON 97405
PHONE 345-1112**

NOVEMBER 26, 1994
SCALE 1" = 400'

LEGEND,

- MONUMENTS FOUND AND USED FOR CONTROL
 - MONUMENTS SET, 5/8" x 30" IRON PINS WITH YELLOW PLASTIC CAPS. CAPS STAMPED "ROBERTS P.L.S. 1039"
 - () DATA OF RECORD, 1855 G.L.O. SURVEY, COUNTY SURVEY M3-22 AND COUNTY SURVEY M102-29.
 - — — LINES BLAZED AND PAINTED THIS SURVEY
- BASIS OF BEARING, EAST LINE SECTION 6 FROM 1855 G.L.O. SURVEY
- DISTANCES TO BEARING TREES ARE CENTER MEASURE
- ALL NEW B.T.'S ARE SCRIBED AND HAVE A METAL WASHER STAMPED "P.L.S. 1039" NAILED TO LOWER BLAZE. SCRIBED BLAZES ARE PAINTED RED.

NARRATIVE, THE PURPOSE OF THIS SURVEY IS TO POST AND BLAZE THE EAST, SOUTH AND WEST BOUNDARIES OF SECTION 6, T22S, R6W, W.M. ALSO TO SET THE EAST AND SOUTH 1/4 CORNERS OF SECTION 6, IF NO ORIGINAL EVIDENCE OF THESE CORNERS CAN BE FOUND IN THE FIELD. THE N.E. SECTION CORNER, THE S.E. SECTION CORNER, THE S.W. SECTION CORNER, THE WEST 1/4 CORNER AND THE N.W. SECTION CORNER WERE FOUND IN THE FIELD AND USED AS CONTROL FOR THIS SURVEY. A CLOSED RANDOM E.D.M. CONTROL TRAVERSE, USING A WILD T-16 THEODOLITE AND A DI-4L E.D.M., WAS RUN BETWEEN THE N.E. AND N.W. SECTION CORNERS. A CLOSED RANDOM PROPERTY LINE TRAVERSE, USING A WILD T-16 THEODOLITE AND A DI-4L E.D.M., WAS RUN ALONG THE EAST, SOUTH AND WEST BOUNDARIES OF SECTION 6. OFFSETS WERE COMPUTED FROM THIS PROPERTY LINE TRAVERSE TO THE TRUE PROPERTY LINE. PROPERTY LINES WERE MARKED WITH RED PAINTED BLAZES, RED RIBBON AND RED METAL FENCE POSTS. THE EAST 1/4 CORNER WAS SET BY SINGLE PROPORTIONATE MEASURE BETWEEN THE FOUND N.E. AND S.E. SECTION CORNERS. THE SOUTH 1/4 CORNER WAS SET BY SINGLE PROPORTIONATE MEASURE BETWEEN THE FOUND S.E. AND S.W. SECTION CORNERS.

Les Roberts
1039
EXPIRES 12-31-96

**DOUGLAS COUNTY SURVEYORS FILE DATA
DO NOT REMOVE FROM OFFICE**

MAP FILE M 121-27