

PROPERTY SURVEY LOCATED IN THE N.W. 1/4 OF SECTION 19, T.22S., R.7W., W.M., DOUGLAS COUNTY, OREGON

FILED

Date: 2-6-95 By: AP
This survey consists of:
Map: M121-42
Narrative: _____
Corner Plat: _____

FOR: GEORGE M'FEELY &
KAREN (BURKS) M'FEELY
712 SCHAD RD.
ELKTON, OR. 97436


BY: ROBERT L. DOLAN
3614 NONPAREIL RD.
SUTHERLIN, OR. 97479

DATE: DECEMBER 1994

SCALE: 1" = 50'

- Legend:**
- ⊙ FD. BRASS CAP
SW COR. D.L.C. #1
 - FD. 5/8" IRON ROD OR AS NOTED
 - SET 5/8" x 30" IRON ROD W/CAP (LS 076)
 - (REC.) RECORD DATA AS PER M99-31 OR AS NOTED
 - [REC.] RECORD DATA AS PER DOUGLAS COUNTY DEED RECORDS B.1265 P.526 93-23121

DOUGLAS COUNTY
3C SURVEYOR 3C

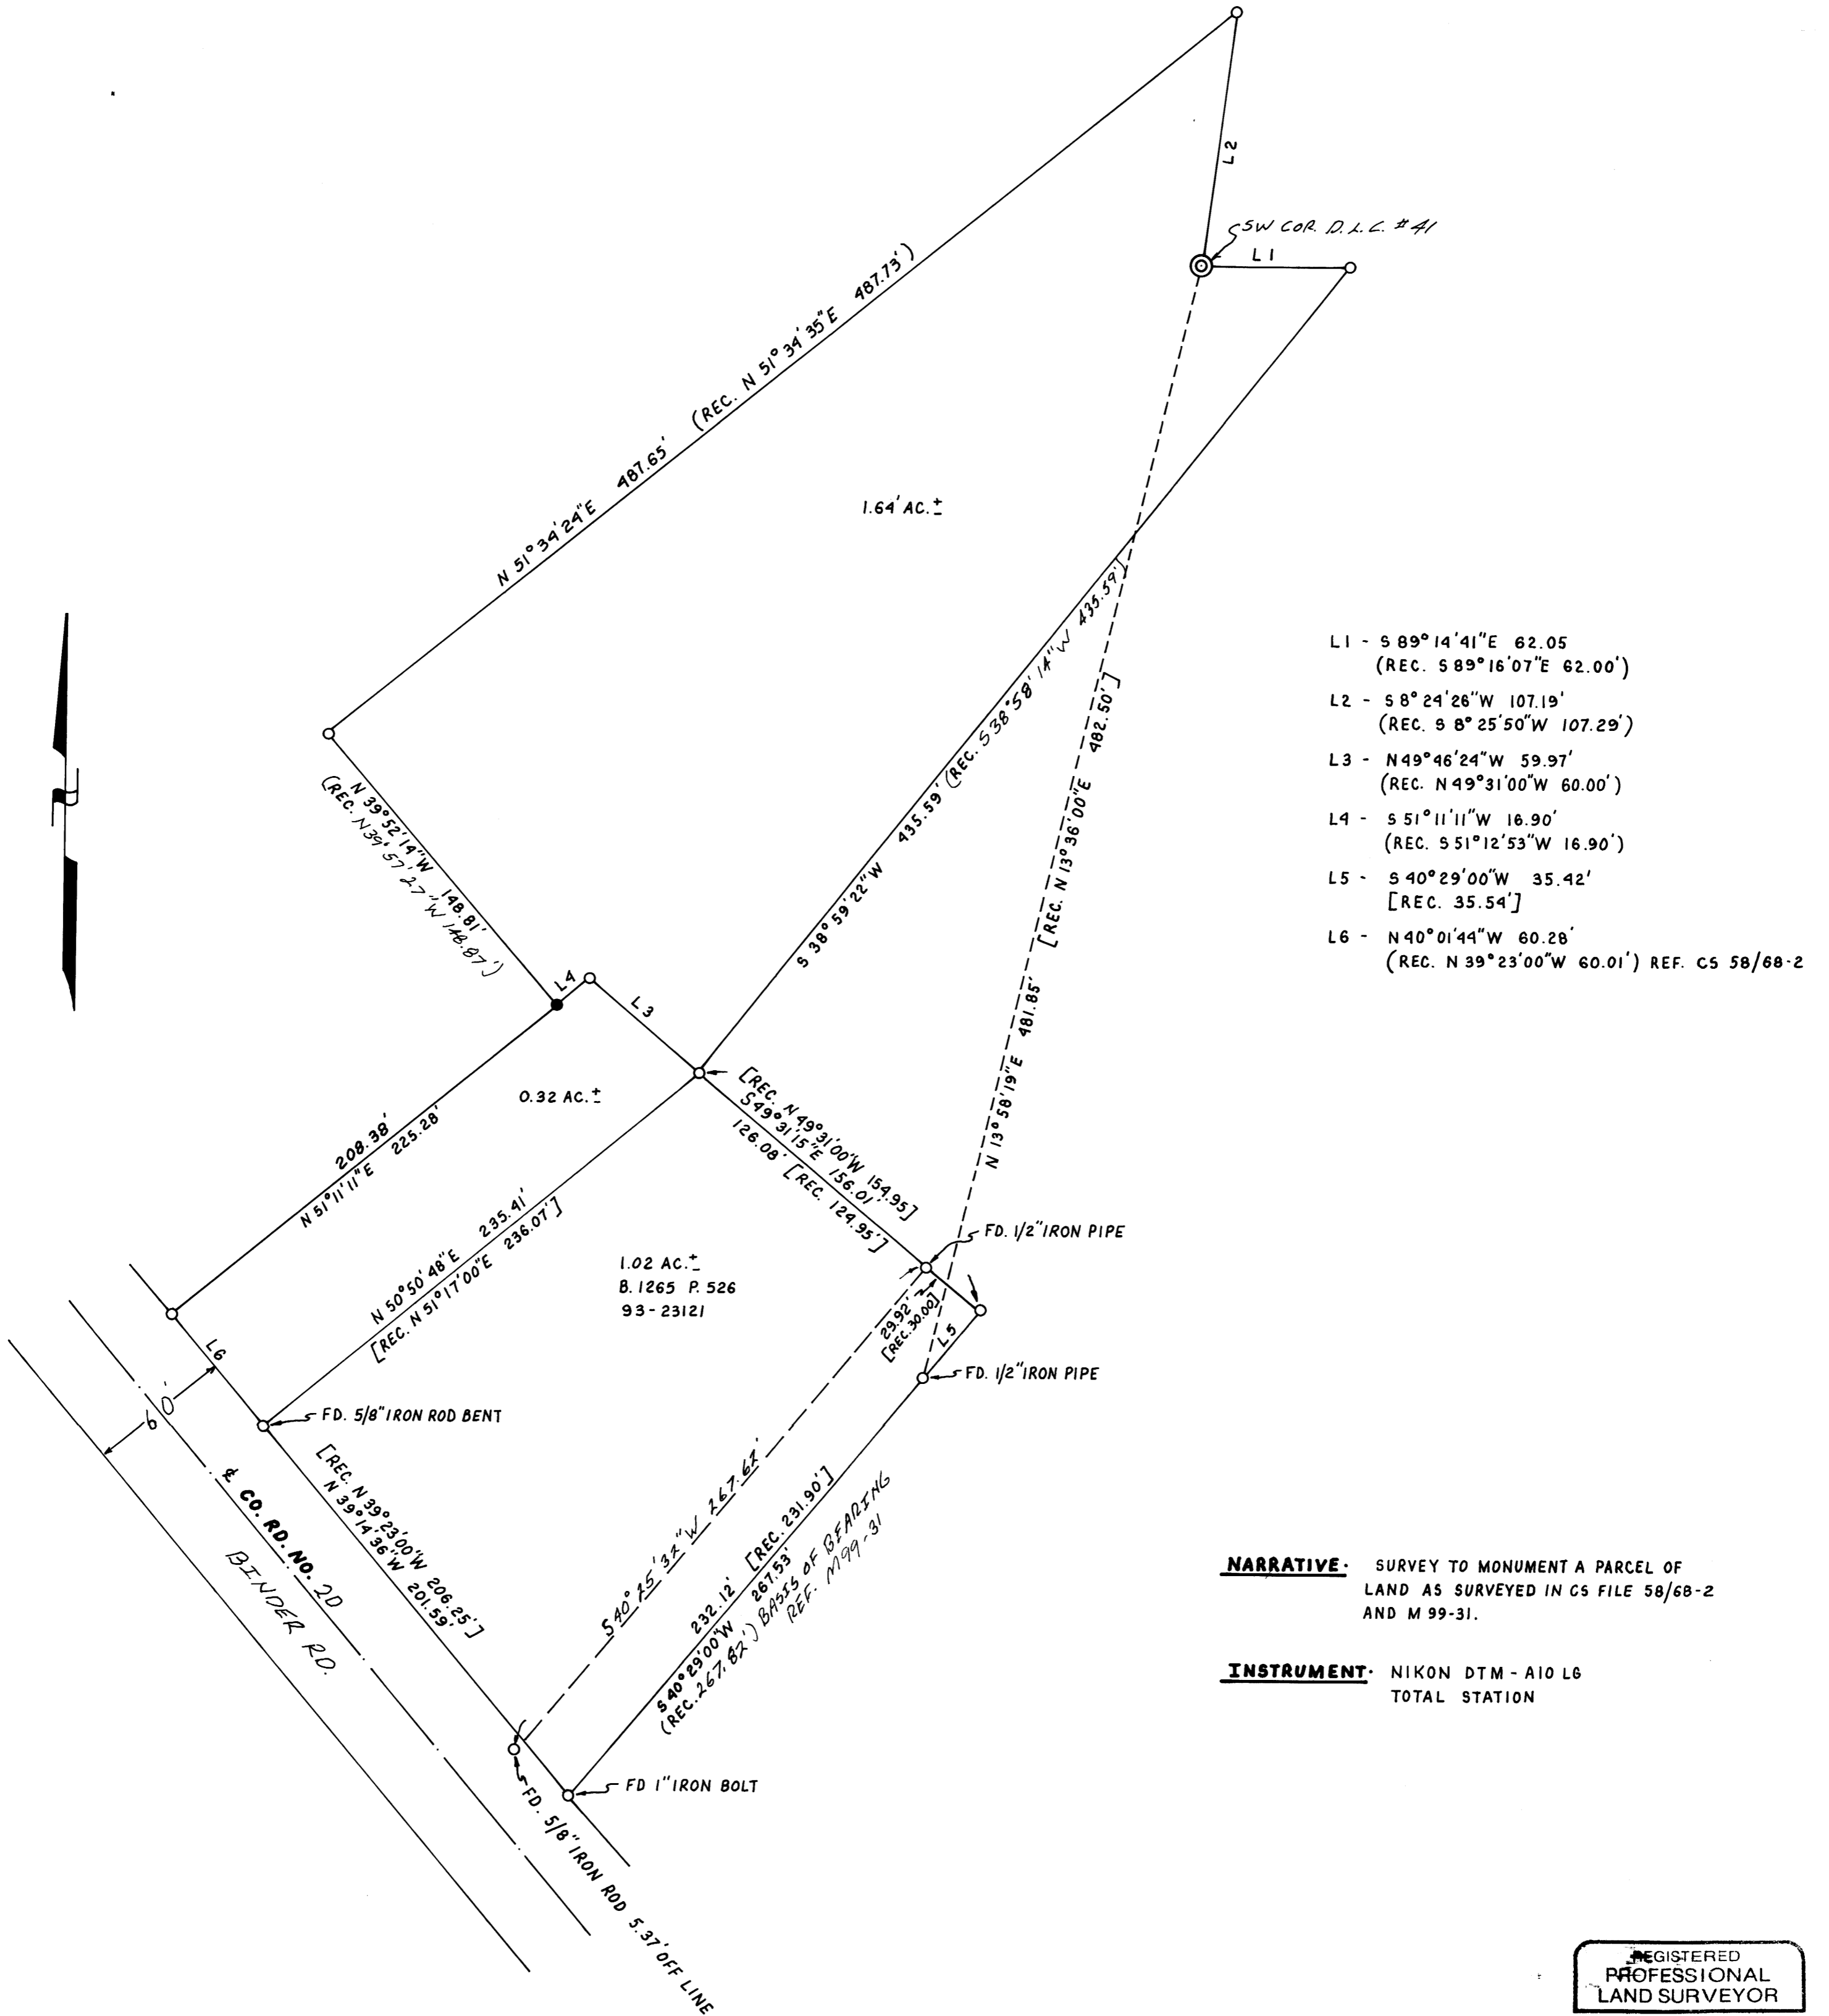

- L1 - S 89° 14' 41" E 62.05'
(REC. S 89° 16' 07" E 62.00')
- L2 - S 8° 24' 26" W 107.19'
(REC. S 8° 25' 50" W 107.29')
- L3 - N 49° 46' 24" W 59.97'
(REC. N 49° 31' 00" W 60.00')
- L4 - S 51° 11' 11" W 16.90'
(REC. S 51° 12' 53" W 16.90')
- L5 - S 40° 29' 00" W 35.42'
[REC. 35.54']
- L6 - N 40° 01' 44" W 60.28'
(REC. N 39° 23' 00" W 60.01') REF. CS 58/68-2

NARRATIVE: SURVEY TO MONUMENT A PARCEL OF LAND AS SURVEYED IN CS FILE 58/68-2 AND M 99-31.

INSTRUMENT: NIKON DTM-A10 L6
TOTAL STATION

COUNTY SURVEYORS FILE DATA
DO NOT REMOVE FROM OFFICE

REGISTERED
PROFESSIONAL
LAND SURVEYOR

Robert L. Dolan

OREGON
July 30, 1976
ROBERT L. DOLAN
1076

EXP. 12-31-95