
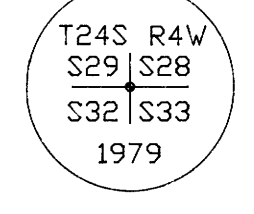
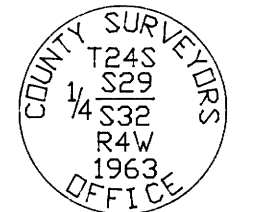
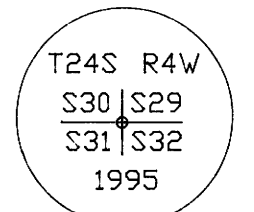
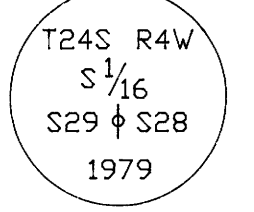
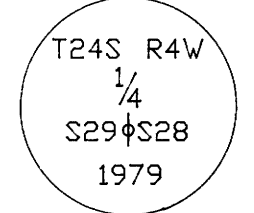
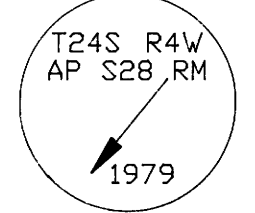
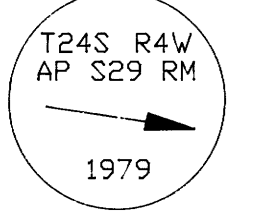
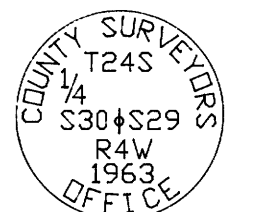
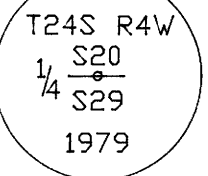


Date: 2-26-96 By: JC
This survey consists of:
Map: M 123-36
Narrative:
Corner Rpt:


DOUGLAS COUNTY, OREGON
SURVEYOR

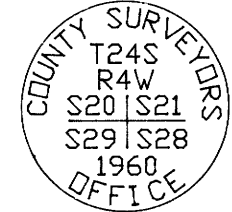

CORNER NOTES

- (1) SECTION CORNER 20-21/29-28
FOUND: 1960 D C S O 2.5' B.C.
BTS: 15' D. FIR N80°E 8.7 FT. HEALED FACE
10' DAK S27°E 16.8 FT. HEALED FACE
8' DAK S35°W 13.4 FT. HEALED FACE
12' DAK N39°W 12.1 FT. HEALED FACE
- (2) E 1/16 SECTIONS 20/29
FOUND: 5/8" REBAR /W YPC "AA SURVEYING"
BTS: 12" D. FIR N07°E 26.4 FT. OPEN FACE SCRIBING VISIBLE
16" D. FIR S66°E 10.2 FT. OPEN FACE SCRIBING VISIBLE
- (3) 1/4 CORNER SECTIONS 20/29
FOUND: 1979 BLM 3" B.C.
BTS: 13" W. DAK N43°E 55.6 FT. HEALED FACE
13" W. DAK S54°W 33.0 FT. HEALED FACE
- (4) CN 1/16 SECTION 29
FOUND: 5/8" REBAR W/YPC "AA SURVEYING"
BTS: 19" D. FIR S68°W 16.2 FT. OPEN FACE
15" D. FIR S74°E 11.2 FT. OPEN FACE
- (5) N 1/16 SECTIONS 30-29
FOUND: 5/8" REBAR /W YPC "AA SURVEYING INC."
BEARING OBJECTS NOT TIED
- (6) 1/4 CORNER SECTIONS 30-29
FOUND: 1963 COUNTY SURVEYORS OFFICE 2 1/2' B.C.
BTS: NOT TIED
- (7) C 1/4 CORNER SECTION 29
CALCULATED POSITION ONLY, NO MONUMENT SET
- (8) CE 1/16 SECTION 29
SET: 5/8" X 30" REBAR W/YPC "L.S. #2603" 4" ABOVE GROUND
BTS: 16" D. FIR S62°E 15.7 FT. BLAZED SCRIBED "CE1/16 S29 BT"
15" D. FIR N21°W 18.2 FT.
- (9) AP BLM BC SECTION 29
FOUND: 1979 BLM 3" B.C. S75°30'E 11.2 FT.
- (9A) AP BLM BC SECTION 28
FOUND: 1979 BLM 3" B.C. S38°15'W 16.5 FT.
- (10) LINE TREE SECTION 29-28
FOUND: 56" D. FIR SNAG W/BARK BLAZE ON NORTH FACE,
BARK BLAZE ON SOUTH SIDE ON GROUND.
- (11) 1/4 CORNER SECTIONS 29-28
FOUND: 1979 BLM 3" B.C.
BTS: 10" D. FIR N26°W, 24.0 FT. HEALED FACE
14" D. FIR S41°E, 22.8 FT. HEALED FACE
- (12) S 1/16 SECTIONS 29-28
FOUND: 1979 BLM 3" B.C.
BTS: 22" D. FIR S81°W, 14.3 FT. HEALED FACE
14" D. FIR N78°E, 23.9 FT. HEALED FACE
- (13) SE 1/16 SECTION 29
SET: 5/8" X 30" REBAR W/YPC "L.S. #2603" 4" ABOVE GROUND
BTS: 6" D. FIR N81°W 12.2 FT. BLAZED & SCRIBED "SE 1/16 S29 BT"
12" D. FIR N03°E 8.6 FT.
FOUND: 36" D. FIR N02°E 56.2 FT. HEALED FACE, NOT OF RECORD
30" D. FIR N37°E 78.5 FT.
- (14) CS 1/16 SECTION 29
SET: 5/8" X 30" REBAR W/YPC "L.S. #2603" 4" ABOVE GROUND
BTS: 12" B. DAK N01°E 24.6 FT. BLAZED & SCRIBED "CS 1/16 S29 BT"
13" B. DAK S71°W 36.1 FT.
- (15) S 1/16 SECTIONS 30-29
SET: 5/8" X 30" REBAR W/YPC "L.S. #2603" 4" ABOVE GROUND
BTS: FALLS IN BPA N-S POWER R/W. BEARING OBJECT
12"x12"x4.5' FENCE POST N36°E 7.1 FT. FENCE RUNS N, S & E
- (16) SECTION CORNER 30-29/31-32
FOUND: 1979 2 1/2' B.C. MISSING, RESET BY D C S O
BTS: 12" D. FIR STUMP N59°E, 162 FT. HEALED BLAZE
12" MADRONE S83°E, 105.4 FT. HEALED BLAZE
15" D. FIR STUMP N73°W 82.6 FT. HEALED BLAZE
- (17) 1/4 CORNER SECTIONS 29/32
FOUND: 1963 D C S O 3" B.C.
BTS: NOT TIED
- (18) E 1/16 SECTION 29/32
FOUND: BLM 3" B.C.
BTS: 14" W. DAK S09°E, 21.2 FT. HEALED FACE
10" W. DAK N16°E, 4.1 FT. HEALED FACE
- (19) SECTION CORNER 29-28/32-33
FOUND: D C S O 2.5' B.C.
BTS: NOT TIED
- (20) SW 1/16 SECTION 29
SET: 5/8" X 30" REBAR W/YPC "L.S. #2603" 4" ABOVE GROUND
BTS: 9" B. DAK N50°W 21.2 FT. BLAZED & SCRIBED "SW 1/16 S29 BT"
6" B. DAK N19°E 23.2 FT.
- (21) CW 1/16 SECTION 29
CALCULATED POSITION ONLY, NO MONUMENT SET
- (22) W 1/16 SECTION 29-32
CALCULATED POSITION ONLY, NO MONUMENT SET

**SURVEY FOR
ROSBORO LUMBER CO.
SECTION 29, TOWNSHIP 24 SOUTH, RANGE 4 WEST, W.M..
DOUGLAS COUNTY, OREGON
JANUARY 23, 1996**

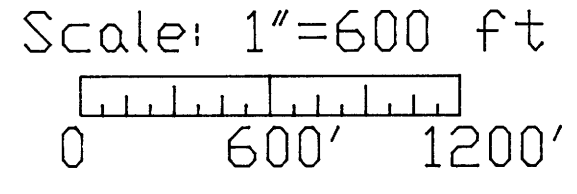

NARRATIVE

THE PURPOSE OF THIS SURVEY WAS TO MONUMENT THE PROPERTY LINES (BLAZED, PAINTED AND POSTED) FOR ROSBORO LUMBER COMPANY. CORNER MONUMENTS EXISTING IN THIS SECTION WERE HELD AS FOUND.

ALL CORNERS SET IN THIS SURVEY WERE SET IN ACCORDANCE WITH THE BLM MANUAL OF SURVEYING INSTRUCTIONS 1973. BASIS OF BEARING FOR THIS SURVEY IS THE WEST LINE OF SECTION 29 BETWEEN THE W 1/4 AND THE N 1/16 AS PER CS #M116-18.


THIS SURVEY WAS PERFORMED USING A NIKON A20LG DTM - TOTAL STATION TO MEASURE ANGLES AND DISTANCES. BEARING TREES REFERENCED ON THIS SURVEY WERE MEASURED WITH A 50' DIAMETER TAPE TO THE SIDE CENTER AND HAND COMPASS TO THE CENTER.

MEASUREMENTS OF RECORD AS NOTED
() = CS #M116 - 18
[] = 1981 BLM DEPENDENT RESURVEY
NOTE: BLM RESURVEY HAS APPROX. ONE CHAIN ERROR IN CLOSING

REGISTERED PROFESSIONAL LAND SURVEYOR

Harvey M. Christensen
OREGON
MARCH 16, 1993
HARVEY M. CHRISTENSEN
2603

LICENSE RENEWAL DATE DECEMBER 31, 1997

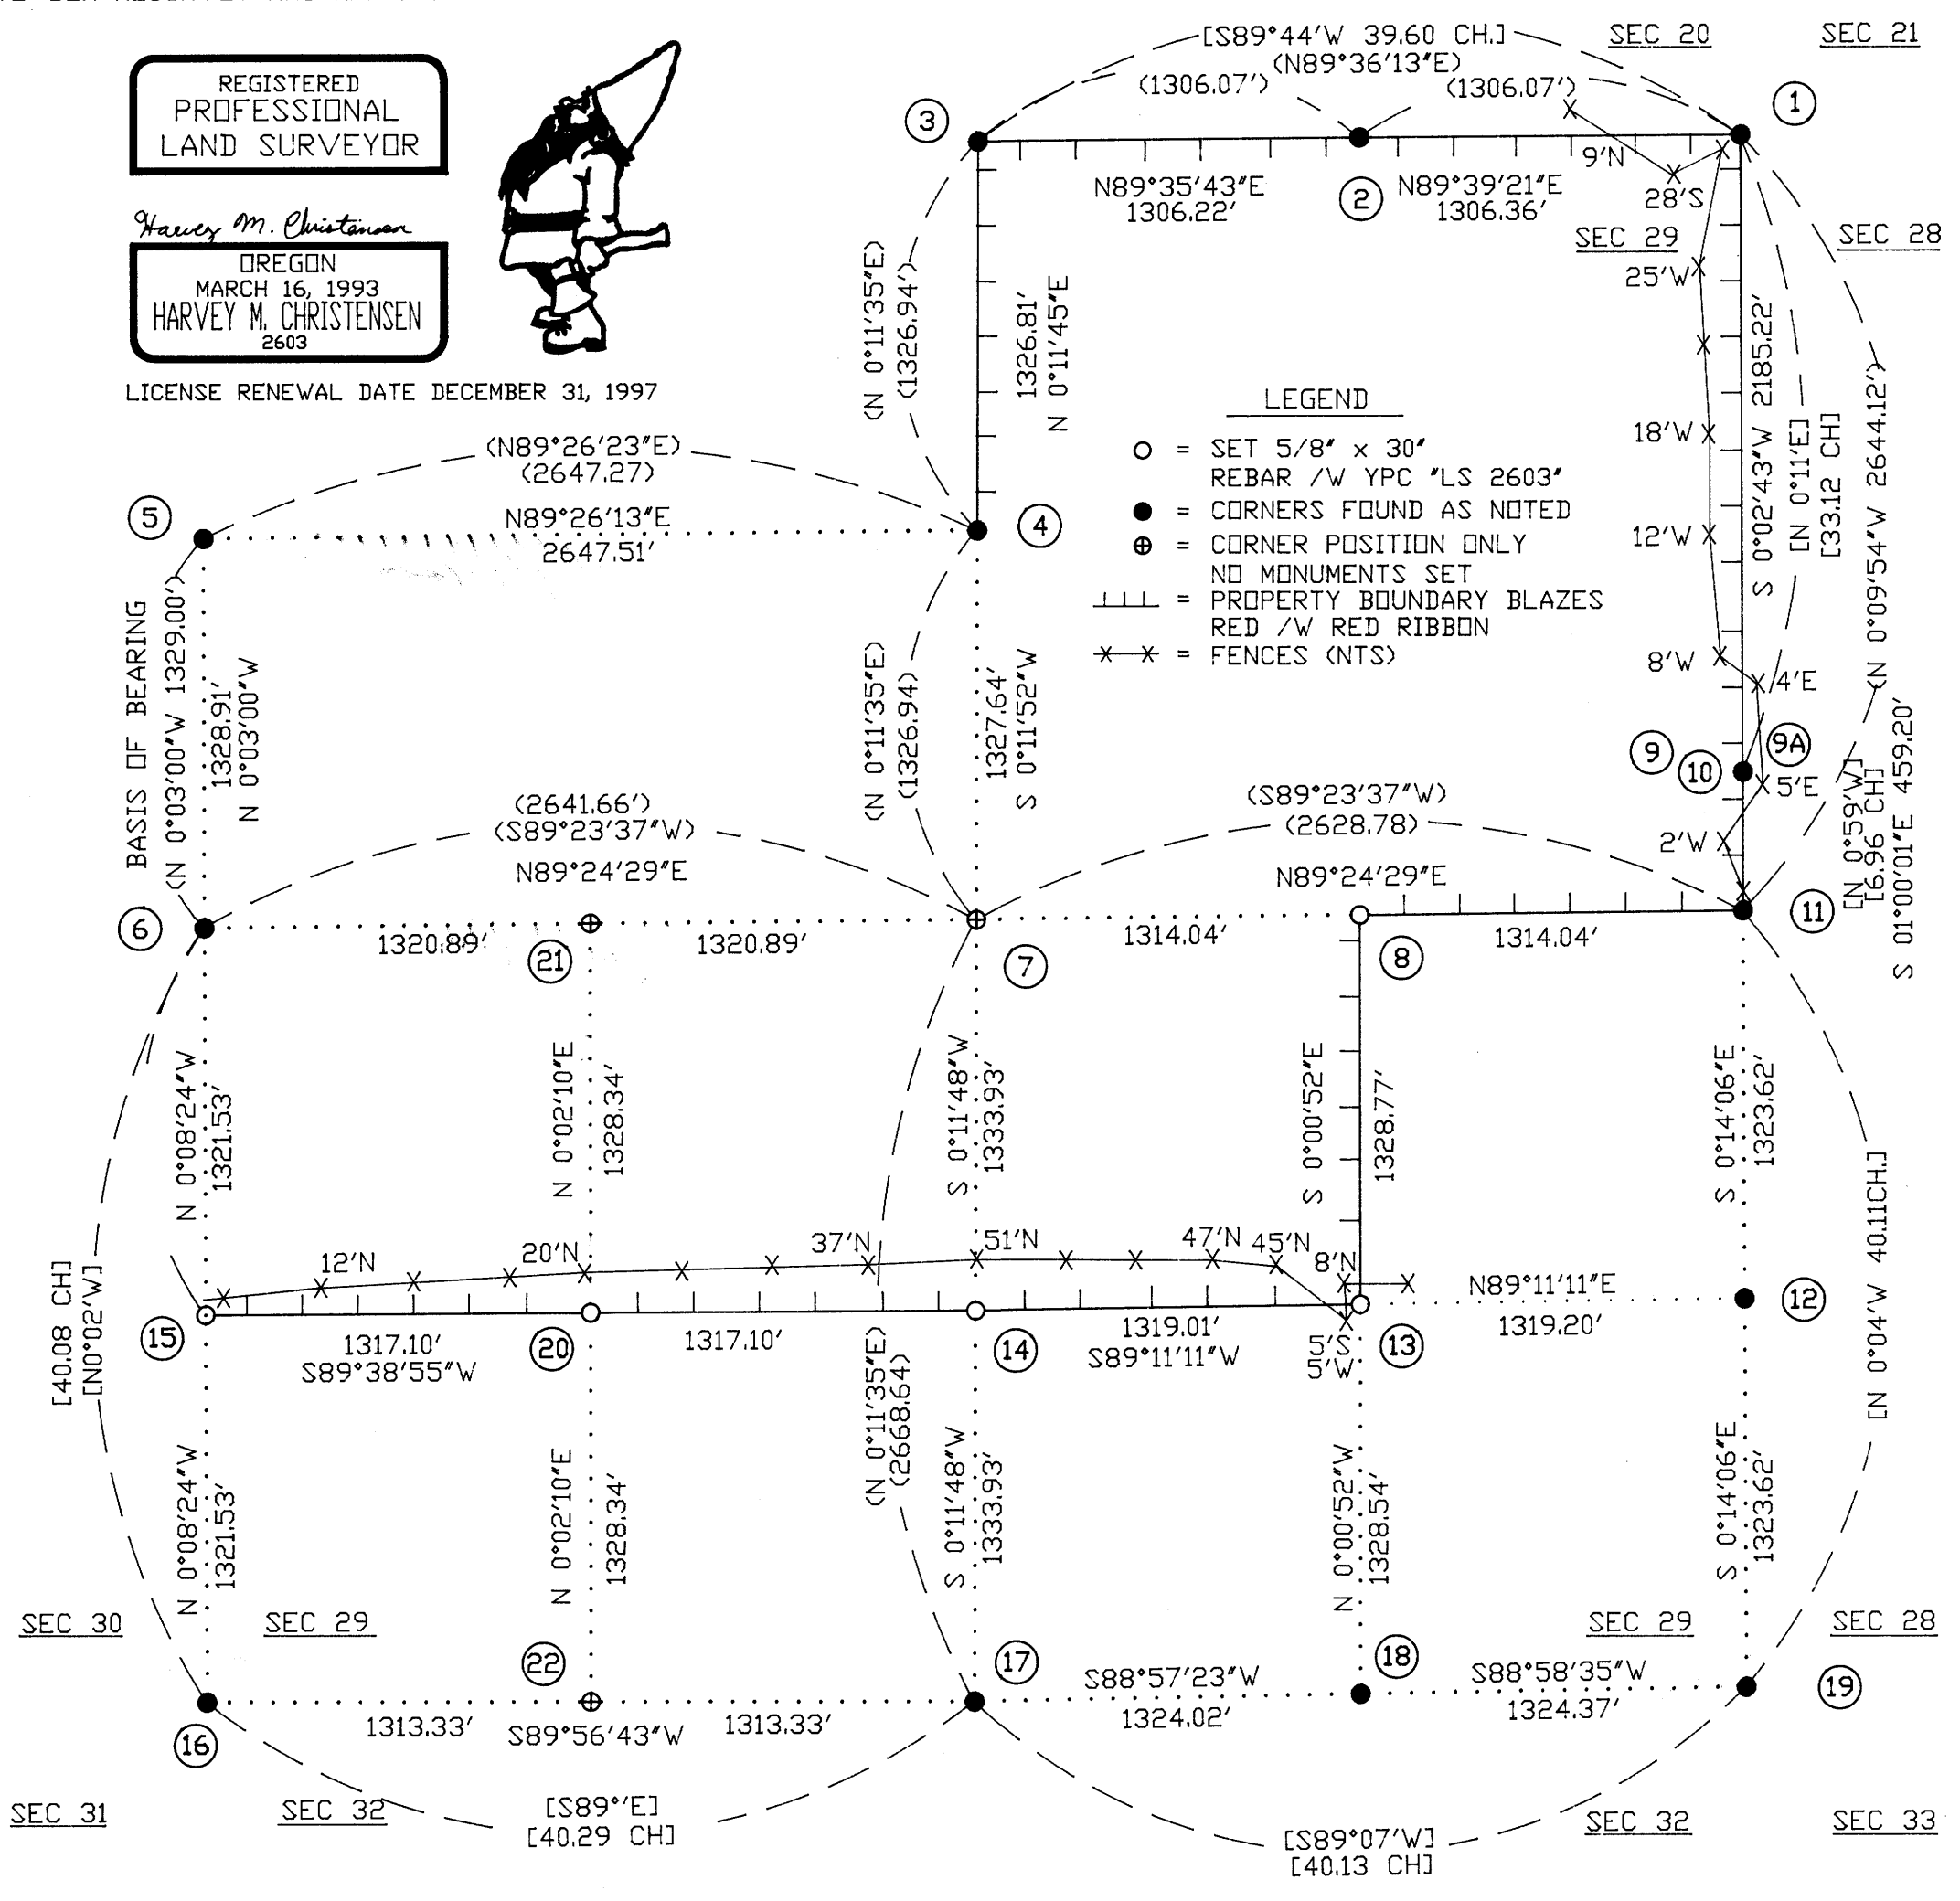

NORTHWEST TIMBERLAND CONSULTING, INC.
4680 BRIARS - EUGENE, OR 97404-1113
PHONE (503) 461-4076

COUNTY SURVEYORS FILE DATA
DO NOT REMOVE FROM OFFICE