



RECORD OF SURVEY
 FOR: TAHKENITCH TREE FARMS
 IN: NW 1/4, SEC. 12, T.20S.,R.12W., W.M.
 DOUGLAS COUNTY, OREGON
 JUNE 3, 1996

APPROXIMATE
 SHORELINE
 SILTCOOS LAKE

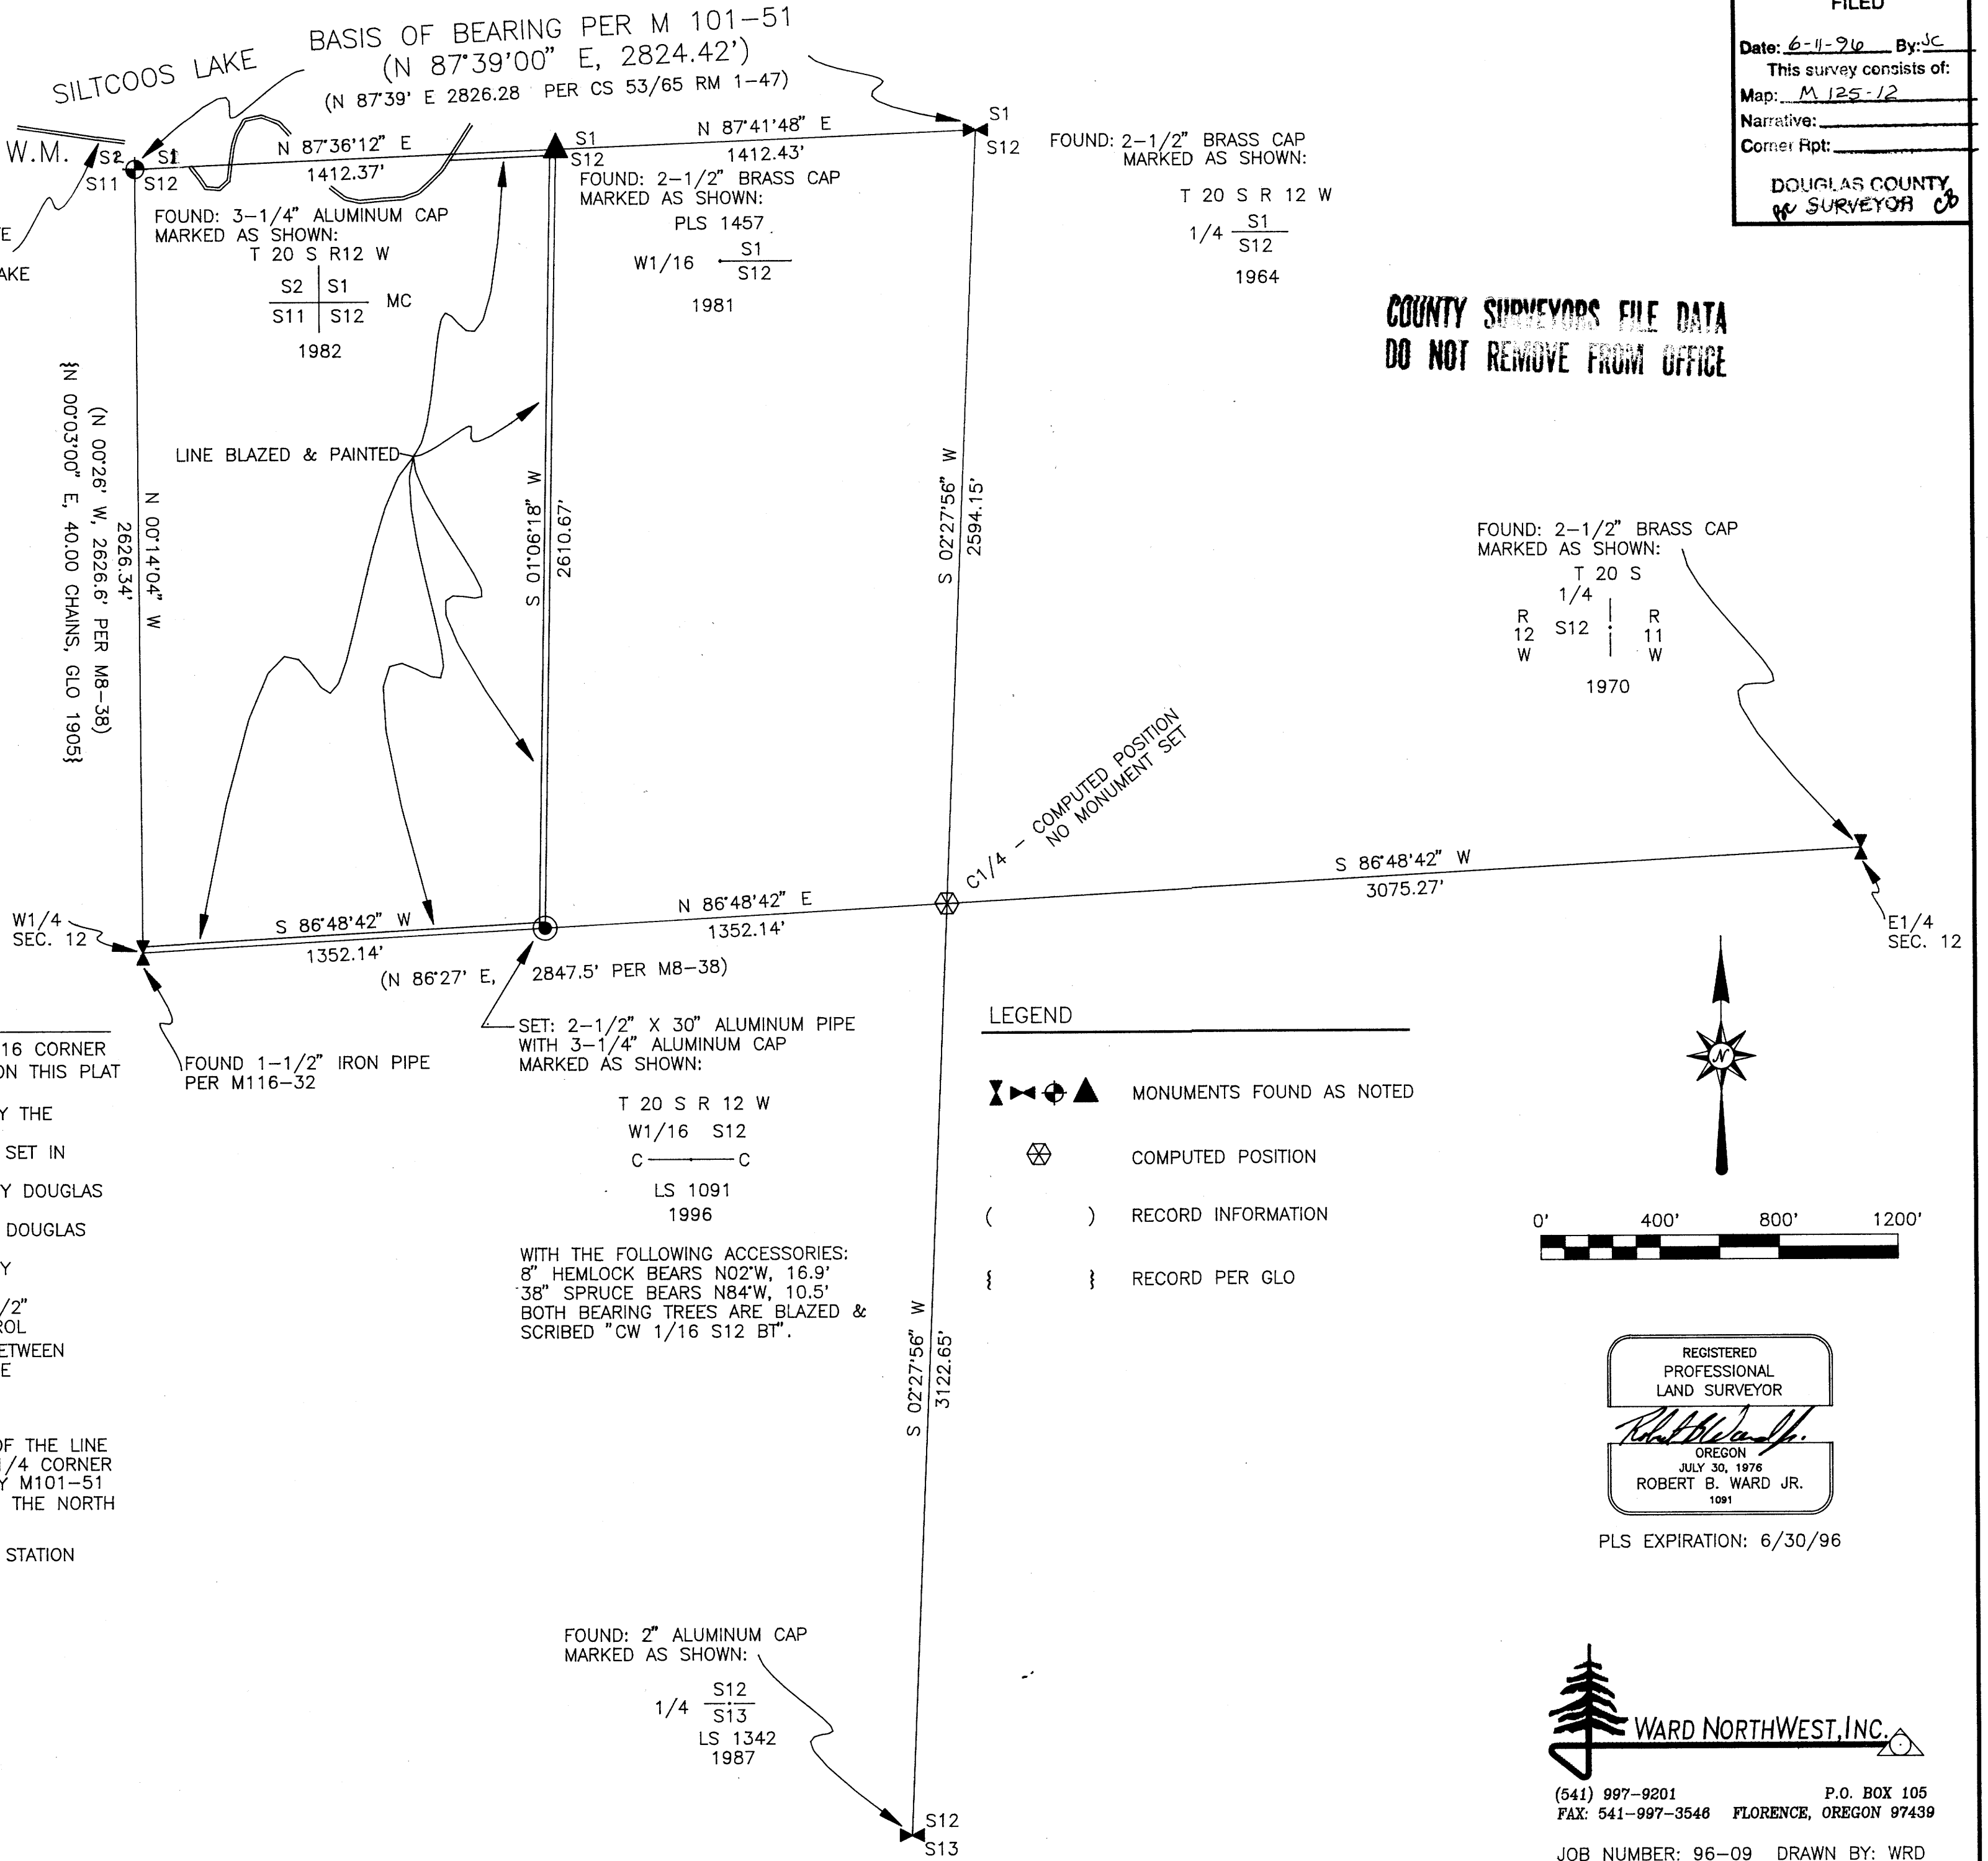

FILED
 Date: 6-11-96 By: JC
 This survey consists of:
 Map: M 125-12
 Narrative:
 Corner Rpt:
 DOUGLAS COUNTY
 SURVEYOR

COUNTY SURVEYORS FILE DATA
 DO NOT REMOVE FROM OFFICE

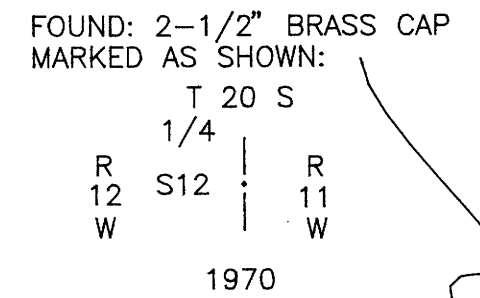

NARRATIVE

THE PURPOSE OF THIS SURVEY WAS TO MONUMENT THE CW1/16 CORNER OF SECTION 12 AND MARK THE BOUNDARY LINES AS SHOWN ON THIS PLAT

THE NORTHWEST CORNER OF SECTION 12 WAS SET IN 1982 BY THE BUREAU OF LAND MANAGEMENT
 THE WEST 1/16 CORNER COMMON TO SECTIONS 1 & 12 WAS SET IN 1981 BY PERRY FOX
 THE NORTH 1/4 CORNER OF SECTION 12 WAS SET IN 1964 BY DOUGLAS COUNTY
 THE EAST 1/4 CORNER OF SECTION 12 WAS SET IN 1970 BY DOUGLAS COUNTY
 THE SOUTH 1/4 CORNER OF SECTION 12 WAS SET IN 1987 BY STUNTZNER
 AT THE WEST 1/4 CORNER OF SECTION 12 WE FOUND A 1-1/2\"/>

THE BASIS OF BEARING FOR THIS SURVEY WAS THE BEARING OF THE LINE BETWEEN THE NORTHWEST SECTION CORNER AND THE NORTH 1/4 CORNER OF SECTION 12 AS ESTABLISHED IN 1989 BY DOUGLAS COUNTY M101-51 OUR INVERSE BETWEEN THE NORTHWEST SECTION CORNER AND THE NORTH 1/4 CORNER OF SECTION 12 IS N 87°39'00\"/>

THIS SURVEY WAS PERFORMED USING A PENTAX PTS-III TOTAL STATION


SET: 2-1/2\"/>

WITH THE FOLLOWING ACCESSORIES:
 8\"/>

FOUND: 2\"/>


LEGEND

- ▲ MONUMENTS FOUND AS NOTED
- ⊗ COMPUTED POSITION
- () RECORD INFORMATION
- { } RECORD PER GLO

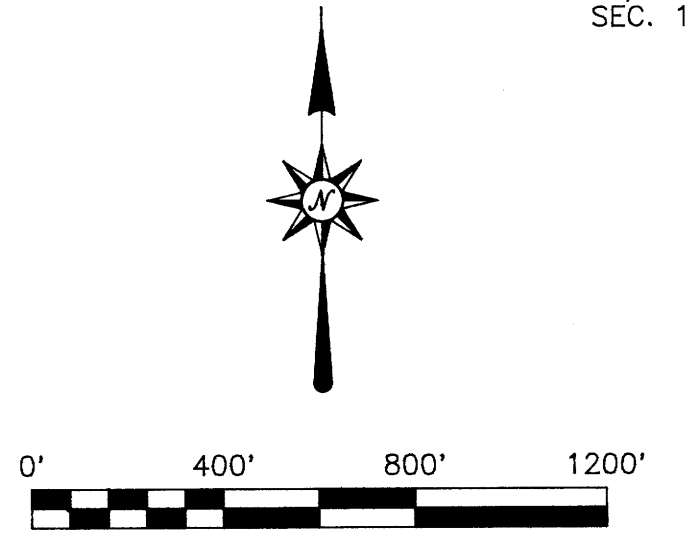

REGISTERED
 PROFESSIONAL
 LAND SURVEYOR
 OREGON
 JULY 30, 1976
 ROBERT B. WARD JR.
 1091

PLS EXPIRATION: 6/30/96

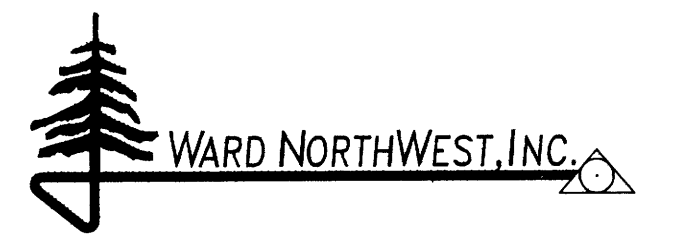

(541) 997-9201 P.O. BOX 105
 FAX: 541-997-3546 FLORENCE, OREGON 97439

JOB NUMBER: 96-09 DRAWN BY: WRD

MAP FILE M 125-12

MAP FILE M 125-12