


PROPERTY SURVNY
 For Mike McIntyre
 IN LOT 2, BLOCK 4, SUNSET HOMESITES
 SW 1/4, SEC. 14, T27S, R6W, W.M.
 JULY, 1997

FILED

Date: 8-1-97 By: PC
 This survey consists of:
 Map: M 127-31
 Narrative: _____
 Corner Rpt: _____

DOUGLAS COUNTY
 JP SURVEYOR

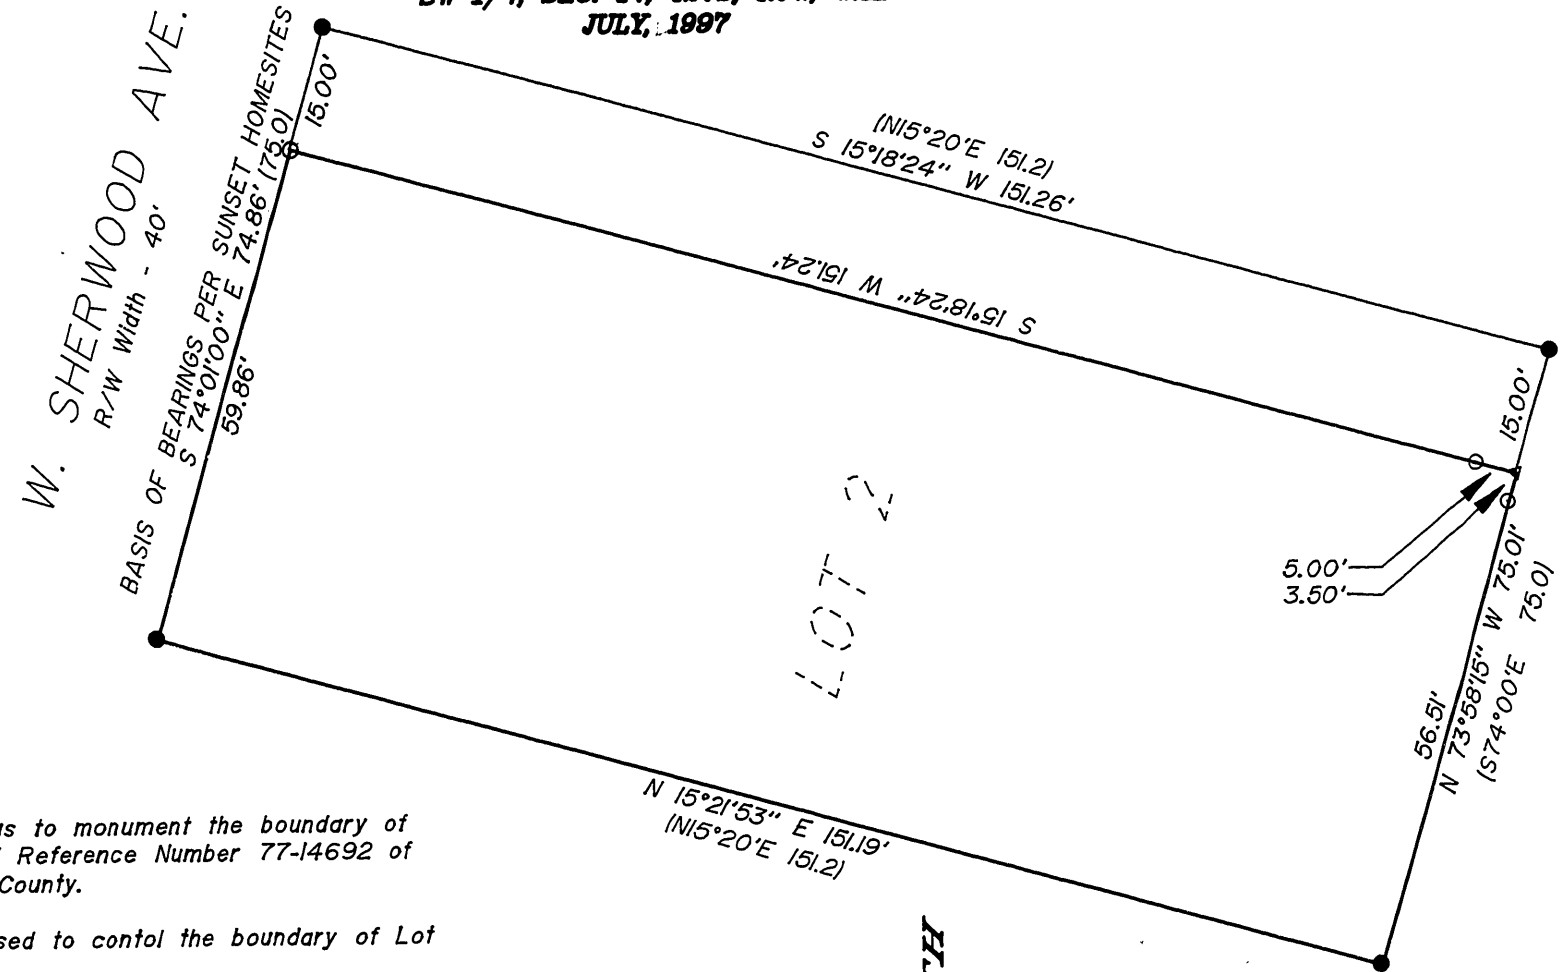

NARRATIVE

The purpose of this survey was to monument the boundary of the property described in Deed Reference Number 77-14692 of the Deed Records of Douglas County.


The monuments shown were used to control the boundary of Lot 2, Block 4, Sunset Homesites..

LEGEND:

- Found 5/8" Iron Rod or as noted
- ▲ Calculated Point at fence corner
- ⊙ Set 5/8" x 30" Iron Rod with Yellow Plastic Cap marked "AA SURVEYING INC."

RECORD INFORMATION:

() Sunset Homesites (Vol. 6, Pg. 78)

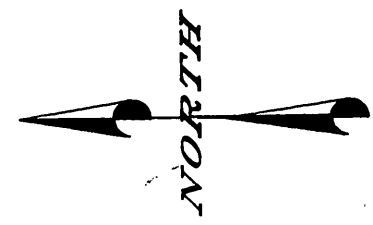

SCALE: 1"=20'

REGISTERED
 PROFESSIONAL
 LAND SURVEYOR

Mark A. Heimbarger

OREGON
 JULY 16, 1987
 MARK A. HEIMBURGER
 2287
 EXP. DATE: 6-30-97

AA

SURVEYING SERVICE, INC.
 ENGINEERING • SURVEYING • PLANNING

3076 NE DIAMOND LAKE BLVD.
 ROSEBURG, OREGON 97470
 TEL (541)672-2096 FAX (541)672-0611

**COUNTY SURVEYORS FILE DATA
 DO NOT REMOVE FROM OFFICE**

Plot date: 07/30/97 at 09:22 File name: S:\COMPS\1992-97\1992-97

MAP FILE M 127-31

MAP FILE M 127-31