

MAP OF SURVEY

LOCATED in Lots 20, 21 & 22, Block 2, Plat C, S.L. & W. Co. & in Sections 20 & 29,
T. 25 S., R. 5 W., W.M. in Douglas County, Oregon.

SW 8 SE 1/4'S SEC. 20; NE 8 NW 1/4'S SEC. 29
August 4, 1997

FILED

Date: 8-26-97 By: JP

This survey consists of:

Map: M 127-41


Narrative: _____

Corner Rpt: _____

DOUGLAS COUNTY
SURVEYOR

SURVEYED FOR: JAY STONE
1420 SW CALAPOOYA
SUTHERLIN, OREGON

SURVEYED BY: DAVID EDWARDS LAND SURVEYING
P.O. BOX 361
OAKLAND, OREGON 97462
PHONE: (541) 459-0512

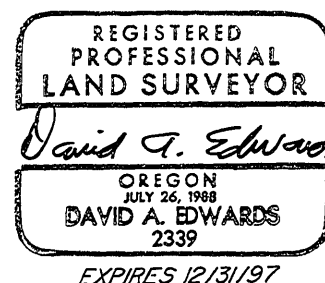

NARRATIVE

THE PURPOSE OF THIS SURVEY IS TO MONUMENT THE NW AND NE CORNERS OF LOT 20 AND THE SE CORNER OF LOT 22 IN BLOCK 2 AND TO SURVEY AND MARK THE EAST LINES OF LOTS 20, 21 AND 22 AND A PORTION OF THE SOUTH LINE OF LOT 22. FOUND MONUMENTS AS SHOWN WERE USED ALONG WITH RECORD DATA TO COMPUTE THE NECESSARY CORNER POSITIONS.

FIELD CREW: DAVID EDWARDS AND CARL MOORE.

EQUIPMENT: NIKON DTM AIOLG TOTAL STATION.

COMPS. AND DRAFTING: DAVID EDWARDS.

LEGEND

- INDICATES 5/8" DIAM. IRON ROD FD. PER M 82-3.
- INDICATES 5/8" X 30" STEEL PIN W/RED PLASTIC CAP MKD. "D.A. EDWARDS-LS 2339" SET.
- () DENOTES RECORD DATA PER PLAT C, S.L. & W. CO. UNLESS NOTED OTHERWISE.
- S.L. & W. CO. = SUTHERLIN LAND AND WATER CO.
- SCALE: 1" = 300' COMP. = COMPUTED.
- BASIS OF BEARINGS: PLAT C, S.L. & W. CO., AS SHOWN.
- X—X—X FENCE LINE.
- INDICATES FD. MONUMENT

