


**W&HPACIFIC**  
 8405 S.W. NIMBUS AVENUE  
 BEAVERTON, OREGON 97008  
 (503) 626-0455

**RECORD OF SURVEY**  
**RIGHT-OF-WAY OF CANYONVILLE**  
**TRAIL HIGHWAY (CO. RD. NO. 1)**

LOCATED IN THE WEST HALF OF SECTION 15 AND THE SOUTHEAST QUARTER OF THE SOUTHEAST QUARTER OF SECTION 16 AND THE NORTHEAST QUARTER OF SECTION 21 AND THE NORTH HALF OF SECTION 22 AND THE SOUTHWEST QUARTER OF SECTION 14 AND THE NORTHWEST QUARTER OF SECTION 23 IN TOWNSHIP 30 SOUTH, RANGE 4 WEST OF THE WILLAMETTE MERIDIAN AND BEING PART OF THE GEORGE T. DAY DLC NO. 47 IN TOWNSHIP 30 SOUTH, RANGE 4 WEST OF THE WILLAMETTE MERIDIAN IN DOUGLAS COUNTY, OREGON

SCALE 1:1000 (METRIC) DATE: 1/15/99

FILED  
 Date: 5-4-1999 By: JP  
 This survey consists of: 7 PAGES  
 Map: M129-40G  
 Narrative:  
 Corner Rpt:  
**DOUGLAS COUNTY**  
 SURVEYOR

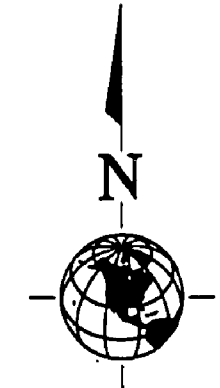

SCALE 1:1000 (METRIC)

Arthur L. & Lisa L. Pavel  
 tax lot #400  
 8801 Menard CT, Alexandria,  
 VA. 22309


NOTE: ALL STATIONS AND OFFSETS ARE SHOWN IN METERS

**CONTROL TABLE**

POINT NO.	STATION	OFFSET	DESCRIPTION
391	16+568.203	0.095 RT	FND 1/2"IR/YPC "FHWA"
392	16+654.983	3.498 RT	FND 1/2"IR/YPC "FHWA"
393	16+751.251	3.631 RT	FND 1/2"IR/YPC "FHWA"
394	16+808.171	8.107 RT	FND 1/2"IR/YPC "FHWA"
395	16+886.448	6.841 RT	FND 1/2"IR/YPC "FHWA"
396	17+069.560	6.828 RT	FND 1/2"IR/YPC "FHWA"
397	17+260.011	2.299 RT	FND 1/2"IR/YPC "FHWA"

**MONUMENT TABLE**

POINT NO.	STATION	OFFSET	DESCRIPTION	ORIGIN OR FIRST RECORD
232	17+256.864	37.841 LT	FND 5/8"IR/YPC "AA SURVEYING"	FND ON MAP "CO. RD. #1"
231	17+259.944	21.273 RT	FND 5/8"IR/YPC "AA SURVEYING"	FND ON MAP "CO. RD. #1"
234	17+260.240	15.330 LT	FND 5/8"IR/YPC "AA SURVEYING"	FND ON MAP "CO. RD. #1"
233	17+285.849	57.732 LT	FND 3-1/2" B.D. - 1/4 SEC. COR.	FND ON CS 54/5-5

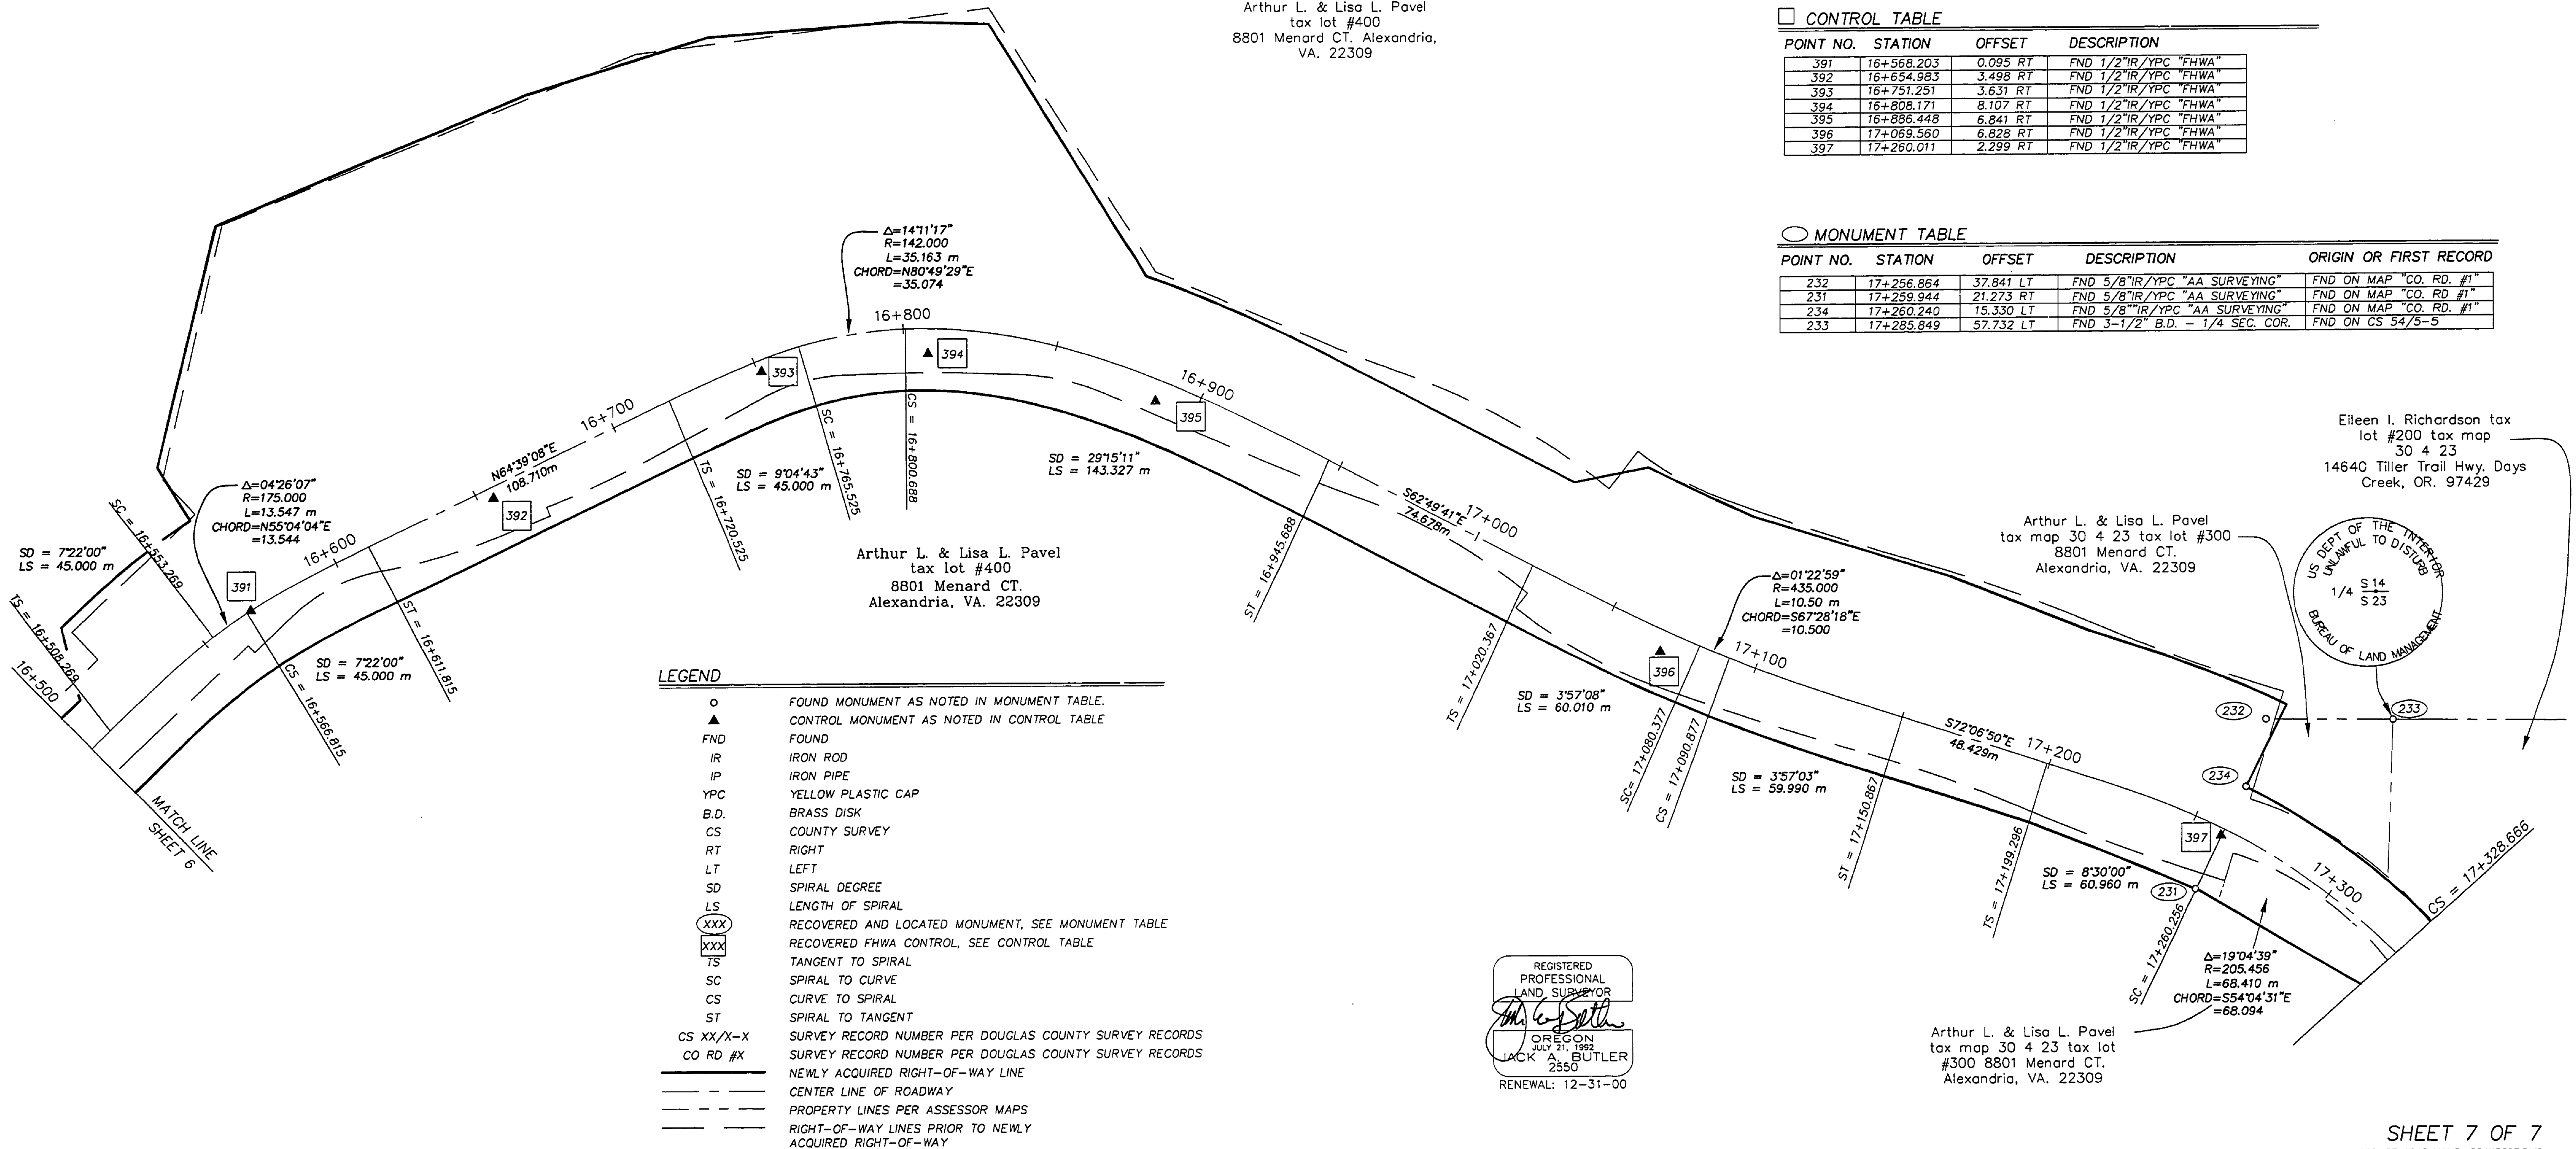

**LEGEND**

- FOUND MONUMENT AS NOTED IN MONUMENT TABLE.
- ▲ CONTROL MONUMENT AS NOTED IN CONTROL TABLE
- FND FOUND
- IR IRON ROD
- IP IRON PIPE
- YPC YELLOW PLASTIC CAP
- B.D. BRASS DISK
- CS COUNTY SURVEY
- RT RIGHT
- LT LEFT
- SD SPIRAL DEGREE
- LS LENGTH OF SPIRAL
- (XXX) RECOVERED AND LOCATED MONUMENT, SEE MONUMENT TABLE
- [XXX] RECOVERED FHWA CONTROL, SEE CONTROL TABLE
- TS TANGENT TO SPIRAL
- SC SPIRAL TO CURVE
- CS CURVE TO SPIRAL
- ST SPIRAL TO TANGENT
- CS XX/X-X SURVEY RECORD NUMBER PER DOUGLAS COUNTY SURVEY RECORDS
- CO RD #X SURVEY RECORD NUMBER PER DOUGLAS COUNTY SURVEY RECORDS
- NEWLY ACQUIRED RIGHT-OF-WAY LINE
- CENTER LINE OF ROADWAY
- PROPERTY LINES PER ASSESSOR MAPS
- RIGHT-OF-WAY LINES PRIOR TO NEWLY ACQUIRED RIGHT-OF-WAY

REGISTERED  
 PROFESSIONAL  
 LAND SURVEYOR  
 JACK A. BUTLER  
 OREGON  
 JULY 21, 1992  
 2350  
 RENEWAL: 12-31-00

Arthur L. & Lisa L. Pavel  
 tax map 30 4 23 tax lot  
 #300 8801 Menard CT.  
 Alexandria, VA. 22309

