

COUNTY SURVEYORS FILE DATA
DO NOT REMOVE FROM OFFICE

SURVEY TO SET PROPERTY CORNERS
IN LOT 16, BL. 7
ROSEBURG HOME ORCHARD TRACTS, PLAT A
S.E. 1/4 SEC 19, T.26S., R. 6W.W.M.

SURVEYED FOR T.G. LOOMAS
BY BRUCE ROGERS, 1727 S.E. MILL ST.
ROSEBURG, OR

FEB, 1999 1"=100'

REGISTERED
PROFESSIONAL
LAND SURVEYOR

Bruce R. Rogers

OREGON
JULY 10, 1964
BRUCE R. ROGERS
650

Exp. 12/31/2000

- - Fd. 5/8" I.R. M 92-59 # 128-47
- - SET 3/4" x 3/8" I.R. WITH CAP MARKED L.S. 660 FILED

Date: 3-15-1999 By: JP


This survey consists of:

Map: M131-25

Narrative: _____

Corner Rpt: _____

MAP FILE M131-25

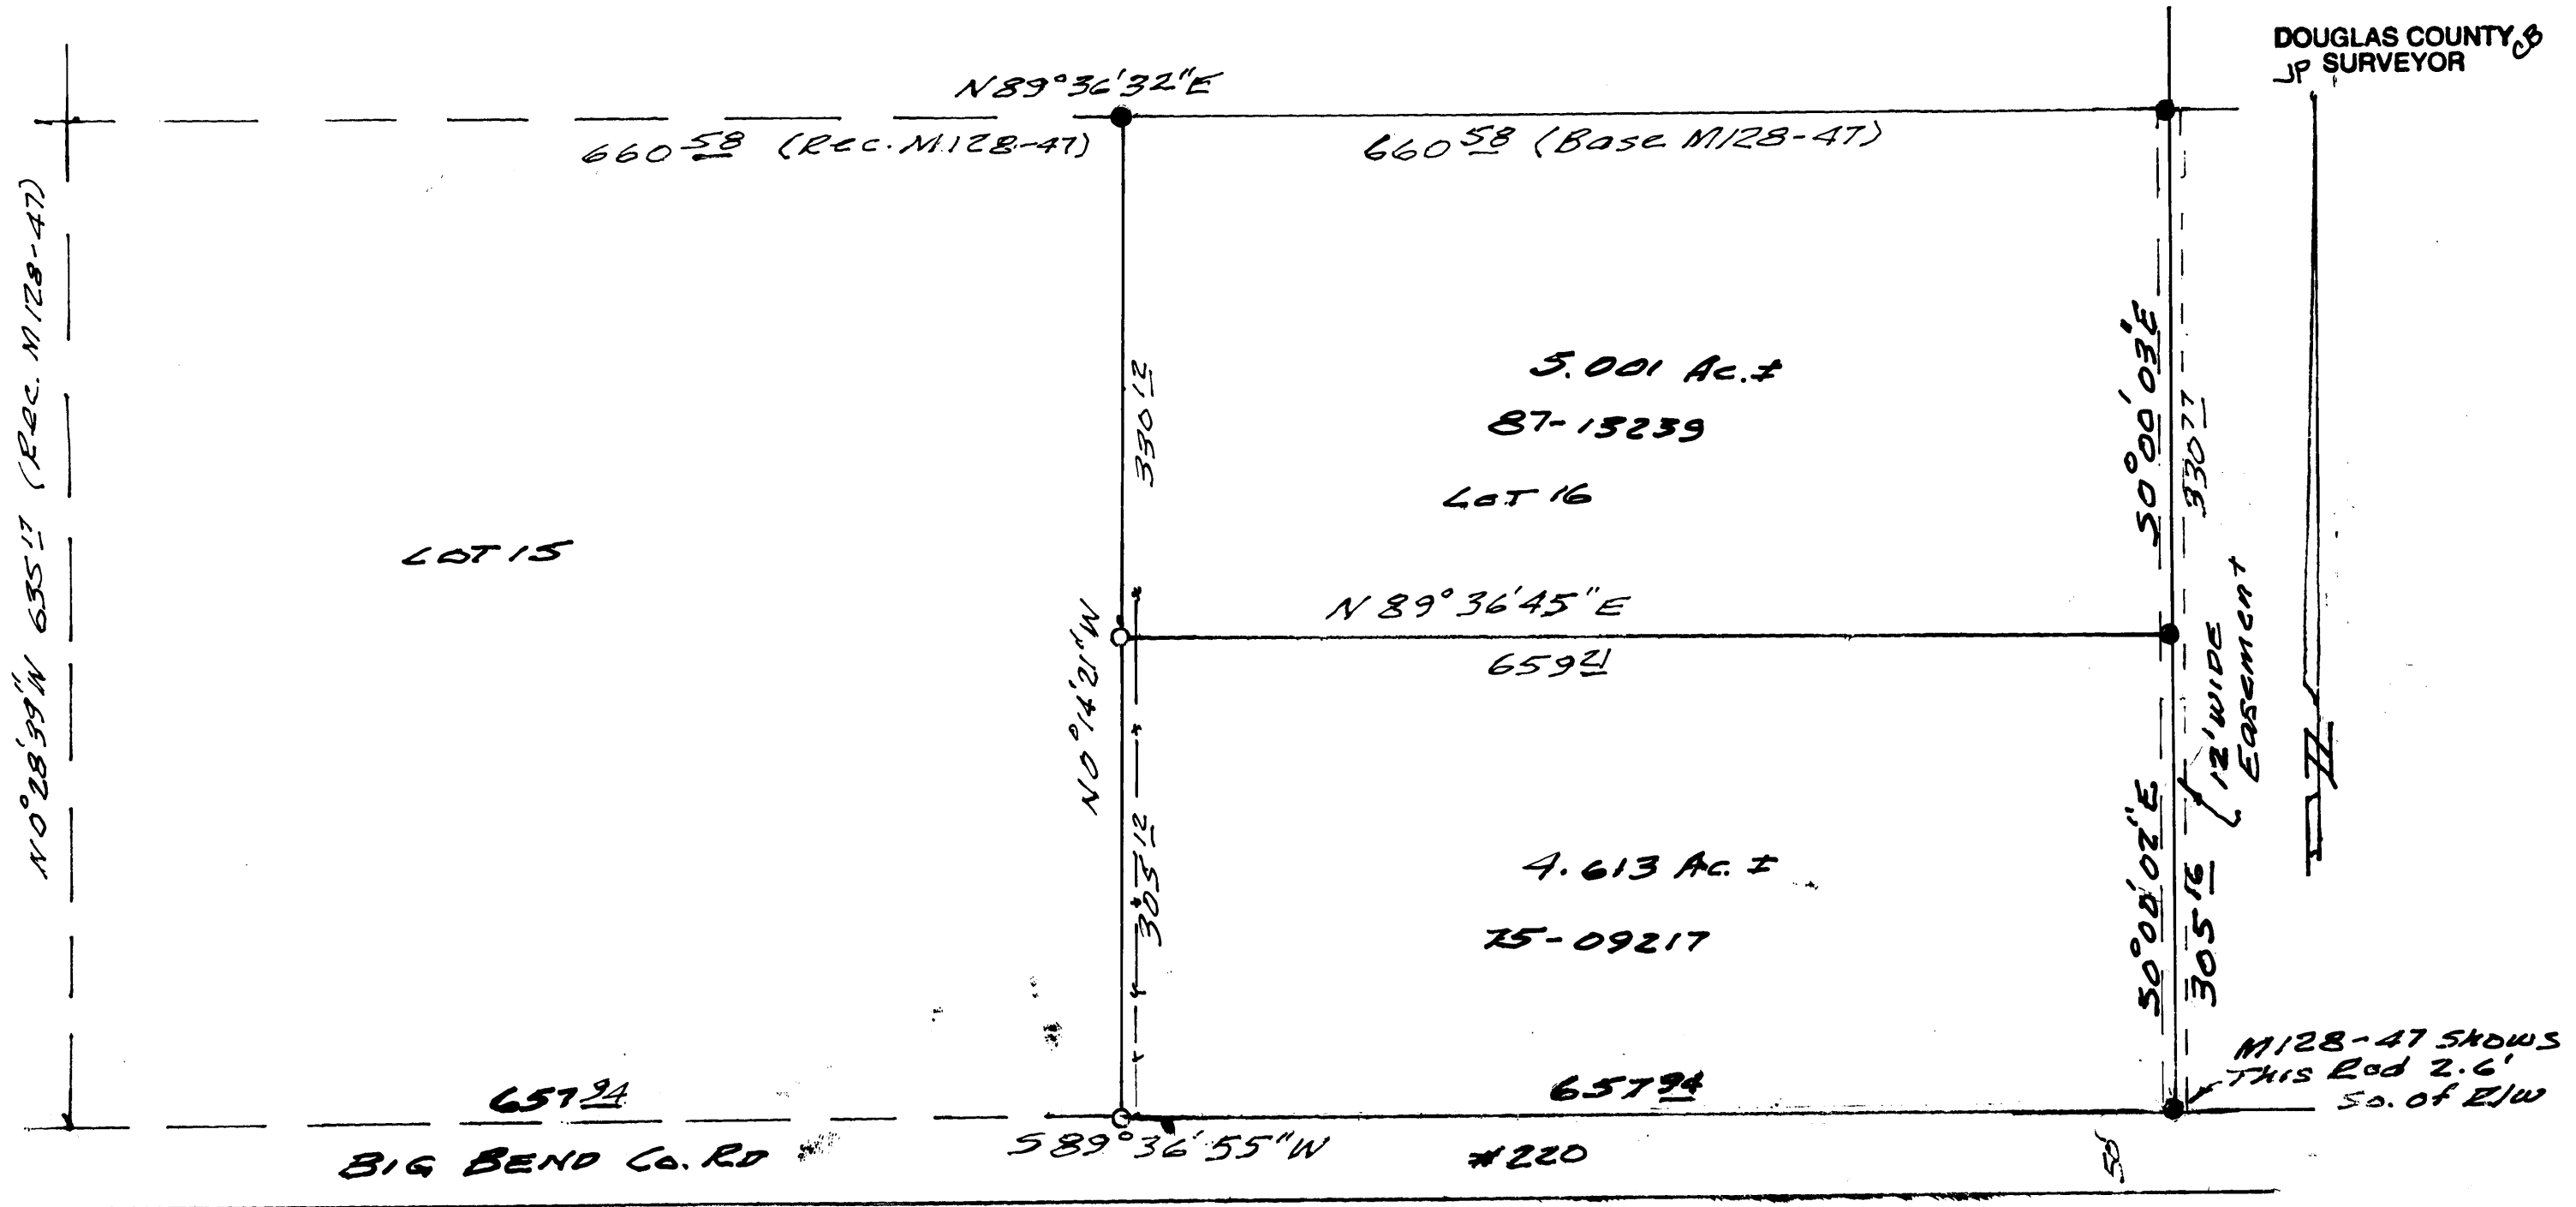

DOUGLAS COUNTY, OR
JP SURVEYOR

MAP FILE M131-25