

BOUNDARY SURVEY
FOR: SENECA JONES TIMBER CO.
FOLLEY SWITCH SURVEY
SECTION 24, T21S, R7W, W.M.
DOUGLAS COUNTY, OREGON
APRIL, 1999

FILED
Date: 5-20-1999 By: JP
This survey consists of:
Map: M131-54
Narrative: _____
Corner Rpt: _____
DOUGLAS COUNTY
SURVEYOR
JP

NARRATIVE


THE PURPOSE OF THIS SURVEY WAS TO SEARCH FOR THE WEST 1/4 CORNER OF SECTION 24, T21S, R7W, W.M. IN DOUGLAS COUNTY, OREGON, AND ESTABLISH THE WEST LINE OF SAID SECTION.

NO RECORD OF PERPETUATION FOR THIS WEST 1/4 CORNER WAS DISCOVERED, AND NO EVIDENCE OF THE ORIGINAL 1883 BT'S WAS RECOVERED. NO CORNERS WERE SET AS A RESULT OF THIS SURVEY.

THE LINE WAS MARKED WITH RED PAINTED BLAZES, RED FLAGGING, AND GALVANIZED STEEL POSTS PLACED AT APPROXIMATELY 200' INTERVALS. BEARING TREES REFERENCED ON THIS PLAT WERE PAINTED WITH RED BANDS AND FACES.

THE BASIS OF BEARING FOR THIS SURVEY WAS THE WEST LINE OF SECTION 24 PER THE ORIGINAL GLO SURVEY OF TOWNSHIP LINES IN 1883 BY LABAN H. WHEELER.


THIS SURVEY WAS A CLOSED LOOP TRAVERSE USING A PENTAX TOTAL STATION.

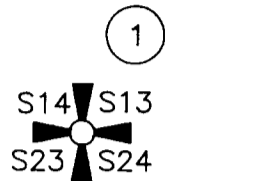

T21S, R7W
S14 | S13
S23 | S24
1986


- BT: 22" DOUGLAS FIR SNAG
S58°W 22.4 FT. (34 LKS)
NO MARKS VISIBLE ON
OPEN BLAZE.
BT: 55" DOUGLAS FIR N18°E
26.4 FT. (40 LKS) BARK
SCRIBED T21S R7W S13 BT
BT: 12" DOUGLAS FIR S73°E
44.2 FT. (67 LKS) WITH HEALED
FACE.
BT: 10" DOUGLAS FIR N85°W
29.0 FT. (44 LKS) WITH HEALED
FACE.

LEGEND

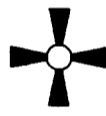
-  SECTION CORNER
[] RECORD DATA

[NORTH] N 00°00'00" E
5496.85'
[80 CHAINS]
BASIS OF BEARING

COUNTY SURVEYORS OFFICE

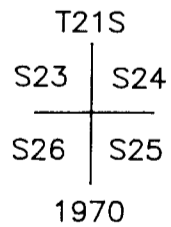


- BT: 80" ROTTED DOUGLAS FIR
STUMP N45°E 42.9 FT.
(65 LKS) NO MARKS VISIBLE.
BT: 38" DOUGLAS FIR N40°W
14.5 FT. (22 LKS) WITH
HEALED FACE.
BT: 11" DOUGLAS FIR N46.5°E
23.8 FT. (36 LKS) WITH
HEALED FACE.
BT: 28" DOUGLAS FIR S6°E 40.3
FT. (61 LKS) WITH HEALED
FACE.
BT: 13" DOUGLAS FIR S78.5°W
12.9 FT. (19.5 LKS) WITH
HEALED FACE.

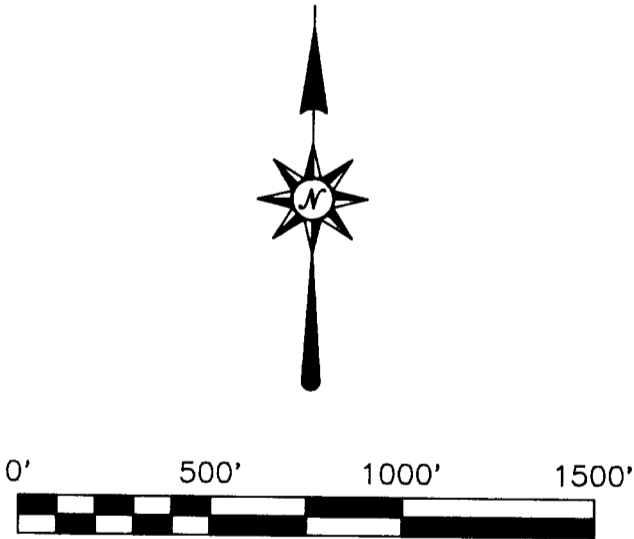

REGISTERED
PROFESSIONAL
LAND SURVEYOR

Robert B. Ward Jr.
OREGON
JULY 30, 1976
ROBERT B. WARD JR.
1091

PLS EXP. DATE: 6/30/00

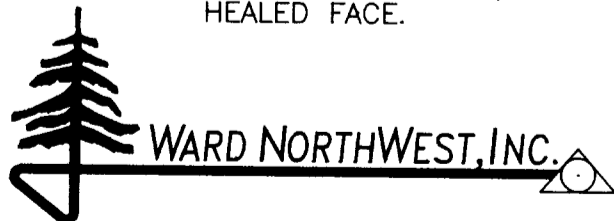

(541) 997-9201 P.O. BOX 105
FAX: 541-997-3546 FLORENCE, OREGON 97439
FILE: S:\SURVEYS\99\99-13\PLAT.DWG
DRAWN BY: JAD