


MAP FILE M134-24 C

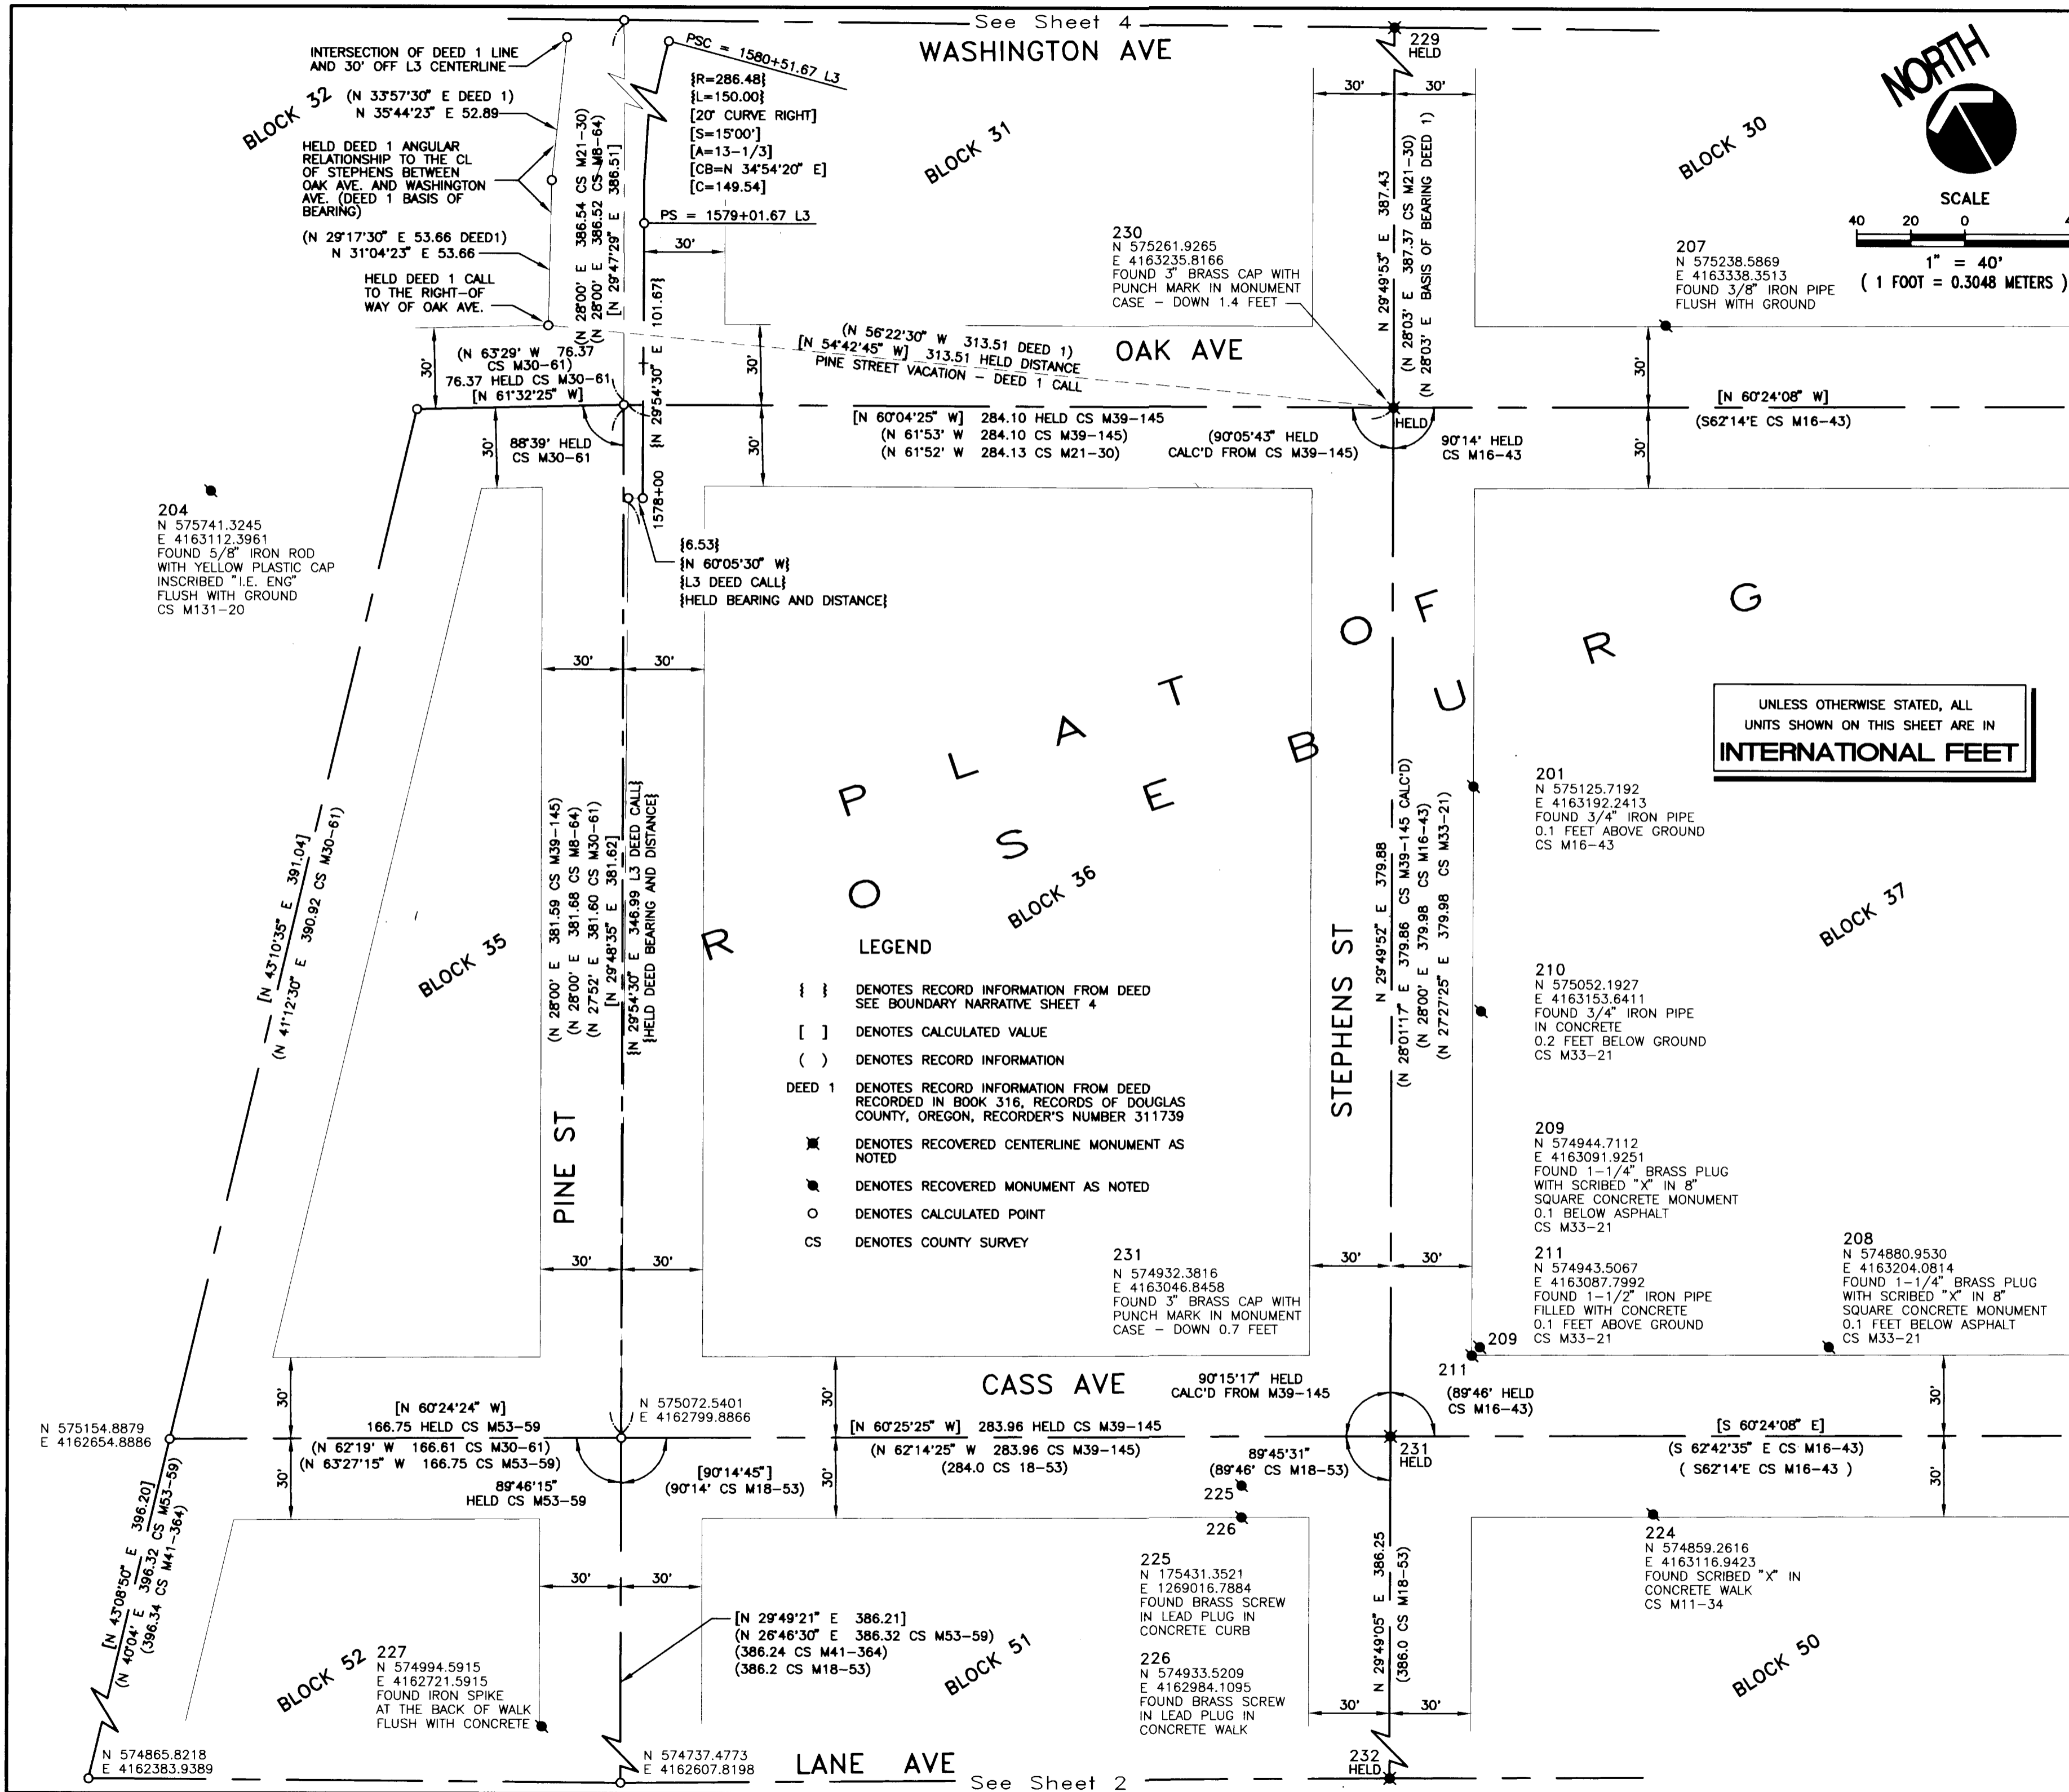

RCL	DEC. 1999
Calculated	Date
RCL	DEC. 1999
Drawn	Date
Checked	Date

REGISTERED  
PROFESSIONAL  
LAND SURVEYOR

OREGON  
JULY 14, 1998  
ROBERT C. LENNOX  
2886  
RENEWAL: 12-31-00

**Preconstruction and Centerline Survey**  
FOR  
Oregon Department of Transportation  
**Boundary Resolution**  
AND  
LOCATED IN THE NW 1/4 SECTION 19, T. 27 S., R. 5 W., W. M.  
AND  
LOCATED IN THE NE 1/4 SECTION 24, T. 27 S., R. 6 W., W. M.  
CITY OF ROSEBURG, DOUGLAS COUNTY, OREGON

FILED  
Date: 2/17/2000 By: JP  
This survey consists of: 5 pgs.  
Map: M134-24 C  
Narrative: \_\_\_\_\_  
Corner Rpt: \_\_\_\_\_  
DOUGLAS COUNTY  
SURVEYOR

**otak** surveyors  
engineers  
planners  
incorporated  
17355 S.W. BOONES FERRY ROAD  
LAKE OSWEGO, OREGON 97035  
(503)635-3618 FAX (503)635-5395

**3 OF 5**  
Sheet No.  
**9054-003**  
Project No.

MAP FILE M134-24 C