

1/4 COR.

35

(N89°42'W, 39.79 CHS. - BASIS OF BEARINGS)
N89°42'00"W 2635.60'

SECTION COR.

35

36

FILED
 Date: 9-6-2000 By: JC
 This survey consists of:
 Map: M 135-46
 Narrative:
 Corner Rpt:
 DOUGLAS COUNTY
 SURVEYOR

2

1317.80'

1317.80'


EAST 1/16 COR.
 SCRIBED:
 8" D. FIR, S28°W, 2.3 FT.
 11" D. FIR, S79°E, 9.2 FT.

2

1

MAP

SHOWING A SURVEY SITUATED IN THE
 NE1/4 OF SEC. 2, T.32S., R.5W., W.M.,
 DOUGLAS COUNTY, OREGON.

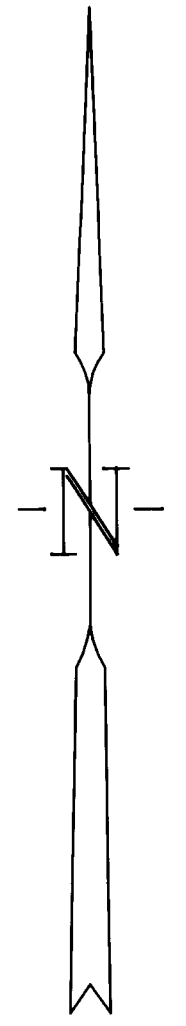

N00°15'37"E 2618.66'
 (N0°53'E, 39.82 CHS.)

W1/2, NE1/4
 79.96 Acres

SUPERIOR LUMBER CO.

N00°20'27"W 2612.98'

LEGEND

- SET 5/8" X 30" IRON ROD WITH YELLOW PLASTIC CAP MARKED "NYGREN LS1035".
- FOUND BRASS CAP & B.T.'S PER 1955 B.L.M. SURVEY.
- MARKED LINE WITH BLAZES PAINTED FLO-RED AND FLO-RED RIBBON.
BEARINGS BASED ON 1955 B.L.M. SURVEY.

SURVEY NARRATIVE

THE PURPOSE OF THIS SURVEY IS TO MARK THE EAST, NORTH AND WEST LINES OF THE WEST HALF OF THE NORTHEAST QUARTER OF SAID SECTION 2 FOR LOGGING PURPOSES.

I RECOVERED AND HELD TO MONUMENTS SET BY THE BUREAU OF LAND MANAGEMENT IN 1955 SURVEY. SAID MONUMENTS WERE FOUND AS SHOWN ON ANNEXED MAP.

A NIKON DTM-A20LG TOTAL STATION WAS USED TO EXECUTE THIS SURVEY.

REGISTERED
 PROFESSIONAL
 LAND SURVEYOR

 OREGON
 GERALD V. NYGREN
 AUGUST 22, 1975
 1035
 EXPIRES 12-31-2000

CENTER-EAST 1/16 COR.
 SECTION 2

(N89°48'W, 20.19 CHS.)
 S89°56'55"E 1345.23'

CENTER 1/4 COR.
 SECTION 2

| | | |
|--|---|---|
| SURVEYED FOR: SUPERIOR LUMBER CO. P.O. BOX 250 GLENDALE, OR 97442 | GERALD V. NYGREN 522 BARKER DRIVE MERLIN, OREGON 97532 | DATE: AUG. 4, 2000 SCALE: 1" = 200' JOB NO. 00-69 |
|--|---|---|

MAP FILE M135-46

MAP FILE M135-46