
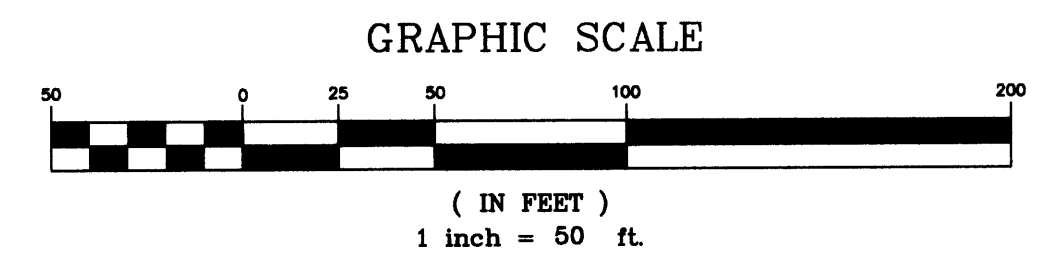


LOT 3 DETAIL
N.T.S.

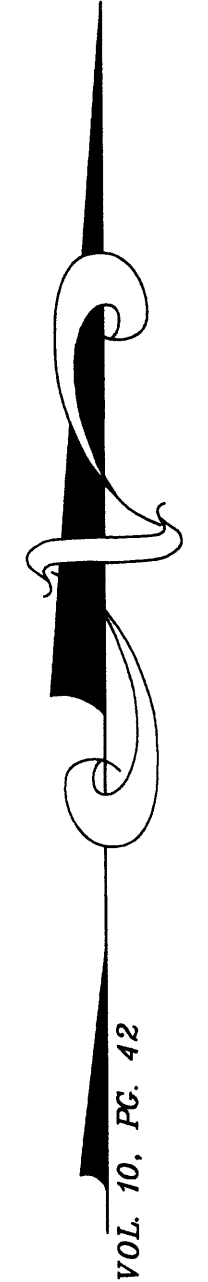

- LEGEND:**
- FOUND 5/8" I. ROD UNLESS OTHERWISE NOTED.
 - SET 5/8" X 30" REINFORCING ROD WITH YELLOW PLASTIC CAP MARKED, "LAND MARK".
 - X— FENCE LINE

- RECORD INFORMATION:**
- (1) AMANN SUBDIVISION VOLUME 10, PAGE 42
 - (2) DOUGLAS COUNTY ROAD MAP NO. 4 DATED 1977
 - (3) SMITH ACRES AT LONE ROCK VOLUME 6, PAGE 40

NARRATIVE:

THE PURPOSE OF THIS SURVEY WAS TO DEMARCATATE THE BOUNDARIES OF LOTS 2 AND 3, AMANN SUBDIVISION AS PLATTED AND RECORDED IN VOLUME 10, PAGE 42 OF THE PLAT RECORDS OF DOUGLAS COUNTY, OREGON AT THE REQUEST OF THE CLIENT.

THE BOUNDARY OF THE SUBJECT TRACT WAS RESOLVED AS FOLLOWS:

THE RIGHT OF WAY OF HWY. 138 WAS DETERMINED BY HOLDING THE MONUMENTS FOUND AT STATIONS 915+00 - 60.00' LEFT AND 927+00 - 75.00' LEFT AND OFFSETTING RECORD DISTANCE FROM CENTERLINE. THE BOUNDARY OF AMANN SUBD. WAS ESTABLISHED BY HOLDING THE MONUMENT FOUND AT THE SE CORNER OF LOT "B" OF SMITH ACRES AT LONE ROCK AND THE MONUMENT FOUND AT THE NORTHEASTERLY CORNER OF LOT 2, AMANN SUBD. RECORD BEARINGS AND DISTANCES WERE HELD GIVING FULL MEASURE OF LOT WIDTH TO LOTS 2 AND 3. MONUMENTS WERE SET AS SHOWN. A REFERENCE MONUMENT WAS SET AT THE NORTHEAST CORNER OF LOT 3 DUE TO THE LOCATION OF THE GABION WALL.

Sheet 1 of 1
BOUNDARY SURVEY
 In the SW 1/4, Section 17
 Township 26 South, Range 3 West, W.M.
 Douglas County, Oregon
 August 19, 2003

REGISTERED PROFESSIONAL LAND SURVEYOR
Mark A. Heimbürger
 OREGON
 JULY 16, 1987
 MARK A. HEIMBURGER
 2287
 RENEWS JUNE 30, 2005
 LM Proj. No.: 2003-0270

FOR: Glde Lumber Products
 20016 N. Umpqua Hwy.
 Glde, Oregon 97443

Land Mark
 SURVEYING INC.
 3329 N.E. Stephens Street
 Roseburg, Oregon 97470
 Tel (541) 677-9400
 Fax (541) 677-9401