

FILED
Date: 9/28/2001 By: JP
This survey consists of:
Map: M138-72
Narrative:
Corner Rpt: _____

DOUGLAS COUNTY
SURVEYOR

Fd. 5/8" Iron Rod with 1 1/2" Alum. Cap marked
"T28S R7W C1/4 S30 1995 PLS 1941

1441.78

N 01°11'12" W 2883.55' (2883.40' 1996-0004A)


1441.77

BASIS OF BEARING AS PER 1996-0004A

CS 1/16 S30
26" Douglas Fir Bears N29°W 64.12' Scribed "CS 1/16 S30" "BT"
13" Douglas Fir Bears S41°W 107.13' Scribed "CS 1/16 S30" "BT"
Set 5/8" x 30" IR w/Plastic Cap Marked "Land Mark PLS 2287"

Fd. 5/8" Iron Rod (M62-17)
Bears S28°03'48"E
100.10' from CS1/16

Fd. 1 1/4" Iron Pipe with 2 1/2" Brass Cap
and Accessories per PLSS ID # 140200

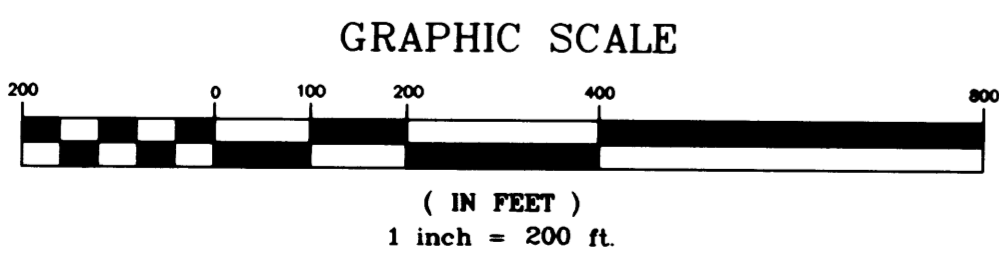

Narrative

The purpose of this survey is to monument the CS 1/16 of Section 30, T.28S., R.7W., W.M., the CS 1/16 was set midway between the S1/4 corner of Section 30 and The C1/4 of Section 30

Sheet 1 of 1
RECORD OF SURVEY

In the SW 1/4, Section 30
Township 28 South, Range 7 West, W.M.
Douglas County, Oregon
September 12, 2001

REGISTERED
PROFESSIONAL
LAND SURVEYOR

Mark A. Heimbürger
OREGON
JULY 16, 1987
MARK A. HEIMBURGER
2287

RENEWS JUNE 30, 2003

FOR: George Williams
1161 Reston RD
Roseburg, OR. 97470

Land Mark
SURVEYING INC.

3329 N.E. Stephens Street
Roseburg, Oregon 97470
Tel (541) 677-9400
Fax (541) 677-9401

LM Proj. No. 2001-0107