

PROPERTY SURVEY
 FOR: SENECA JONES TIMBER COMPANY
 EAST LINE SECTION 10
 T29S, R4W, W.M.
 DOUGLAS COUNTY, OREGON

FILED
 Date: 1/11/2002 By: JP
 This survey consists of:
 Map: M139-35
 Narrative _____
 Corner Rpt: _____

DOUGLAS COUNTY
 SURVEYOR



FND: 2-1/2" DIA. BRASS CAP DATED 1963, DOUGLAS COUNTY SURVEYOR WITH THE FOLLOWING ACCESSORIES:


- 27" DOUGLAS FIR BEARS N83°E, 53 LKS WITH HEALED FACE
- 20" GRAND FIR BEARS S28-1/2°E, 46 LKS WITH HEALED FACE
- 17" DOUGLAS FIR BEARS S24-1/4°W, 31 LKS WITH HEALED FACE
- 9" INCENSE CEDAR BEARS N24°W, 24 LKS WITH HEALED FACE

NARRATIVE

THE PURPOSE OF THIS SURVEY WAS TO POST AND BLAZE THE PROPERTY LINE AS SHOWN ON THIS MAP. ALL CORNERS SHOWN AS FOUND WERE HELD AS CONTROL FOR THIS SURVEY.

THE BASIS OF BEARING FOR THIS SURVEY IS THE BEARING OF THE SECTION LINE AS ESTABLISHED BY THE BUREAU OF LAND MANAGEMENT IN A 1992 DEPENDENT RESURVEY.

THE SECTION LINE WAS POSTED WITH GALVANIZED STEEL POSTS AND BLAZED, PAINTED WITH RED PAINT. ALL FOUND BEARING TREES ARE PAINTED WITH A RED BAND.

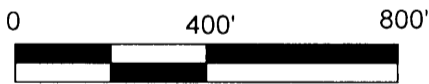


LEGEND

- FOUND 1/4 CORNER
- FOUND SECTION CORNER
- FOUND 1/16 CORNER
- FOUND WITNESS CORNER
- LINE POSTED & BLAZED THIS SURVEY

FILE NAME		
01-71.TRV		
SCALE	DATE	DRAWN BY
400 Ft/in	1-8-2002	RBW
JOB	REVISION	SHEET
01-71		1/1

This map drawn with TRAVERSE PC Software

COLOURS: Inked by hand
 INK: BLACK
 MEDIA: CLEARPINK DRAFTING JELIUM
 (TRANSPARENT) NEW OPTION PAPER
 NO POST FEE

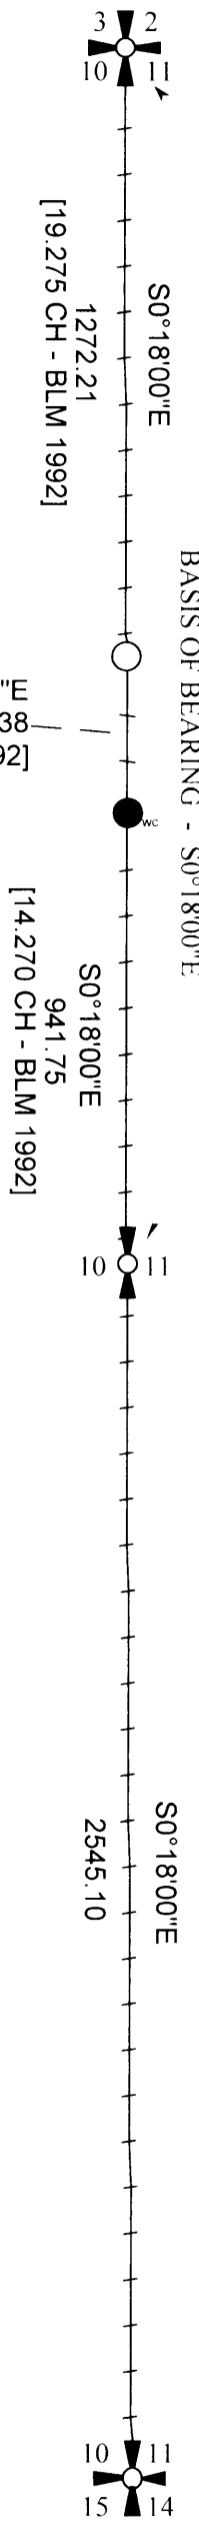

BASIS OF BEARING - S0°18'00"E

FND: 2-1/2" DIA. BLM BRASS CAP DATED 1992 WITH THE FOLLOWING ACCESSORIES:
 16" DIA. INCENSE CEDAR BEARS N28°E, 52 LKS WITH SEMI HEALED FACE
 11" DIA. MADRONE BEARS N82-1/2°W, 3 LKS WITH SEMI HEALED FACE

FND: 2" DIA. BRASS CAP DATED 1983 SET BY LS 866 WITH THE FOLLOWING ACCESSORY:
 20" DIA. FIR BEARS N67-1/4°W, 23 LKS WITH HEALED FACE

FND: 2" DIA. BRASS CAP DATED 1983 SET BY LS 866 WITH THE FOLLOWING ACCESSORIES:
 BLM BEARING TREES
 9" FIR BEARS N50°E, 19 LKS WITH HEALED FACE
 6" FIR BEARS N40°W, 26LKS WITH HEALED FACE
 NOTE: NO BEARING TREES ESTABLISHED BY LS 866

FND: 2-1/2" DIA. BRASS CAP DATED 1963, DOUGLAS COUNTY SURVEYOR WITH THE FOLLOWING ACCESSORIES:
 ROTTEN FIR STUMP BEARS S10°E, 22 LKS
 24" CEDAR BEARS N74°E, 63 LKS WITH HEALED FACE
 9" FIR BEARS S59-1/2°E, 11 LKS WITH HEALED FACE
 NOTE: ALL OTHER PRIOR BEARING TREES ARE NOW GONE DUE TO ROAD CONSTRUCTION. ALSO, FENCELINE RUNS TO CORNER FROM THE SOUTH.

REGISTERED
 PROFESSIONAL
 LAND SURVEYOR

 ROBERT B. WARD JR.
 EXPIRES: 6/30/02



Ward NorthWest, Inc.
 P O BOX 105 FLORENCE, OR 97439
 (541) 997-9201 FAX 541-997-3546