

FILED

Date: 3-28-2002 By: JC
This survey consists of:
Map: H139-61
Narrative:
Corner Rpt: 65/42-40 A-D

DOUGLAS COUNTY SURVEYOR

Basis of bearings is the south half of the N-S Q.
Scale: 1" = 400 ft.

LEGEND

- Corner found, 2 1/2" brass cap on a 1" pipe or as noted
- Corner set, 2 1/2" x 28" alum. pipe with a 3 1/4" alum. cap mkd. "Shaner Engr."
- Property line, marked with blazes red paint and 6 ft. steel fence posts

NARRATIVE

The survey was performed for the purpose of locating property corners and marking property lines (see map). The follow surveys were referred to and are on record at the Douglas County Surveyor's Office:

Ref. No. (R)	Map File No.	Surveyor	Date
1	M15-24	Robert M. Thompson	1959
2	M81-17	USBLM Administrative Survey	1979

The corner descriptions are to be found in County Surveyor File No. 65/42-40 A thru D
The survey was done in March, 2002, using a Jena 0°00'01" theodolite and a Mac II electronic distance meter.

PROPERTY LINE SURVEY
in Section 18, T31S, R4W, W.M.,
Douglas County, Oregon

For: Seneca Jones Timber Co.
P.O. Box 2129
Roseburg, Oregon 97470

By: Shaner Engineering, Inc.
P.O. Box 1430
Roseburg, Oregon 97470


March 27, 2002

C.S. File No. 65/42-40 A thru D

Silver Butte Timber Co.

Seneca Jones Timber Co.

Seneca Jones Timber Co.

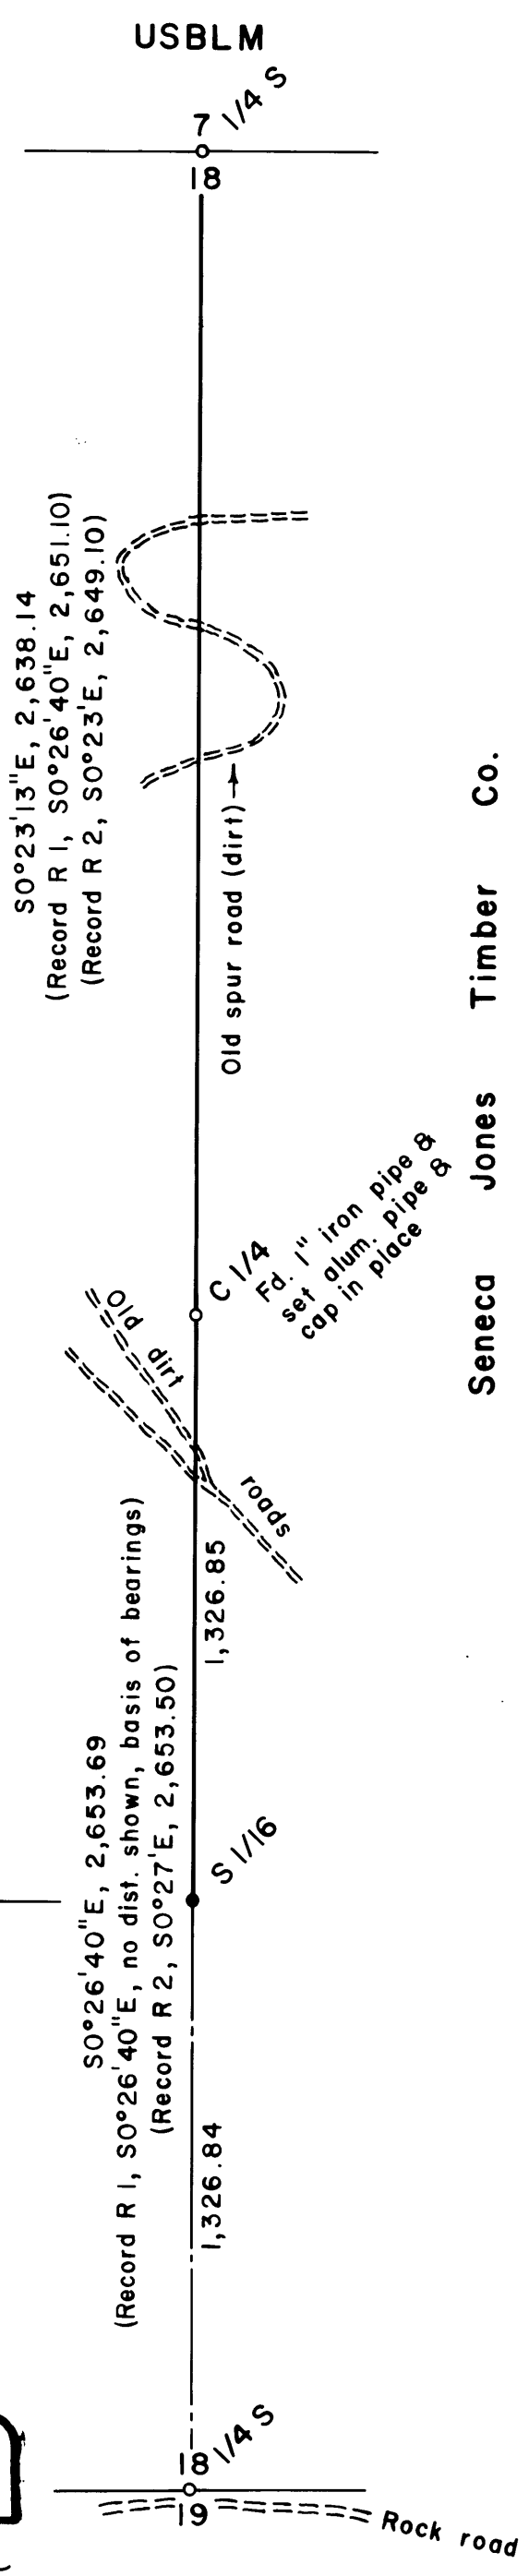

REGISTERED PROFESSIONAL LAND SURVEYOR
Bruce A. Shaner

OREGON OCT. 4, 1987
BRUCE A. SHANER
430
Renews June 30, 2002