

# MAP OF SURVEY

LOCATED in Sections 1 and 2, T. 24 S., R. 6 W., W.M. in Douglas County, Oregon.


May 10, 2002

FILED  
Date: 5/23/2002 By: JD  
This survey consists of:  
Map: M 140-13  
Narrative:  
Corner Rpt: \_\_\_\_\_

DOUGLAS COUNTY  
SURVEYOR


SURVEYED FOR: ROSEBURG RESOURCES  
P.O. BOX 1088  
ROSEBURG, OREGON

SURVEYED BY: DAVID EDWARDS LAND SURVEYING  
P.O. BOX 361  
OAKLAND, OREGON 97462  
PHONE: (541) 459-0512

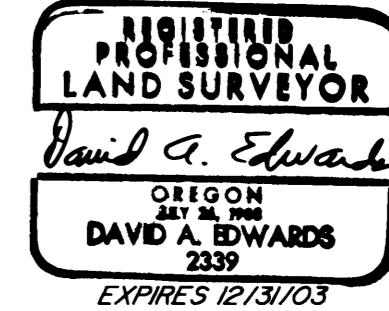

1/4 CORNER  
FD. B.T. = 30" FIR S.68°E., 8.8' W/B.L.M. TAG  
NEW B.T.'S =  
24" FIR N.45°E., 15.7'  
4" FIR S.50°W., 28.6'  
14" FIR N.14°W., 20.6'

SECTION CORNER  
FD. B.T.'S =  
34" FIR N.62 1/2°E., 64.2'  
22" FIR STUMP S.43°E., 17.2'  
19" FIR S.68°W., 11.0'  
36" FIR N.24 1/2°W., 45.0'

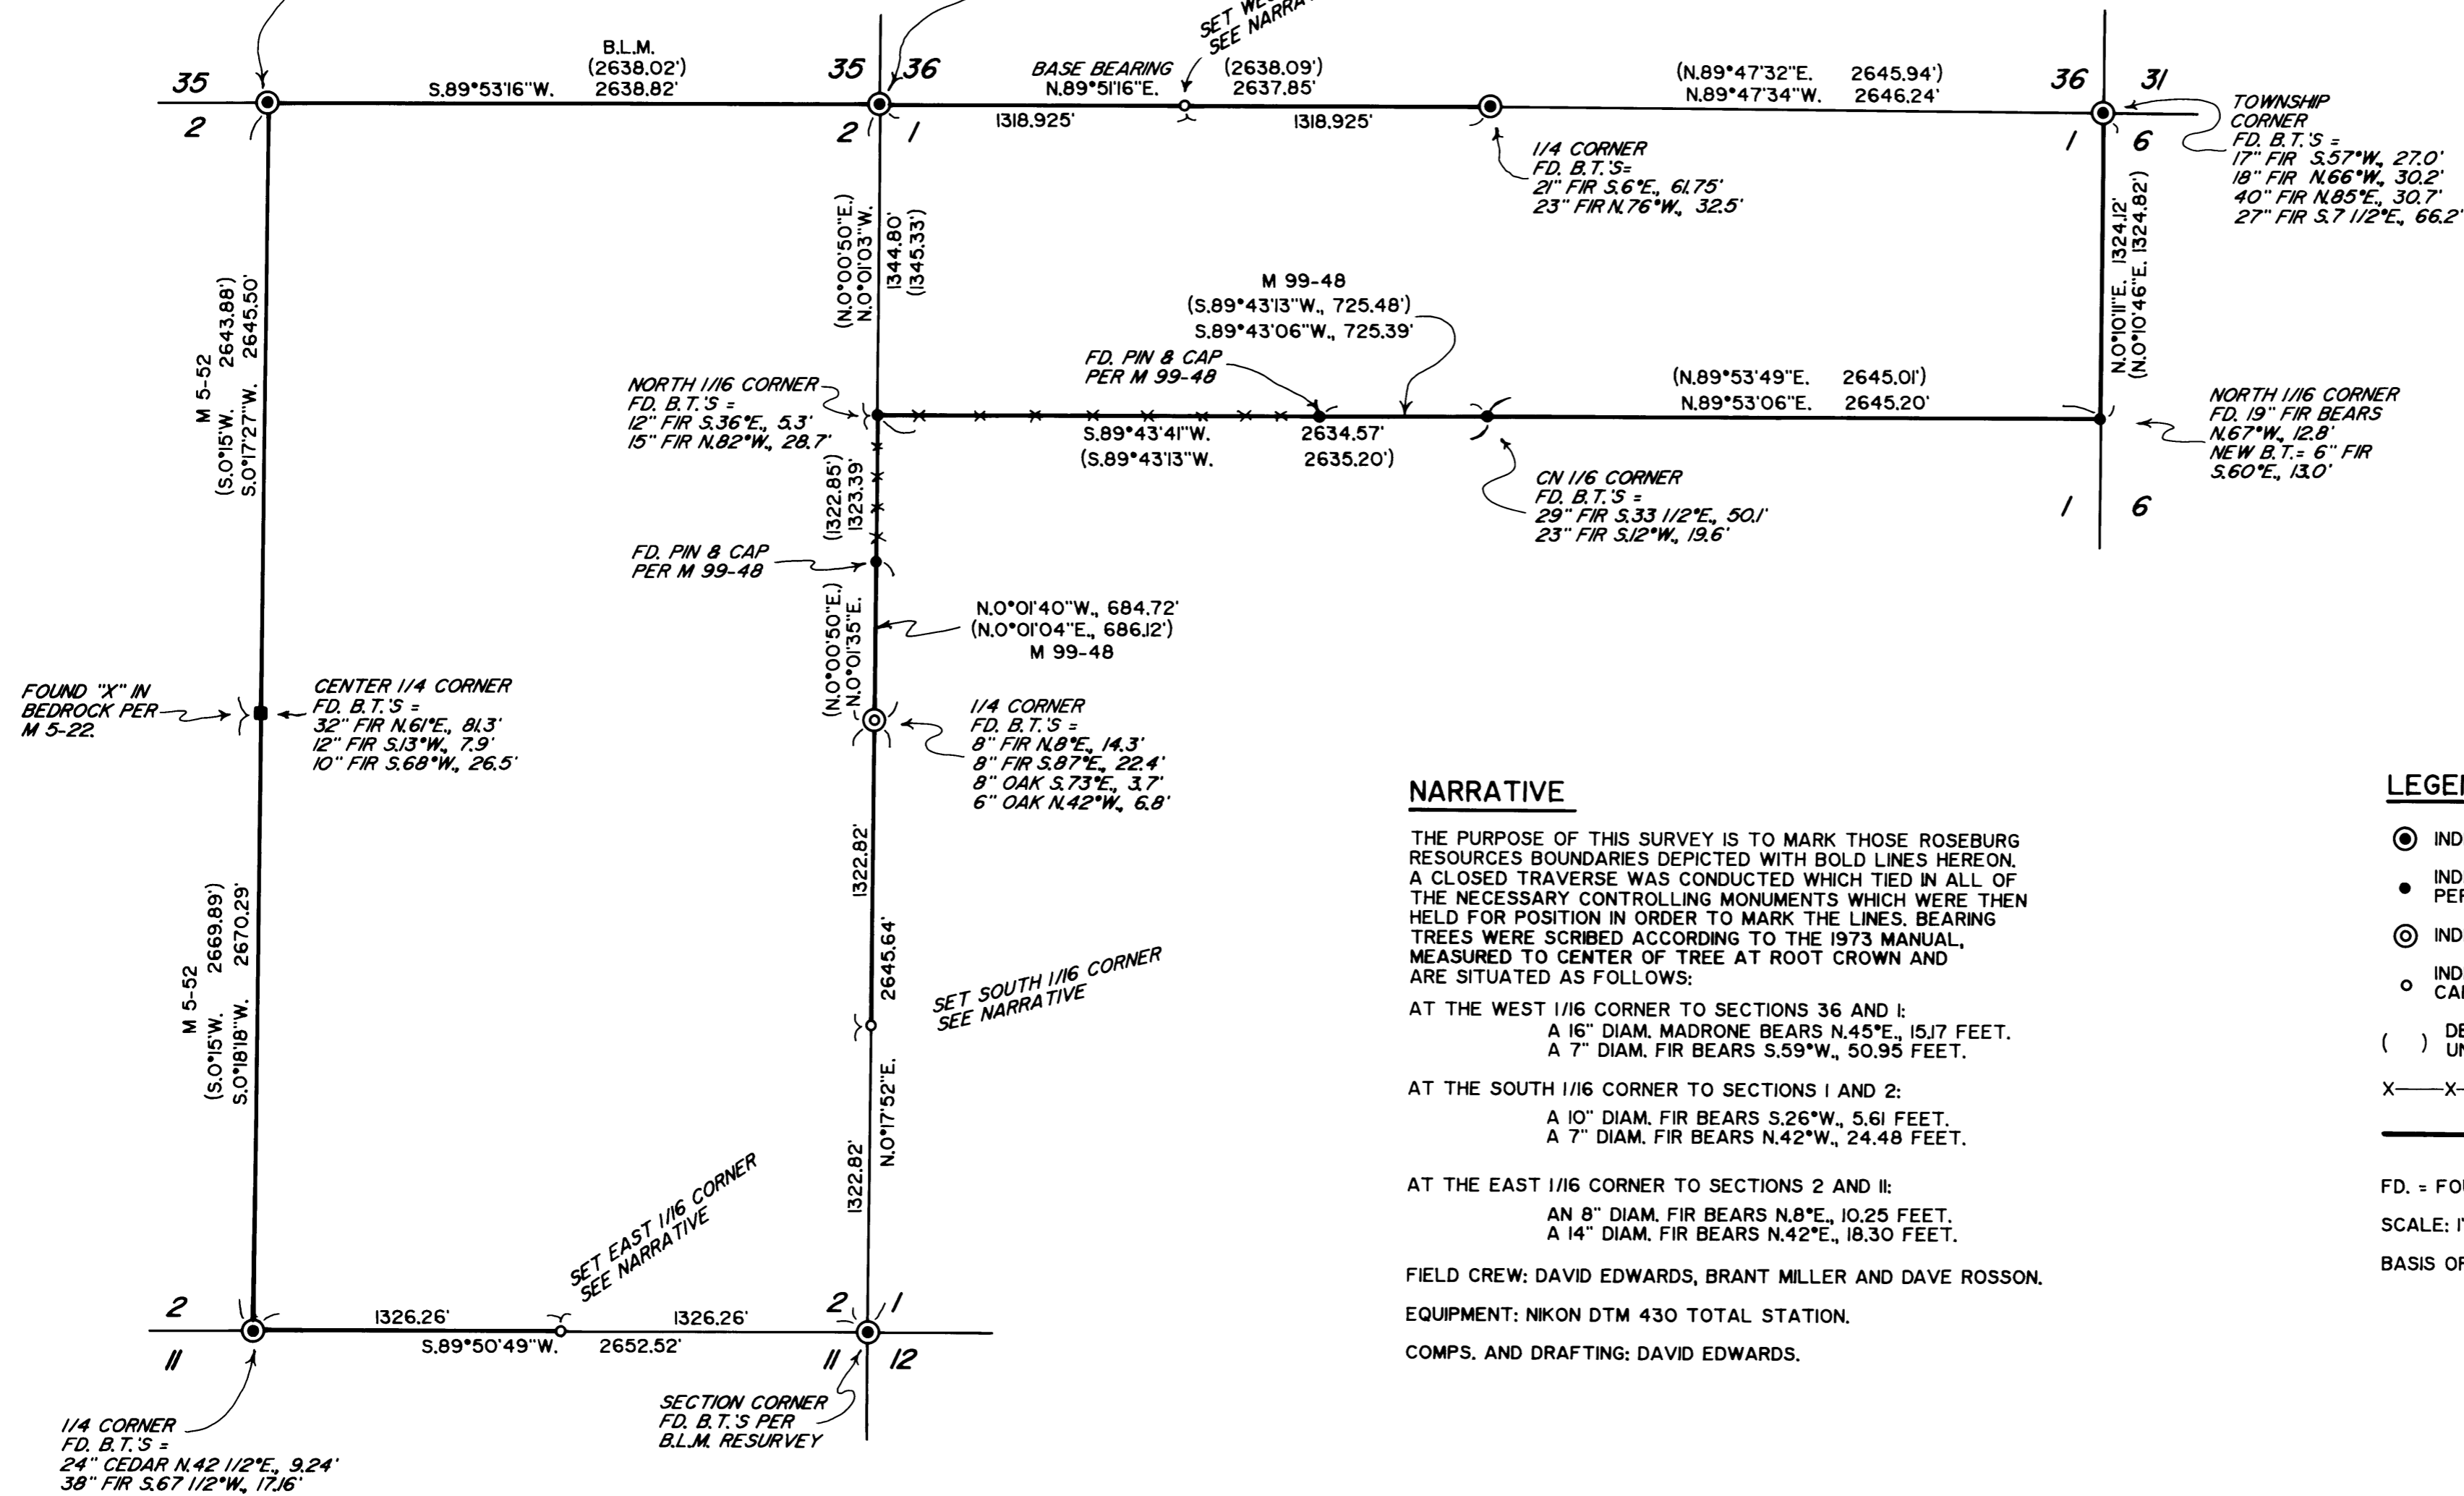

## NARRATIVE

THE PURPOSE OF THIS SURVEY IS TO MARK THOSE ROSEBURG RESOURCES BOUNDARIES DEPICTED WITH BOLD LINES HEREON. A CLOSED TRAVERSE WAS CONDUCTED WHICH TIED IN ALL OF THE NECESSARY CONTROLLING MONUMENTS WHICH WERE THEN HELD FOR POSITION IN ORDER TO MARK THE LINES. BEARING TREES WERE SCRIBED ACCORDING TO THE 1973 MANUAL, MEASURED TO CENTER OF TREE AT ROOT CROWN AND ARE SITUATED AS FOLLOWS:

AT THE WEST 1/16 CORNER TO SECTIONS 36 AND 1:  
A 16" DIAM. MADRONE BEARS N.45°E., 15.17 FEET.  
A 7" DIAM. FIR BEARS S.59°W., 50.95 FEET.

AT THE SOUTH 1/16 CORNER TO SECTIONS 1 AND 2:  
A 10" DIAM. FIR BEARS S.26°W., 5.61 FEET.  
A 7" DIAM. FIR BEARS N.42°W., 24.48 FEET.

AT THE EAST 1/16 CORNER TO SECTIONS 2 AND 11:  
AN 8" DIAM. FIR BEARS N.8°E., 10.25 FEET.  
A 14" DIAM. FIR BEARS N.42°E., 18.30 FEET.

FIELD CREW: DAVID EDWARDS, BRANT MILLER AND DAVE ROSSON.

EQUIPMENT: NIKON DTM 430 TOTAL STATION.

COMPS. AND DRAFTING: DAVID EDWARDS.

## LEGEND

- ⊙ INDICATES G.L.O. OR B.L.M. BRASS CAP FOUND.
- INDICATES 1" DIAM. I PIPE WITH BRASS CAP FOUND PER M 49-38 UNLESS NOTED OTHERWISE.
- ⊙ INDICATES "T-IRON" FOUND PER M 5-52.
- INDICATES 5/8" X 40" STEEL PIN WITH ALUMINUM CAP MKD. PER MANUAL, "L.S. 2339" AND "2002" SET.
- ( ) DENOTES RECORD DATA PER M 49-38 UNLESS NOTED OTHERWISE.
- X—X—X FENCE LINE
- INDICATES LINE BLAZED, POSTED AND FLAGGED THIS SURVEY.

FD. = FOUND.

SCALE: 1" = 600'

BASIS OF BEARINGS: M 49-38 AS SHOWN.