

FILED
Date: 7/3/2002 By: JP

**RECORD OF SURVEY
FOR: SENECA JONES TIMBER CO.
SEC. 10, T21S, R6W, W.M.
DOUGLAS COUNTY, OREGON**

This survey consists of:
Map: M 140-36
Narrative: _____
Corner Rpt: _____



**DOUGLAS COUNTY
SURVEYOR**

T21S R6W
S3 | S2
S10 | S11
1985

SECTION CORNER
FND: 2-1/2" DIA. B.L.M. BRASS CAP
MARKED AS SHOWN WITH THE
FOLLOWING ACCESSORIES;
11" DOUGLAS FIR BEARS N40°E, 21-1/2LKS
12" DOUGLAS FIR BEARS S85°E, 30-1/2
LKS
17" DOUGLAS FIR BEARS N52°W, 23 LKS
18" HEMLOCK BEARS S56-1/2°W, 4 LKS

NOTE: ALL ARE 1985 BT'S WITH HEALED
FACE

NARRATIVE

THE PURPOSE OF THIS SURVEY WAS TO
MARK THE SECTION LINE WITH 5-1/2FT STEEL
FENCE POSTS AND BLAZED AND PAINTED
WITH RED PAINT AND FLAG WITH RED RIBBON.

AS PART OF OUR SURVEY WE SEARCHED FOR
BUT COULD NOT FIND THE 1/4 CORNER. THE
TRUE POSITION FOR THE MISSING 1/4
CORNER BASED ON A SINGLE PROPORTION
MEASUREMENT FALLS WITHIN A 16" DIAMETER
DOUGLAS FIR. I SET A WITNESS CORNER TO
THE 1/4 CORNER 12.0 FEET NORTH OF THE
TRUE POSITION FOR THE 1/4 CORNER.

THE BASIS OF BEARING FOR THIS SURVEY IS
THE BEARING OF THE SECTION LINE AS
ESTABLISHED BY THE 1884 G.L.O. SURVEY

THIS SURVEY WAS PERFORMED USING A
PENTAX TOTAL STATION.



(S0°00'00"W)
S0°00'00"W
2638.53
(40.0 CHAINS)



(S0°00'00"W)
S0°00'00"W
2638.53
(40.0 CHAINS)



BASIS OF BEARING - 1884 G.L.O. SURVEY - N0°00'00"E

T21S R6W
S10 | S11
S15 | S14
1979

SECTION CORNER
FND: 2-1/2" DIA. BRASS CAP MARKED AS
SHOWN WITH THE FOLLOWING
ACCESSORIES;
36" RED CEDAR BEARS S28-3/4°E, 22.0FT
(HEALED FACE)
24" HEMLOCK BEARS S2-1/4°W, 7.4FT
(HEALED FACE)
33" CEDAR SNAG BEARS N70°W, 6.6FT
(CHARED FACE)
28" HEMLOCK BEARS N55-1/4°W, 40.9FT
(HEALED FACE)
14" HEMLOCK BEARS N8°E, 23.1FT (HEALED
FACE)

T21S R6W
WC 1/4
S10 | S11
2002
LS 1091

WITNESS CORNER TO 1/4 CORNER

TRUE POSITION OF 1/4 CORNER FALLS
WITHIN A 16" FIR. I SET A WITNESS CORNER
TO THE TRUE POSITION FOR THE 1/4 CORNER
12.0 FEET NORTH OF SAID TRUE POSITION. I
SET A 2-1/2" DIA. ALUMINUM CAP ON A 5/8" X
36" REBAR MARKED AS SHOWN WITH THE
FOLLOWING ACCESSORIES;
23" DOUGLAS FIR BEARS N7-3/4°E, 20.4FT
14" DOUGLAS FIR BEARS S69-3/4°E, 15.9FT
9" DOUGLAS FIR BEARS S23-1/2°E, 5.6FT
16" DOUGLAS FIR BEARS S 1-1/2°E, 11.8FT
NOTE: ALL NEW BT'S SCRIBED "X BT"

REGISTERED
PROFESSIONAL
LAND SURVEYOR
Robert B. Ward Jr.
OREGON
ROBERT B. WARD JR.
JULY 30, 1976
LS 1091

EXPIRES: 6/30/04


LEGEND

- FOUND CORNER AS NOTED
- CORNER SET THIS SURVEY
- LINE POSTED AND BLAZED
- 1884 G.L.O RECORD DATA
- G.L.O. GENERAL LAND OFFICE

FILE NAME		
02-36.TRV		
SCALE	DATE	DRAWN BY
400 Ft/in	6-29-2002	RBW
JOB	REVISION	SHEET
02-36		1/1

This map drawn with TRAVERSE PC Software

PLOTTER:	HP DESIGNJET 500
INK:	BLACK C4810A
MEDIA:	CLEARPRINT DRAFTING VELLUM TRANSLUCENT-100% NEW COTTON FIBER SOLVENT FREE

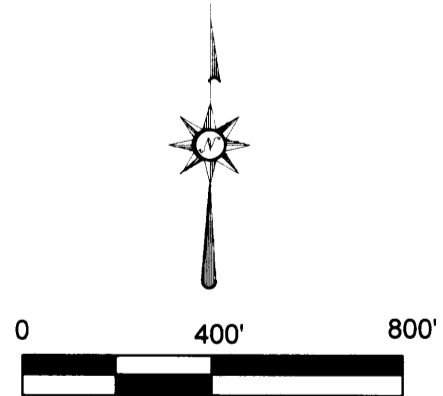

Ward NorthWest, Inc.
P.O. BOX 105 FLORENCE, OR 97439
(541) 997-9201 FAX: 541-997-3546