

FILED

Date: 11/4/2002 By: JP

This survey consists of:

Map: M141-11

Name: _____

Corner Rpt. _____

DOUGLAS COUNTY SURVEYOR

BOUNDARY LINE SURVEY
LOCATED IN SECTION 20, T.28S., R.8W., W.M.
DOUGLAS COUNTY, OREGON

SURVEY FOR:

SENECA JONES TIMBER COMPANY
P.O. BOX 2129
ROSEBURG, OR 97470

SURVEY BY:


MULKINS & RAMBO, LLC
P.O. BOX 809
NORTH BEND, OR 97459

REGISTERED
PROFESSIONAL
LAND SURVEYOR

Troy Rambo
OREGON
JULY 14, 1998
TROY J. RAMBO
2865

RENEWAL 12-31-2002

SCALE 1" = 400'
SEPTEMBER 19, 2002

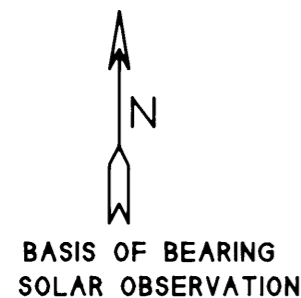

FD. A 1975 BLM
BRASS CAP 1/4

20 21

FD. A 12" DF WITH A HEALED FACE - BEARS N86°E. 14 1/2 LKS.
FD. AN 18" DF WITH A HEALED FACE - BEARS S89 1/2°W. 26 LKS.
SCRIBED 1/4 S20 BT ON A 16" DF - BEARS S36°W. 28.6 FT.
SCRIBED 1/4 S21 BT ON A 17" DF - BEARS S24°E. 14.1 FT.

(N0°06'W - 40.78 CHS.)
S0°10'28"E
2683.97

LEGEND

● FD. CORNER AS SHOWN

— LINE FLAGGED, BLAZED, &
POSTED WITH 6' STEEL POSTS

() RECORD BEARING/DISTANCE

FD. A 14" BM WITH A HEALED FACE - BEARS N16°W. 20 LKS.
FD. A 45" DF WITH A HEALED FACE - BEARS S30°E. 38 LKS.
FD. A 15" CHINQUAPIN WITH A HEALED FACE - BEARS S34 1/2°W. 39 LKS.
FD. A STEEL FENCE POST - BEARS S21°E. 1.5 FT.
THE REMAINING RECORD BT'S - DOWN
THERE ARE NO OTHER TREES WITHIN A REASONABLE DISTANCE.

NARRATIVE

THE PURPOSE OF THIS SURVEY WAS TO MARK THE LINE BETWEEN THE EXISTING CORNER AS SHOWN. CONTROL FOR THIS SURVEY WAS BASED ON: DEPENDENT RESURVEY, PORTION OF SUBDIVISIONAL LINES. T.28S., R.8W., W.M., OREGON.

ALL NEW BEARING TREES WERE MEASURED TO A 6" SPIKE AT SIDE CENTER BASE UNLESS OTHERWISE NOTED. BEARINGS WERE MEASURED WITH A HAND COMPASS WITH A DECL. OF 17°E. ALL OF THE FOUND BT'S WERE PAINTED WITH RED PAINT AND NEW TAGS WERE ADDED IF NEEDED.

THE FIELD WORK WAS PERFORMED BETWEEN AUGUST 20, AND SEPTEMBER 18, 2002 BY TROY RAMBO, CLYDE MULKINS, AND BERNIE ALTENBACH.

20 21
29 28

FD. A 1957 D.S.C.O.
BRASS CAP

MAP FILE M141-11

MAP FILE M141-11