

FILED

Date: 6/5/2003 By: JIP

This survey consists of:

Map: M 142-31

Narrative: _____

Corner Rpt: _____

DOUGLAS COUNTY
SURVEYOR



SURVEY FOR:

SENECA JONES TIMBER COMPANY
P.O. BOX 2129
ROSEBURG, OR 97470

SURVEY BY:

MULKINS & RAMBO, LLC
P.O. BOX 809
NORTH BEND, OR 97459

BOUNDARY SURVEY
LOCATED IN THE E1/2 SECTION 36. T.31S.. R.4W.. W.M..
DOUGLAS COUNTY, OREGON

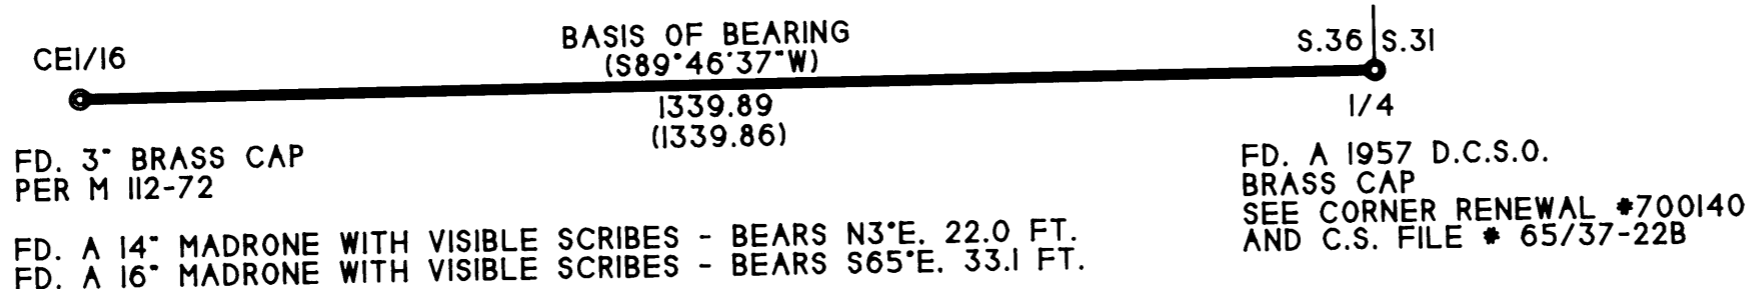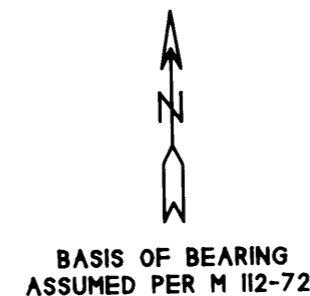

REGISTERED
PROFESSIONAL
LAND SURVEYOR

Troy Rambo
OREGON
JULY 14, 1998
TROY J. RAMBO
2865

EXPIRES 12-31-04

MAY 16, 2003
SCALE 1" = 200'

NARRATIVE

IN JUNE OF 2001 THE LINE BETWEEN THE E1/4 AND THE CEI/16 WAS MARKED FOR FUTURE FOREST OPERATIONS. AT THIS TIME OUR CLIENT REQUESTED THAT WE RECORD THIS MAP SHOWING WHAT WAS FOUND AND WHAT WAS DONE. CONTROL WAS BASED ON M 112-72 AND CORNER RENEWAL # 700140. THE E1/4 CORNER WAS UPGRADED AT THE TIME AND THE CORNER NOTES ARE RECORDED AS C.S. FILE 65/37-22B.

ALL NEW BEARING TREES WERE MEASURED TO A 6" SPIKE AT SIDE CENTER BASE. BEARINGS WERE MEASURED WITH A HAND COMPASS WITH A DECLINATION OF 17° EAST.

THE FIELD WORK WAS PERFORMED BETWEEN BY TROY RAMBO, CLYDE MULKINS, AND BERNIE ALTENBACH.

LEGEND

⊙ FD. CORNER AS SHOWN

— LINES FLAGGED, BLAZED, AND MARKED WITH 5 1/2' STEEL FENCE POSTS

() RECORD BEARING/DISTANCE

MAP FILE M 142-31

MAP FILE M 142-31