


BOUNDARY SURVEY  
LOCATED ALONG THE S1/2 OF THE EAST LINE SECTION 8.  
T.22S., R.7W., W.M., DOUGLAS COUNTY, OREGON

FILED

Date: 4/2/2004 By: JP  
This survey consists of:  
Map: M 144-19  
Narrative:  
Corner Rep:

DOUGLAS COUNTY  
SURVEYOR

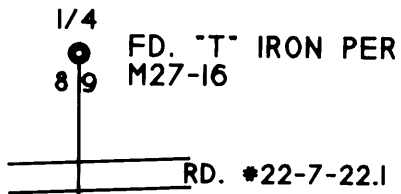


SURVEY FOR:

SENECA JONE TIMBER COMPANY  
P.O. BOX 10256  
EUGENE, OR 97440

SURVEY BY:

MULKINS & RAMBO, LLC  
P.O. BOX 809  
NORTH BEND, OR 97459

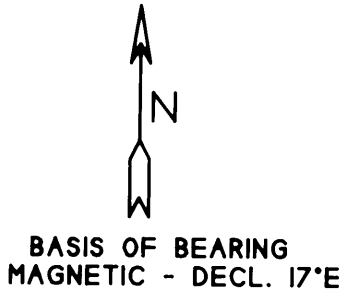

REGISTERED  
PROFESSIONAL  
LAND SURVEYOR

*Troy Rambo*  
OREGON  
JULY 14, 1998  
TROY J. RAMBO  
2865

EXPIRES 12-31-04

MARCH 15, 2004  
SCALE 1" = 200'

N0°30'22"W 2643.4

LEGEND

⊙ FD. CORNER AS SHOWN

——— LINES FLAGGED, BLAZED, AND MARKED  
WITH 5 1/2' STEEL FENCE POSTS

— · — · — · EXISTING FENCE

NARRATIVE

THE OF THIS SURVEY WAS TO MARK THE LINES BETWEEN THE CORNERS SHOWN FOR FUTURE FOREST OPERATIONS.  
CONTROL WAS BASED ON M27-16, C.S. FILE 52/14 & 51/309.  
THE FOUND "T" IRON AT THE 1/4 CORNER BETWEEN SECTIONS 8 AND 9 WAS ACCEPTED IN THIS SURVEY AS THE BEST AVAILABLE POSTION AT THIS TIME BECAUSE OF IT'S USE IN PREVIOUS SURVEYS.  
ALL NEW BEARING TREES WERE MEASURED TO A 6" SPIKE AT SIDE CENTER BASE. BEARINGS WERE MEASURED WITH A HAND COMPASS WITH A DECLINATION OF 17° EAST.  
THE FIELD WORK WAS PERFORMED BETWEEN BY TROY RAMBO, JOSH WALLMAN, AND MATT MARTIN BETWEEN FEBRUARY 28 AND MARCH II, 2004.

DID NOT FIND THE RECORD BT'S

- 1/4 SCRIBED "1/4 S8 BT" ON A 9" DF - BEARS N11°W, 11.0 FT.
- 8/9 SCRIBED "1/4 S8 BT" ON A 10" DF - BEARS S66°W, 11.5 FT.
- 8/9 SCRIBED "1/4 S9 BT" ON A 12" DF - BEARS S76°E, 18.3 FT.
- 8/9 SCRIBED "1/4 S9 BT" ON AN 11" DF - BEARS S40°E, 13.5 FT.

- 8/9 FD. THE RECORD BT'S IN PLACE
- 17/16 THE RECORD 4" DF - S25°E, 25.8 FT. - NOW A SNAG
- SCRIBED "S16 BT" ON A 10" DF - BEARS S25°E, 15.4 FT.

FD. 1962 D.C.S.O.  
BRASS CAP

