

COMMON BOUNDARY LINE ADJUSTMENT

LAND PARTITION 1999-14

MT. NEBO TRACTS
In SE1/4NE1/4, Sec 22, T27S, R6W,WM
In the City of Roseburg

SCALE: 1" = 50'

FILED

Date: 5-12-2004 By: JC

This survey consists of:

Map: M144-39

Narrative:

Corner Rpt:


DOUGLAS COUNTY
SURVEYOR

MONUMENTS

- SET MONUMENT 5/8"x30" I.R. WITH PLASTIC CAP MARKED: ME FARR LS 1181
- FOUND MONUMENT 5/8" I.R. OR AS NOTED
- ▽ COMPUTED LOCATION, NO MONUMENT SET

OWNER

LOOKINGGLASS INVESTMENTS, LLC
16657 SELBY DRIVE
SAN LEANDRO, CA 94578

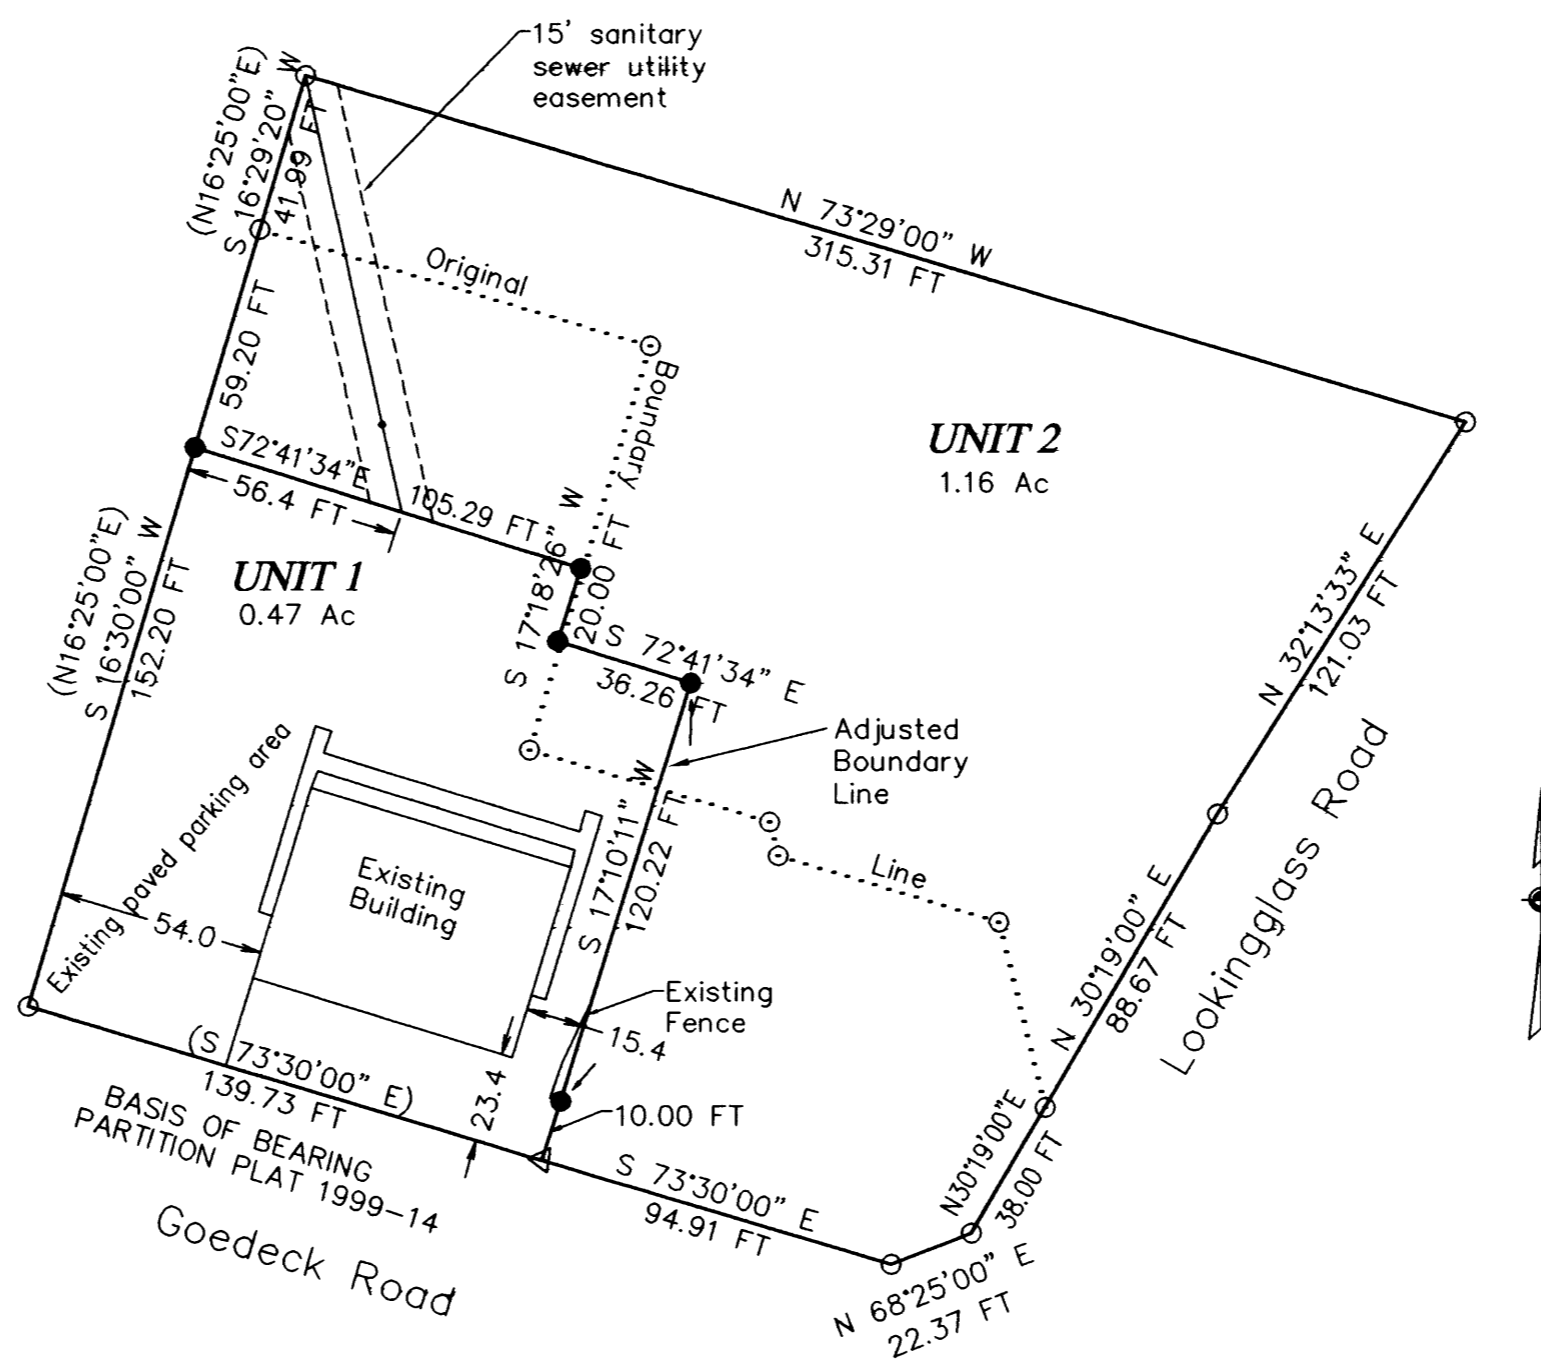

APPROVAL :

[Signature]
COMMUNITY DEVELOPMENT DIRECTOR
CITY OF ROSEBURG.

4-30-04

DATE

REGISTERED
PROFESSIONAL
LAND SURVEYOR

Maurice E. Farr
OREGON
SEPT 23, 1977
MAURICE E. FARR
1181 2-09-04

EXPIRES 12-31-05

SURVEYOR

MAURICE E FARR
PROFESSIONAL LAND SURVEYOR
395 NE KIRBY AVENUE
ROSEBURG, OR 97470

PH (541) 957-9442

FEBRUARY 2004

BLA-03-11

MAP FILE M144-39

MAP FILE M144-39