


NARRATIVE:
THE PURPOSE OF THIS MAP IS TO MONUMENT CORNERS AS DELINEATED ON THIS SURVEY.
PROCEDURE WAS AS FOLLOWS:
MONUMENTS OF RECORD PER M129-23 AND PARTITION PLAT 2000-0092, AS RECORDED IN THE PLAT RECORDS OF DOUGLAS COUNTY, WERE TIED AND HELD AS SHOWN. WE THEN SET MONUMENTS AS SHOWN.

- ① W 1/16 CORNER SECTIONS 16/21 FOUND BRASS CAP AND ACCESSORIES PER PLSS # 320400
- ② 1/4 CORNER SECTIONS 16/21 FOUND DCSO BRASS CAP PER PLSS # 340400 BENT, LOCATION WAS TAKEN WHERE PIPE WENT INTO THE GROUND.
BEARING OBJECTS:
FOUND 30" DOUGLAS FIR SNAG N59°E, 22.3'
FOUND 48" DOUGLAS FIR S45°E, 42.6'
NEW 16" DOUGLAS FIR N50°W, 9.2'
NEW 14" DOUGLAS FIR N90°W, 20.8'
NEW 14" DOUGLAS FIR S28°W, 21.4'
ALL NEW BT.'S SCRIBED "1/4 S BT"
- ③ CN 1/16 CORNER SECTION 20 FOUND 5/8" IRON ROD PER M129-23.
BEARING OBJECTS:
FOUND 14" DOUGLAS FIR N44°E, 11.0'
FOUND 14" CEDAR N13°W, 14.6'
PARTIAL SCRIBING VISIBLE ON BOTH BT.'S
- ④ N 1/16 CORNER SECTIONS 20/21 FOUND 5/8" IRON ROD AND ACCESSORIES PER M129-23.
- ⑤ NW 1/16 CORNER SECTION 21 FOUND 5/8" IRON ROD PER M129-23.
BEARING OBJECTS:
FOUND DOWN 10" DOUGLAS FIR N90°E, 51.7'
FOUND 13" CEDAR S8°E, 101.3'
NEW 9" ALDER N79°W, 9.5'
- ⑥ CN 1/16 CORNER SECTION 21 SET 5/8" IRON ROD.
BEARING OBJECTS:
NEW 10" MADRONE N23°W, 10.7'
NEW 6" MADRONE N55°E, 16.3'
BOTH BT.'S SCRIBED "CN 1/16 BT"
- ⑦ 1/4 CORNER SECTION 20/21 FOUND DCSO BRASS CAP PER PLSS # 300340
BEARING OBJECTS:
FOUND 26" MADRONE S20°W, 123.4'
FOUND 28" RED FIR STUMP S73°E, 44.8'
FOUND 20" CEDAR STUMP S71°W, 55.5'
NEW 14" CEDAR S69°E, 23.6'
NEW 7" CEDAR N74°E, 13.9'
NEW 16" CEDAR S32°W, 72.1'
NEW BT.'S SCRIBED "1/4 S BT"
- ⑧ CS 1/16 CORNER SECTION 20 SET 5/8" IRON ROD.
BEARING OBJECTS:
NEW 8" DOUGLAS FIR S69°W, 6.8'
NEW 10" MADRONE N65°E, 30.7'
BOTH BT.'S SCRIBED "CN 1/16 BT"
- ⑨ S 1/16 CORNER SECTION 20/21 SET 5/8" IRON ROD.
BEARING OBJECTS:
NEW 12" PINE S40°W, 57.0'
NEW 12" PINE N2 1/2°E, 81.0'
BOTH BT.'S SCRIBED "1/16 S BT"
- ⑩ 1/4 CORNER SECTION 20/29 FOUND 5/8" IRON ROD PER M129-23.
BEARING OBJECTS:
FOUND 11" DOUGLAS FIR N26°E, 9.5'
FOUND 6" TAN OAK S81°E, 4.5'
HEALED FACES ON BOTH FOUND BT.'S
NEW 10" DOUGLAS FIR S30°W, 4.0'
NEW BT SCRIBED "1/4 S BT"
- ⑪ SECTION CORNER 20/21/28/29 FOUND DCSO BRASS CAP PER PLSS # 300300
BEARING OBJECTS:
FOUND ROTTED DOUGLAS FIR S13°E, 22.0'
FOUND 19" MADRONE N18°E, 18.0'
FOUND 19" PINE N27°W, 105.3'
HEALED FACES ON BOTH FOUND BT.'S
- ⑫ 1/4 CORNER SECTIONS 21/28 FOUND DCSO BRASS CAP PER PLSS # 340300
BEARING OBJECTS:
FOUND 21" MADRONE S43°W, 17.2' HEALED FACE
FOUND 8" MADRONE N34°E, 12.1' HEALED FACE
FOUND 21" MADRONE S80°E, 66.0' SCRIBE VISIBLE
FOUND 19" OAK N19°W, 77.1' SCRIBE VISIBLE
- ⑬ SECTION CORNER 21/22/27/28 FOUND DCSO BRASS CAP PER PLSS # 400300
BEARING OBJECTS:
FOUND 7" MADRONE S16°E, 23.7' HEALED FACE
FOUND 24" OAK N39°E, 12.8' HEALED FACE
FOUND 12" OAK S59°W, 27.5' HEALED FACE
FOUND 27" OAK N48°W, 36.6' CHOPPING VISIBLE
- ⑭ NW CORNER DLC NO. 49 FOUND DCSO BRASS CAP PER PLSS # 049020
BEARING OBJECTS:
FOUND 40" WHITE OAK S0°E, 171.8' HEALED FACE
FOUND 42" OAK N83 1/2°E, 124.0' HEALED FACE
FOUND 9" MADRONE S61°E, 41.2' VISIBLE SCRIBE
FOUND 12" PINE S30°E, 33.6' HEALED FACE
- ⑮ CN 1/16 CORNER SECTION 28 SET 5/8" IRON ROD.
BEARING OBJECTS:
NEW 5" MADRONE S28°E, 7.2'
NEW 11" MADRONE N3°E, 11.4"
BOTH BT.'S SCRIBED "CN 1/16 BT"
- ⑯ SECTION CORNER 28/29/32/33 FOUND BRASS CAP AND ACCESSORIES PER PLSS # 300200
- ⑰ SW CORNER DLC NO. 49 FOUND DCSO BRASS CAP PER PLSS # 049030
BEARING OBJECTS:
FOUND 28" BLACK OAK S77°W, 103.5' HEALED FACE
FOUND 5/8" IRON ROD WITH ALUMINUM CAP S31°W, 43.9'
- ⑱ SECTION CORNER 27/28/33/34 FOUND DCSO BRASS CAP AND ACCESSORIES PER PLSS # 400200
- ⑲ PROPERTY CORNER, SET 5/8" IRON ROD.
BEARING OBJECTS:
NEW 4 1/2" MADRONE S70°W, 9.2'
NEW 6" MADRONE S9°E, 28.6'
BOTH BT.'S SCRIBED "RPPC"

NOTES:
1) DCSO DENOTES DOUGLAS COUNTY SURVEYORS OFFICE.
2) PLSS DENOTES PUBLIC LAND SURVEY SYSTEM, SEE DCSO RECORDS FOR INFORMATION.
3) BT DENOTES BEARING TREE.

LEGEND:
● SET 5/8" x 30" IRON ROD w/CAP MARKED "I.E. ENGINEERING" UNLESS OTHERWISE NOTED
○ FOUND 5/8" IRON ROD UNLESS OTHERWISE NOTED
△ FOUND BRASS CAP AS NOTED
▲ CALCULATED POSITION
(R1) RECORD AS PER PP 2000-0092
(R2) RECORD AS PER M129-23
(R3) RECORD AS PER M109-2

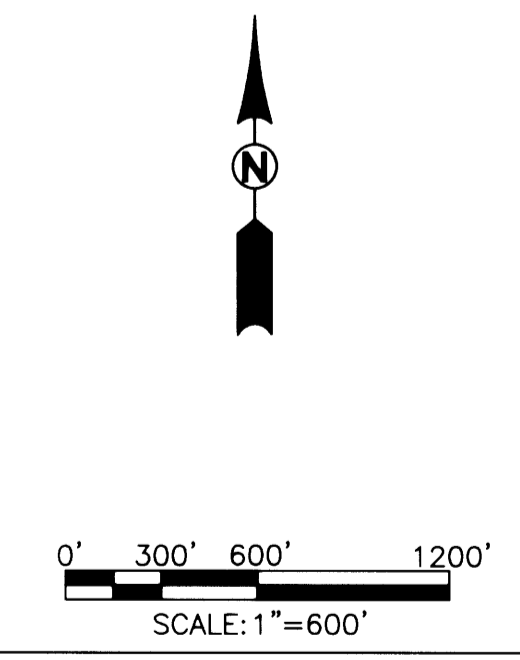

FIELD CREW: BILL GOODSON, MIKE FROMDAHL, RICHARD OLSON, DEREK FEIGEL AND JEREMY LEONARD
EQUIPMENT: NIKON AND TOPCON TOTAL STATIONS WITH TDS RANGER DATA COLLECTORS
OFFICE: RYAN PALMER
DRAFTING: RYAN PALMER

| | | |
|--|--|---|
| REGISTERED PROFESSIONAL LAND SURVEYOR | RECORD OF SURVEY LYING IN THE E 1/2 OF SEC 20, W 1/2 OF SEC 21, AND SEC 28, T 30 S, R 6 W, WILLAMETTE MERIDIAN, DOUGLAS COUNTY, OREGON | |
| | SURVEYED FOR: GUY KENNERLY 808 SE LANE STREET ROSEBURG, OR 97470 | SURVEYED BY: 809 SE Pine Street Roseburg, Oregon 97470 PHONE (541) 673-0166 FAX (541) 440-9392 EMAIL iemal@ieengineering.com |
| SCALE: AS SHOWN | JOB NO: 2141-04 DATE: APRIL, 2008 | DWG. BY: RNP PM: RAQ PAGE: 1 OF 1 |