


MAP FILE M147-62


FILED
Date: 5-20-2005 By: JC
This survey consists of:
Map: M147-62
Name:
Corner type:

DOUGLAS COUNTY
SURVEYOR

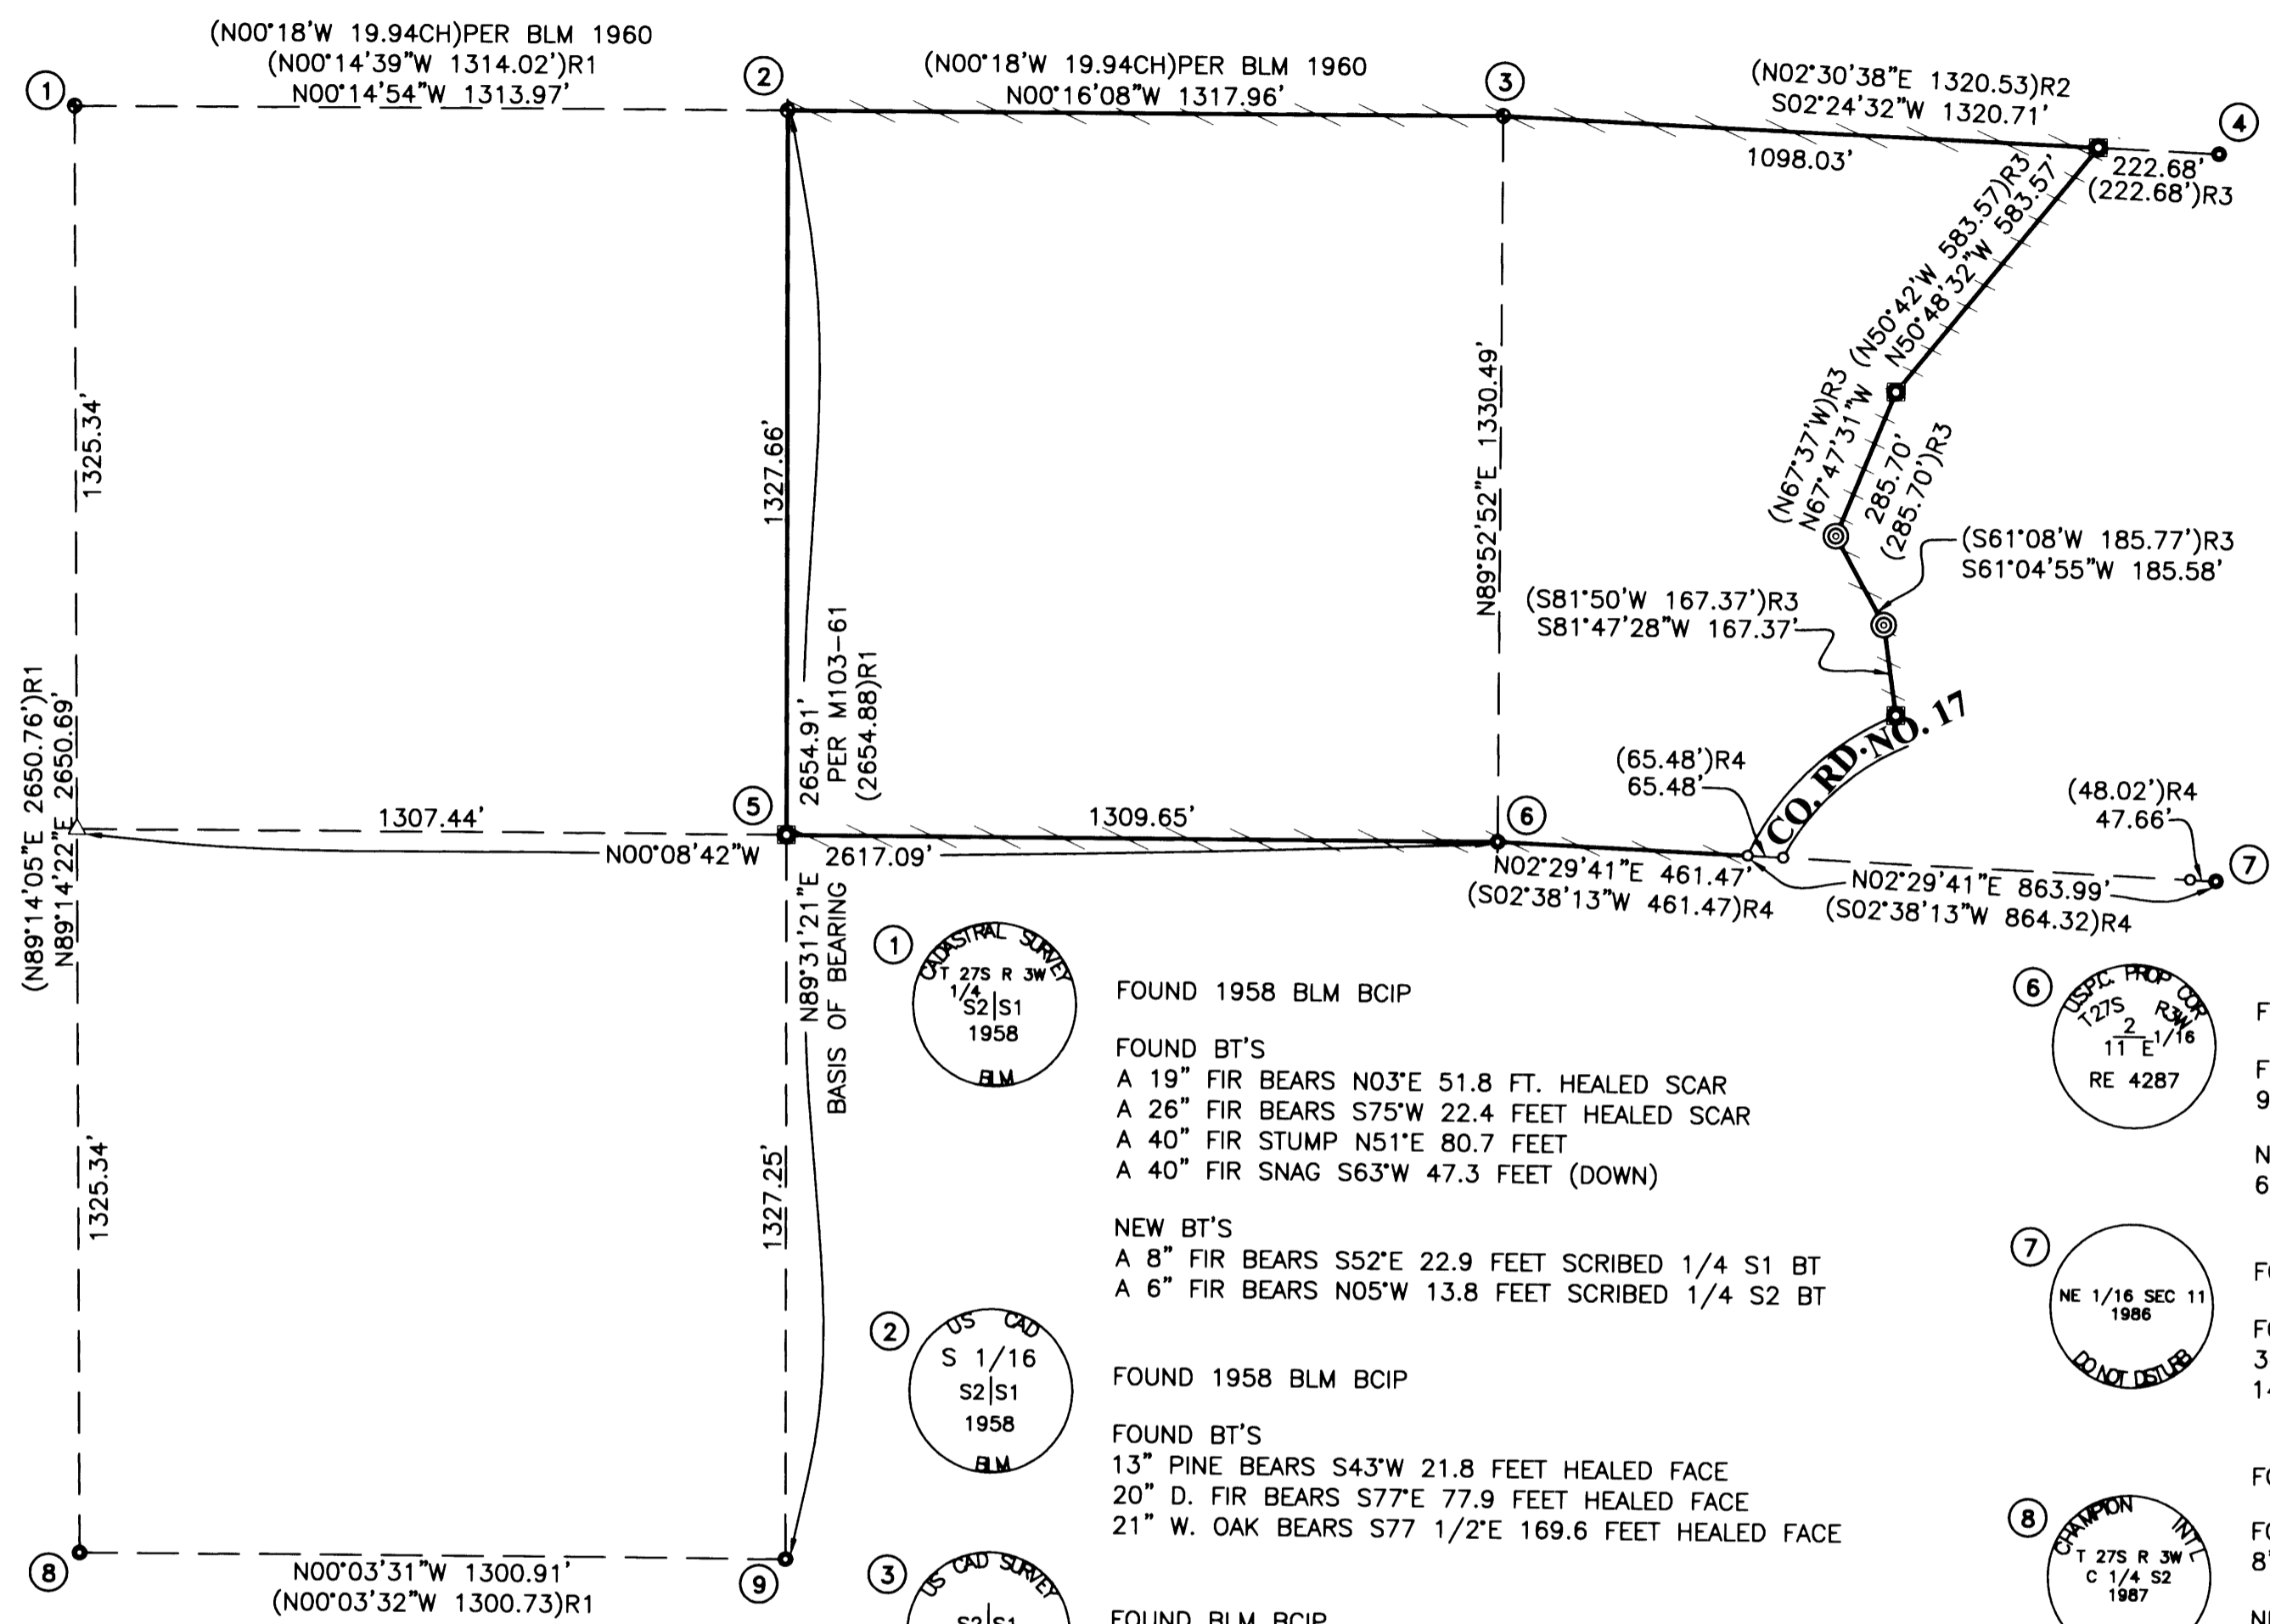


NARRATIVE:


THE PURPOSE OF THIS SURVEY WAS TO MONUMENT AND MARK LINES OF THAT LAND DESCRIBED IN DEED INSTRUMENT NUMBER 2001-30186 OF THE DOUGLAS COUNTY DEED RECORDS. THE PROCEDURE WAS AS FOLLOWS: WE TIED AND HELD EXISTING MONUMENTS OF RECORD AS SHOWN. THE CENTER-EAST 1/16 CORNER OF SECTION 2, T27S, R3W WAS CALCULATED BY HOLDING THE MIDPOINT OF A LINE BETWEEN FOUND MONUMENTS AT THE 1/4 CORNER COMMON TO SECTIONS 1 AND 2 AND THE CENTER 1/4 CORNER OF SECTION 2, T27S, R3W AS SHOWN. THE SOUTHEAST 1/16 CORNER WAS CALCULATED AND MONUMENTED BY INTERSECTING LINES BETWEEN SAID CALCULATED CENTER-EAST 1/16 CORNER & THE EAST 1/16 CORNER COMMON TO SECTIONS 2 AND 11, T27S, R3W AND MONUMENTS FOUND AT THE CENTER-SOUTH 1/16 CORNER OF SECTION 2 & THE SOUTH 1/16 CORNER COMMON TO SECTIONS 1 AND 2, T27S, R3W AS SHOWN. A MONUMENT WAS CALCULATED AND SET AT THE INTERSECTION OF THE NORTHERLY BOUNDARY OF THAT LAND DESCRIBED AS PARCEL 1 OF INSTRUMENT NUMBER 74-3795 OF THE DOUGLAS COUNTY DEED RECORDS AND THE COMMON BOUNDARY OF SECTIONS 11 AND 12, T27S, R3W BY HOLDING RECORD DISTANCE NORTHERLY FROM THE NORTH 1/16 CORNER COMMON TO SECTIONS 11 AND 12, T27S, R3W AS SHOWN. A MONUMENT WAS CALCULATED AND SET ON THE NORTHERLY BOUNDARY OF SAID LAND DESCRIBED AS PARCEL 1 BY HOLDING RECORD DISTANCES FROM SAID MONUMENT AT THE INTERSECTION OF SAID NORTHERLY BOUNDARY AND SAID COMMON BOUNDARY OF SAID SECTIONS 11 AND 12 AND A FOUND MONUMENT ON SAID NORTHERLY BOUNDARY AS SHOWN. A MONUMENT WAS SET ON THE NORTHERLY BOUNDARY OF SAID LAND DESCRIBED AS PARCEL 1 AT THE INTERSECTION OF SAID NORTHERLY BOUNDARY AND THE APPROXIMATE NORTHEASTERLY RIGHT-OF-WAY OF COUNTY ROAD NUMBER 17.

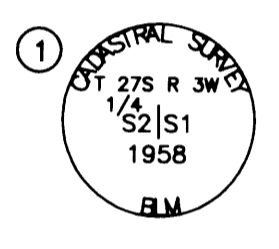


FOUND 1958 BLM BCIP
FOUND BT'S
A 19" FIR BEARS N03°E 51.8 FEET HEALED SCAR
A 26" FIR BEARS S75°W 22.4 FEET HEALED SCAR
A 40" FIR STUMP N51°E 80.7 FEET
A 40" FIR SNAG S63°W 47.3 FEET (DOWN)
NEW BT'S
A 8" FIR BEARS S52°E 22.9 FEET SCRIBED 1/4 S1 BT
A 6" FIR BEARS N05°W 13.8 FEET SCRIBED 1/4 S2 BT

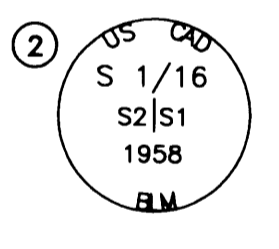


FOUND 1958 BLM BCIP
FOUND BT'S
13" PINE BEARS S43°W 21.8 FEET HEALED FACE
20" D. FIR BEARS S77°E 77.9 FEET HEALED FACE
21" W. OAK BEARS S77 1/2°E 169.6 FEET HEALED FACE

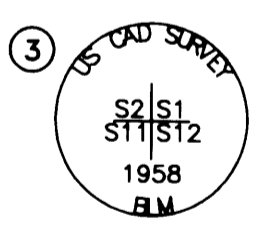


FOUND BLM BCIP
FOUND BT'S
34" FIR BEARS N30°E 105.0 FEET HEALED FACE
15" YEW BEARS N49°W 39.6 FEET VISIBLE SCRIBES
21" MAPLE BEARS N85°E 51.2 FEET HEALED FACE
24" FIR BEARS N7 1/2°W 45.8 FEET HEALED FACE
22" FIR BEARS S76°W 86.4 FEET HEALED FACE

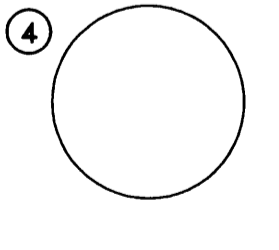


FOUND ALUMINUM CAP ON I.P. IN LOGGING ROAD (CAP NOT READABLE)
FOUND BT'S
A 12" CEDAR SNAG BEARS N22°W 24.0 FEET VISIBLE SCRIBES
18" D. FIR N49°E 52.4 FEET HEALED FACE
NEW BT
18" D. FIR N47°W 32.9 FEET SCRIBED 1/16 S11 BT

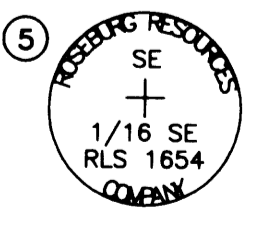


SET 2 1/2" ALUMINUM CAP ON IRON ROD
BT'S
10" D. FIR BEARS N53°W 11.5 FEET SCRIBED SE 1/16 S2 BT
16" D. FIR BEARS N4°E 20.0 FEET SCRIBED SE 1/16 S2 BT

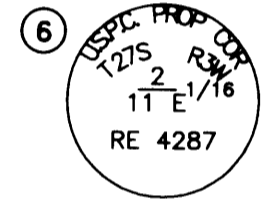


FOUND ALUMINUM CAP ON I.P.
FOUND BT'S
9" OAK BEARS N29°W 13.4 FEET VISIBLE SCRIBE
NEW BT
6" CEDAR BEARS N28°E 6.1 FEET SCRIBED E 1/16 S2 BT

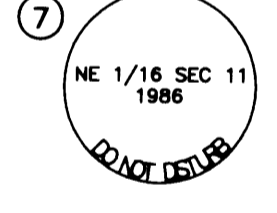

FOUND ALUMINUM CAP ON I.P.
FOUND BT'S
34" D. FIR N04°W 100.6 FEET
14" D. FIR N70°E 75.2 FEET

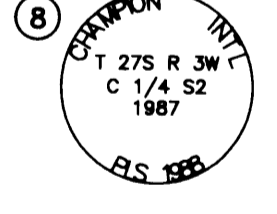


FOUND ALUMINUM CAP ON I.P.
FOUND BT
8" D. FIR BEARS S71°E 39.2 FEET HEALED FACE (NO RECORD)
NEW BT'S
5" OAK BEARS N34°W 49.8 FEET SCRIBE 1/4 S2 BT
4" OAK BEARS S53°W 6.0 FEET SCRIBED S BT
B.O.
SET 5/8" IRON ROD WITH YELLOW PLASTIC CAP MARKED "IE ENGINEERING"
BEARS N53°E 6.0 FEET.
NO TREES TO EAST SMALL OAK TO WEST

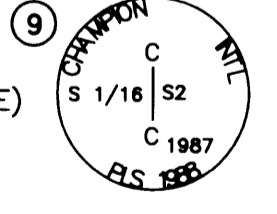

FOUND ALUMINUM CAP ON I.P.
FOUND BT'S
15" D. FIR BEARS N82°W 10.7 FEET HEALED FACE
19" D. FIR BEARS S11°E 12.5 FEET HEALED FACE

FIELD CREW: RYAN PALMER, MIKE FROMDAHL AND DEREK FEIGEL
EQUIPMENT: NIKON AND TOPCON TOTAL STATION AND TDS RECON DATA COLLECTOR
OFFICE: MICHAEL JONES
DRAFTING: JOE COOK

- LEGEND**
- SET 5/8" x 30" IR w/2 1/2" ALUMINUM CAP MARKED "ROSEBURG RESOURCES COMPANY" STAMPED RLS 1654
 - FOUND 5/8" IRON ROD w/ CAP MARKED "IE ENGINEERING" UNLESS OTHERWISE NOTED
 - △ CALCULATED POSITION
 - FOUND BRASS CAP
 - FOUND ALUMINUM CAP
 - ◎ FOUND 1" IRON PIPE
 - LINES MARKED THIS SURVEY
 - () R1 RECORD AS PER M103-61
 - () R2 RECORD AS PER M100-48
 - () R3 RECORD AS PER INST. NO. 74-3795
 - () R4 RECORD AS PER VOL. 18, PG. 41

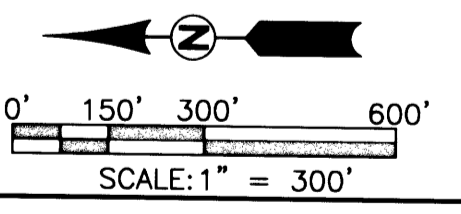

REGISTERED PROFESSIONAL LAND SURVEYOR <i>Ronald A. Gumbay</i> OREGON JULY 14, 1978 RONALD A. GUMBAY 1854 EXPIRES: 12/31/2006	BOUNDARY SURVEY LYING IN THE SE 1/4 OF SEC. 2 AND THE NE CORNER OF SEC. 11 T 27S, R 3W, WILLAMETTE MERIDIAN, DOUGLAS COUNTY, OREGON	
	SURVEYED FOR: ROSEBURG RESOURCES CO. P.O. BOX 1088 ROSEBURG, OR 97470	SURVEYED BY: i.e. ENGINEERING 741 SE Jackson Street Roseburg, Oregon 97470 PHONE (541) 673-0166 FAX (541) 440-9392 iemail@ieengineering.com
SCALE: AS SHOWN	DATE: MAY, 2005	DWG. BY: JAC JOB NO: 1851-05 PAGE: 1 OF 1

MAP FILE M147-62