

FILED
 Date: 9-22-2005 By: JC
 This survey consists of:
 Map: M148-50
 Narrative:
 Corner Ppt:
 DOUGLAS COUNTY
 SURVEYOR



SCALE 1"=200'

1/4 CORNER OF SECTIONS 34 AND 35

FOUND: 2-1/2" ALUMINUM PIPE WITH USBLM ALUMINUM CAP DATED 1984
 0.2' ABOVE GRADE
 7" FIR 61-1/2' E, 6.2 FEET WITH HEALED BLAZE
 RECORD S 61-1/2' E, 10 LKS. - 1984 BLM BT
 9" FIR S 67-1/2' W, 23.7 FEET WITH HEALED BLAZE
 RECORD S 67-1/2' W, 36 LKS. - 1984 BLM BT

MARKED NEW:
 10" FIR, N 85-1/2' E, 21.6 FEET TO STEEL SPIKE AT SIDE CENTER
 SCRIBED "1/4 S35 BT"
 12" FIR, S 8-1/2' W, 17.2 FEET TO STEEL SPIKE AT SIDE CENTER
 SCRIBED "1/4 S34 BT"

BASIS OF BEARING:
 SOUTH 1/2 MILE BETWEEN SECTIONS 34 AND 35
 PER 1987 BLM RESURVEY

LEGEND

- ⊙ - CORNERS FOUND - AS NOTED
- { } - RECORD DATA - 1854 GLO
- [] - RECORD DATA - 1983 BLM

REFERENCE SURVEYS AND DOCUMENTS

- M29-19
- C.S. FILE 56/43
- 1891 GLO SURVEY
- 1983 BLM RESURVEY

1/4 CORNER OF SECTION 34, ONLY

FOUND: 3 1/2" BRASS TABLET FIRMLY CEMENTED IN ORIGINAL STONE WITH USBLM CAP DATED 1983
 A STEEL T-POST, NORTH, 1.3 FEET
 RECORD NORTH, 1.1 FEET - 1965 M29-19
 32" FIR STUMP, N 77' W, 99.2 FEET WITH HEALED BLAZE
 RECORD N 77' W, 99.5 FEET - 1965 M29-19
 32" FIR STUMP, N 19' W, 99.6 FEET WITH HEALED BLAZE
 RECORD N 19' W, 99.6 FEET - 1974 DOUGLAS COUNTY SURVEY FILE 56/43
 14" FIR, N 87-1/2' E, 8.6 FEET WITH HEALED BLAZE
 RECORD N 87-1/2' E, 13 LKS. - 1983 BLM BT
 AN "X BO" CHISELED INTO SOLID ROCK, N 26' W, 76.5 FEET
 RECORD N 26' W, 116 LKS. - 1983 BLM

MARKED NEW: 5" FIR, N 4' W, 15.5 FEET TO STEEL SPIKE AT SIDE CENTER
 SCRIBED "1/4 S34 BT"
 10" FIR, N 48-1/2' W, 36.9 FEET TO STEEL SPIKE AT SIDE CENTER
 SCRIBED "1/4 S34 BT"

{S 89° W 17.25 CHS.}
 [S 88°14' W 17.00 CHS.]
 N 88°15'13" W 1122.25'

{S 89° W 22.75 CHS.}
 [S 88°14' W 22.41 CHS.]
 N 88°14'42" W 1478.65'

1/4 CORNER OF SECTION 3, ONLY, T 21S R7W

FOUND: 2-1/2" ALUMINUM PIPE WITH USBLM ALUMINUM CAP DATED 1984
 0.4' ABOVE GRADE
 12" FIR, S 56° E, 43.6 FEET WITH HEALED BLAZE
 RECORD S 56° E, 66 LKS. - 1983 BLM BT
 13" HEMLOCK, S 72' W, 19.1 FEET WITH HEALED BLAZE
 RECORD S 72' W, 29 LKS. - 1983 BLM BT

BT'S WERE RECOVERED IN GOOD CONDITION AND
 NO NEW BT'S MARKED THIS SURVEY

S34 S35

{N 00°00' W 40.00 CHS.}
 [N 00°28' W 39.71 CHS.]
 N 00°28'00" W 2621.01'

S34 S35 T 20 S
 T 21 S


NARRATIVE

THIS SURVEY WAS MADE IN SEPTEMBER, 2005 BY CRAIG L. WANLESS, OF D. WELLMAN SURVEYING LLC., 90686 NORTHROP DRIVE, EUGENE, OREGON. THE PURPOSE OF THIS SURVEY IS TO LOCATE AND MARK, IN THE FIELD, THE PROPERTY LINES OF SENECA JONES TIMBER COMPANY OWNERSHIP WITHIN SECTION 34, T20S, R7W, W.M. THIS SURVEY WAS PERFORMED AT THE REQUEST OF THE LANDOWNER. A LEICA TCR703 WAS USED TO PERFORM THE SURVEY, WITH A MINIMUM ERROR OF CLOSURE OF BETTER THAN 1:10,000 OF CLOSED LOOP TRAVERSE BEFORE A LEAST SQUARE ADJUSTMENT. THE BASIS OF BEARING FOR THIS SURVEY WAS THE BEARING FOR THE SOUTH 1/2 MILE BETWEEN SECTIONS 34 AND 35 AS SHOWN ON THE BLM SURVEY PLAT DATED 1987.

THE 1/4 CORNER OF SECTIONS 34 AND 35, THE 1/4 CORNER OF SECTION 34 ONLY AND THE CORNER OF SECTIONS 34 AND 35 ONLY, ON THE SOUTH BOUNDARY OF TOWNSHIP 20 SOUTH, RANGE 7 WEST, AND THE 1/4 CORNER OF SECTION 3 ONLY, TOWNSHIP 21 SOUTH, RANGE 7 WEST, WERE ALL FOUND TO BE UNDISTURBED AND ACCEPTED AS BEING IN PROPER POSITION.

THE TRUE PROPERTY LINES, AS SHOWN, WERE MARKED BY BLAZING TREES (BLAZES PAINTED RED) ON EITHER SIDE OF THE TRUE LINES, HANGING RED RIBBON, AND SETTING 6 FOOT STEEL FENCE POSTS AT RANDOM INTERVALS ALONG THE LINE. BEARING TREES ESTABLISHED OR TIED IN THIS SURVEY WERE BASED ON SOLAR OBSERVATION PER THE 1983 BLM RESURVEY AND DISTANCES WERE MEASURED TO SIDE CENTER.

GRAPHIC SCALE

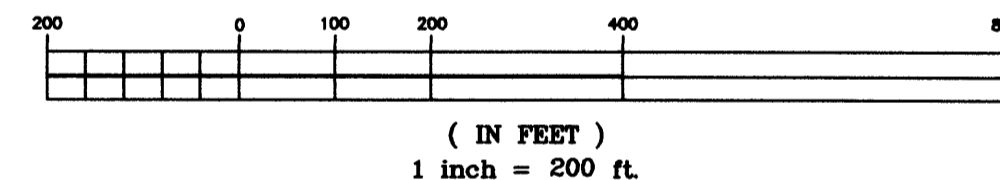

CORNER OF SECTIONS 34 AND 35 ONLY

FOUND: 2-1/2" ALUMINUM PIPE WITH USBLM ALUMINUM CAP DATED 1983
 0.4' ABOVE GRADE
 19" FIR, N 78-1/2' E, 12.9 FEET WITH HEALED BLAZE
 RECORD N 78-1/2' E, 20 LKS. - 1983 BLM BT
 16" FIR, N 34' W 18.5 FEET WITH HEALED BLAZE
 RECORD N 38-1/2' W, 28 LKS. - 1983 BLM BT

BT'S WERE RECOVERED IN GOOD CONDITION AND
 NO NEW BT'S MARKED THIS SURVEY

REGISTERED
 PROFESSIONAL
 LAND SURVEYOR

Craig L. Wanless

OREGON
 JULY 15, 1983
 CRAIG L. WANLESS
 2061

RENEWAL 6/30/06

SURVEY IN
 SECTION 34, T20S, R7W, W.M.
 DOUGLAS COUNTY, OREGON

CLIENT: SENECA JONES TIMBER COMPANY

DRAWN BY: CLW

DATE: 9/12/05

FILE: DWS\200734

D. WELLMAN SURVEYING L.L.C.
 90686 NORTHROP DRIVE
 EUGENE, OR 97402 (541) 984-1442