


**RECORD OF SURVEY**  
**FOR: SENECA JONES TIMBER COMPANY**  
**NE1/4 SECTION 33, T20S, R6W, W.M.**  
**DOUGLAS COUNTY, OREGON**  
**29, MARCH 2006**

**FILED**  
 Date: 5-4-2006 By: JC  
 This survey consists of:  
 Map: M150-43  
 Narrative: \_\_\_\_\_  
 Corner Rpt: \_\_\_\_\_  
**DOUGLAS COUNTY**  
**SURVEYOR**

S28 ●  
 S33 ●  
 E1/16 CORNER SECTIONS 28, 33  
 FOUND 1/2" IRON PIPE IN OLD ROAD  
 WITH THE FOLLOWING ACCESSORIES:  
 WITNESS CORNER (T-IRON) BEARS N58°55'W 20.7'  
 ORIGINAL BT NOT FOUND  
  
 NEW BT THIS SURVEY:  
 40" D. FIR BEARS S50°W 52.5'  
 BLAZED, SCRIBED "E1/16 S33 BT"

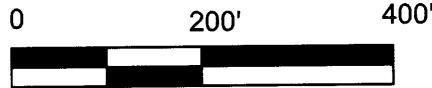


(N0°31'W 1349.3')  
 (N0°18'11"W 1344.90')

NE1/16 CORNER SECTION 33  
 FOUND 1/2" STEEL ROD WITH  
 THE FOLLOWING ACCESSORIES:  
 38" D. FIR BEARS N21°W, 28.9' (HEALED FACE)  
 OTHER ORIGINAL BT DOWN  
  
 NEW BT THIS SURVEY:  
 38" D. FIR BEARS S74-1/4°E 54.8'  
 BLAZED, SCRIBED "NE1/16 S33 BT"

N1/16 CORNER SECTIONS 33, 34  
 FOUND 1/2" REBAR WITH THE FOLLOWING  
 ACCESSORIES:  
 21" D. FIR BEARS S80°W 22.7' HEALED FACE  
 10" D. FIR BEARS S16°E 13.0' SCRIBING VISIBLE

BASIS OF BEARING  
 DOUGLAS COUNTY SURVEY FILE M32-34  
 (N89°38'E 1335.8')  
 N89°38'00"E 1339.71'

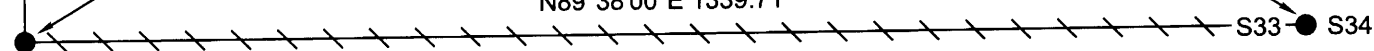

**NARRATIVE:**

THE PURPOSE OF THIS SURVEY WAS TO MARK THE LINES SHOWN AS POSTED ON THIS MAP.  
 A SUBDIVISION OF SECTION 33 WAS PERFORMED IN 1966 BY WILFORD N. HAINES AND RECORDED AS DOUGLAS COUNTY SURVEY FILE M32-34. CORNERS SHOWN IN THIS SURVEY WERE HELD IN THEIR AS TIED POSITION FOR CONTROL OF POSTED LINE.  
 LINES SHOWN AS POSTED WERE MARKED WITH RED PAINTED BLAZES, RED FLAGGING, AND 5-1/2' GALVANIZED STEEL POSTS SET AT APPROXIMATELY 200' INTERVALS. ALL CORNERS SHOWN ON THIS PLAT HAVE A GALVANIZED STEEL POST ADJACENT TO THE CORNER MONUMENT AND ALL LIVE BEARING TREES HAVE RED PAINTED FACE AND 6" WIDE BAND PLUS BEARING TREE TAG.  
 THE BASIS OF BEARING FOR THIS SURVEY IS DOUGLAS COUNTY SURVEY FILE M32-34.  
 THIS SURVEY WAS PERFORMED USING A NIKON TOTAL STATION.

**LEGEND**

- FOUND MONUMENT AS NOTED
- ////// LINE POSTED WITH RED PAINTED BLAZES, RED FLAGGING, AND 5-1/2' GALVANIZED STEEL POSTS
- ( ) RECORD DATA DOUGLAS COUNTY SURVEY FILE M32-34

REGISTERED  
 PROFESSIONAL  
 LAND SURVEYOR  
*Ronald L. Rice*  
 OREGON  
 JULY 9, 2002  
 RONALD L. RICE  
 54633LS

EXPIRES: 12-31-2006

**Ward NorthWest, Inc.**  
 P.O. BOX 105 FLORENCE, OR 97439  
 (541) 997-9201 FAX: 541-997-3546

FILE NAME		
06-02CLEAVEGE.TRV		
SCALE	DATE	DRAWN BY
200 Ft/In	3-29-2006	JR
JOB	REVISION	SHEET
06-02	-----	1/1

This map drawn with TRAVERSE PC, Software