

FILED

Date: 9-22-2006 By: JC
This survey consists of:
Map: M151-44
Narrative:
Corner Rpt:

DOUGLAS COUNTY
SURVEYOR

BASIS OF BEARING BLM 1952
R S88°45'W 5307.72'
M S88°45'00"W 5311.59'

10 | 1
15 | 14

11 | 12
14 | 13

R S88°45'00"W 2653.86'
M S88°44'54"W 2708.85'
FOUND 1952 BLM BRASS CAP
DCSO RECS. VOL 30 PAGE 12579
11" D. FIR S62°W 11.5 FT. HEALED FACE
OTHER ACCESSORIES OF RECORD ARE STILL
PRESENT BUT ARE IN BAD CONDITION
NEW BEARING TREES
13" D. FIR N1°W 10.3 FT. TO SPIKE SIDE CENTER
SCRIBE T2IR8SI0BT
11" D. FIR N71°E 6.4 FT. TO SPIKE SIDE CENTER
SCRIBE T2IR8SI1BT
18" D. FIR S41°E 19.9 FT. TO SPIKE SIDE CENTER
SCRIBE T2IR8SI4BT

FOUND 1954 BLM BRASS CAP
DCSO RECS. VOL 30 PAGE 12579-80
31" HEMLOCK N74°E 24.1 FT. WITH HEALED FACE
34" HEMLOCK STUMP S34°E 40.1 FT. WITH HEALED FACE
NEW BEARING TREES
11" ALDER S60°W 9.7 FT. TO SPIKE SIDE CENTER
BARK SCRIBE T2IR8 1/4 SI4BT
11" CEDAR N67°W 25.0 FT. TO SPIKE SIDE CENTER
SCRIBE T2IR8 1/4 SI 1 BT

R S88°45'00"W 2653.86'
M S88°45'07"W 2602.74
FOUND 1954 BLM BRASS CAP
DCSO RECS. VOL 30 PAGE 12563-4
25" MAPLE N48°E 20.4 FT. OPEN FACE NO MARKS
16" MAPLE S3°W 35.0 FT. WITH HEALED FACE
68" FIR STUMP N76°W 22.2 FT. WITH HEALED FACE
33" FIR S13°W 56.7 FT. WITH HEALED FACE
30" HEMLOCK SNAG S38°E 75.0 FT. WITH HEALED FACE
49" CEDAR N28°W 62.0 FT. WITH HEALED FACE

R N3°34'W 2438.04'
M N3°52'32"W 2436.52'


FOUND 1954 BLM BRASS CAP
WITH TWO REFERENCE MONUMENTS
DCSO RECS. VOL 30 PAGE 12578
NEW BEARING TREES
21" D. FIR S73°W 3.4 FT. TO SPIKE SIDE CENTER
SCRIBE T2IR8 1/4 SI5BT
15" D. FIR N27°W 5.9 FT. TO SPIKE SIDE CENTER
SCRIBE T2IR8 1/4 SI5BT

SURVEY NARRATIVE

THIS SURVEY WAS CONDUCTED FOR THE OWNER, ROSEBURG RESOURCES CO., FOR FOREST MANAGEMENT. BEARINGS ARE BASED ON THE 1952 THRU 1954 SURVEY BY BLM. PROPERTY LINES BETWEEN FOUND MONUMENTS WERE BLAZED AND PAINTED WITH RED TREE MARKING PAINT WITH RED FLAGGING ALONG THE TRUE LINE AND 6 FOOT POSTS NO MORE THAN 200 FEET APART.

N 1/2 SEC. 14 T 21 S R 8 W W.M.
DOUGLAS COUNTY, OREGON


REGISTERED
PROFESSIONAL
LAND SURVEYOR
Gary T. Smither
OREGON
JANUARY 26 1991
GARY T. SMITHER
2485
Renew 6/08

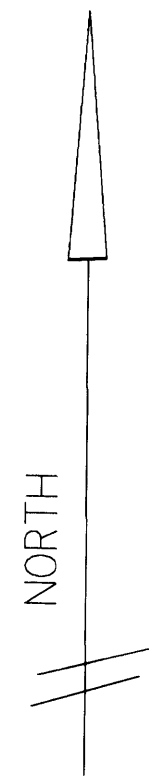

LEGEND

© MONUMENT FOUND AS NOTED
M - MEASURED
R - RECORD

SCALE 1" = 400 FEET
DATE OF SURVEY AUGUST 30, 2006

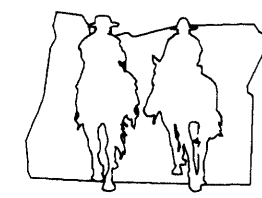

GARY T. SMITHER
OREGON SURVEYOR

P.O. BOX 545, NORTH BEND, OREGON 97459
FAX & PHONE: (541) 888-2214

SURVEY FOR THE OWNER:
ROSEGURG RESOURCES CO.
P.O. BOX 1088
ROSEBURG, OR 97470

MAP FILE M151-44

MAP FILE M151-44