


MAP FILE NO. M152-64

FILED
 Date: 4-10-2007 By: JC
 This survey consists of:
 Map: M152-64
 Narrative:
 Corner:
 DOUGLAS COUNTY
 SURVEYOR

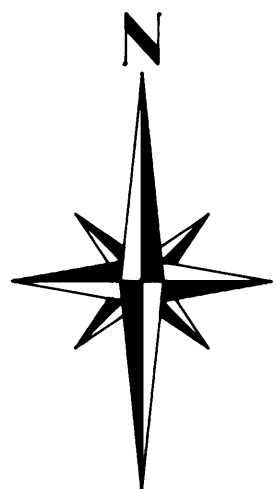

CLOSING CORNER TO S13 & 24 (M44-33)
 FD. 1 1/2" IRON PIPE WITH 3" BRASS CAP
 MARKED: "T22S S13 S24 R12W T22S S18 R11W 1970"
 FD. BT'S:
 14" ALDER, S58°W 19.7' NO MARKES, TAG
 9" ALDER, N45°W 19.9', NO MARKES, PLACED TAG
 WOOD 4X4 POST BEARS NW 1.7'
 METAL FENCE POST BEARS SE 0.7'
 ANGLE POINT PER M44-33 BEARS S0°21'50"W 33.31'

TAX LOT 1000

FD 5/8" REBAR WITH PLASTIC CAP
 MARKED "LS2869" PER SURVEY M152-12

(S89°56'04"E 1312.74' PER M152-12)

S89°56'04"E
 565.18'

S89°56'04"E
 747.56'

S13
 S24 S18

FUTURE LICENSING AREA
 1.45 Acres. +/-
 (Part of Tax Lot 1700)

N71°21'09"W
 393.78'

S12°38'48"W
 246.42'

TAX LOT 1700

TAX LOT 1700

S1°37'06"W
 111.62'

N88°32'22"W
 141.32'

LEGEND

- PROJECTED LINES (dotted line)
- SURVEYED LINES _____ (solid line)
- FUTURE LICENSING LINES _____ (dashed line)
- FOUND CORNERS (circle with dot)
- CORNERS SET (circle with cross)
- (5/8"x30" REBAR WITH PLASTIC CAP MARKED: "LS2869") (circle with cross)
- RECORD MEASUREMENTS (BEARING, DISTANCE)

NARRATIVE

THE PURPOSE OF THIS SURVEY IS TO CREATE A DESCRIPTION AND MONUMENT A FUTURE LICENSING AGREEMENT BETWEEN TAX LOT 1000 IN SECTION 13 AND TAX LOT 1700 IN SECTION 24, ALL LOCATED IN TOWNSHIP 22 SOUTH, RANGE 12 WEST, WILLAMETTE MERIDIAN, DOUGLAS COUNTY, OREGON. THIS SURVEY IS CONDUCTED FOR MENASHA FOREST PRODUCTS CORPORATION, OWNER OF TAX LOT 1700, AND HARRY & LINDA WILKES, OWNER OF TAX LOT 1000. THE LICENSING AREA IS LOCATED IN THE NE1/4 OF SECTION 24 AND DEALS WITH USING THE BOTTOM LAND FOR PASTURE. THE CONTROLLING SURVEYS WERE THE 1857 GLO SURVEY BY HARVEY GORDON, A 1874 & 1879 GLO SURVEY BY W. H. BYARS, A 1894 GLO SURVEY BY WILLIAM WHIPPLE, A 1910 GLO SURVEY BY CHARLES SLANG, A 1971 SURVEY BY ARNOLD GIBSON M44-33, A 1976 SURVEY BY ROBERT WARD M65-4, AND A 2006 SURVEY BY BRENT BACON M152-12. THE EQUIPMENT USED WAS TRIMBLE 4000 SERIES GPS RECEIVERS FOR TEMPORARY CONTROL AND A NIKON DTM530 TOTAL STATION WITH HP48GX DATA COLLECTOR. THE BASIS OF BEARING IS GEODETIC AS DETERMINED FROM THE GPS CONTROL SURVEY. DISTANCES MEASURED TO BEARING TREES ARE TO SIDE CENTER UNLESS NOTED. BEARINGS WERE MEASURED TO THE CENTER OF THE TREE USING A HAND COMPASS. THE ASSISTING PERSONNEL WAS DOYCE ROSE.

**REGISTERED
 PROFESSIONAL
 LAND SURVEYOR**

Brent W. Bacon
 OREGON
 JULY 14, 1998
BRENT W. BACON
 2869

SURVEYED BY: BRENT W. BACON
 MENASHA FOREST PRODUCTS
 P.O. BOX 588
 NORTH BEND, OR. 97459
 LICENSE RENEWAL: 12-31-2007

MENASHA FOREST PRODUCTS RECORD OF SURVEY	
LOCATED IN NE1/4 of S24, T22S R12W WM.	
PROJECT NO:	SCALE: 1" = 50'
DRAWN BY: B. BACON	DATE: 3/19/07
CHECKED BY: J. MINOR	SHT: OF:
APPROVED BY:	1 1

MAP FILE NO. M152-64