


FILED
Date: 6/15/07 By: JC
This survey consists of:
Map: M153-27
Narrative:
Corner Rpt:

DOUGLAS COUNTY
SURVEYOR

FOUND:
(8" FIR) NOW 16.5" FIR STUMP, N64°W, 32.1'
(12" FIR) NOW 25" FIR, S88°E, 171.2'
VISIBLE BLAZES ON BOTH

N00°29'00"E 1300.33'
BASIS OF BEARING PER M38-69 (1304.5')

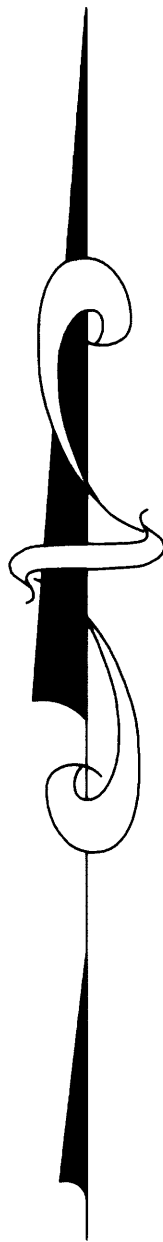

FOUND:
[26" CEDAR] NOW 26" CEDAR, N33°W 28.7'
[13" FIR] NOW 13" FIR, S73°E, 20.2'
VISIBLE BLAZES ON BOTH

Narrative

The purpose of this survey is to survey and Post a portion of that property described in Douglas County Deed Records 2006-11256. Found Monuments were held. The Southeast 1/16 corner was set using found bearing trees per M38-69.

GRAPHIC SCALE



(IN FEET)
1 inch = 100 ft.

LEGEND:

- Found "T" Iron
- Set 5/8" x 30" Iron Rod w/Yellow Plastic Cap Marked "LAND MARK 2287"

RECORD INFORMATION:

- () M 38-69
- [] M 111-26

Sheet 1 of 1

RECORD OF SURVEY

In the SE 1/4 SE 1/4, Section 28
Township 22 South, Range 7 West, W.M.
Douglas County, Oregon
June 13, 2007

REGISTERED
PROFESSIONAL
LAND SURVEYOR

Mark A. Heimbürger

OREGON
JULY 16, 1987
MARK A. HEIMBURGER
2287
RENEWS JUNE 30, 2009

FOR: TAJIS Enterprises LLC.
PO Box 47
Drain, Oregon 97435

LM LAND MARK
SURVEYING, INC.

3329 N.E. STEPHENS ST.
ROSEBURG, OREGON 97470
TEL (541) 677-9400
FAX (541) 677-9401

LM Proj. No. 2007-0057