


FILED
 Date: 8-16-2007 By: JC
 This survey consists of:
 Map: M153-78
 Narrative:
 Corner Rpt: _____
DOUGLAS COUNTY SURVEYOR

MAP FILE M153-78

NW 1/4 AND NE 1/4 SEC. 32 T29S R08W W.M.
 DOUGLAS COUNTY, OREGON

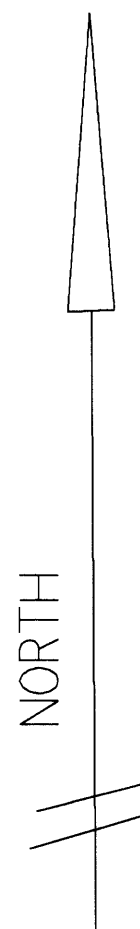

LEGEND

- ⊙ MONUMENT FOUND AS NOTED
- MONUMENTS SET
 5/8" X 30" IRON ROD WITH 2" ALUMINUM CAP
 MARKED PER 1973 MANUAL OF SURVEYING INSTRUCTIONS
- BOLD LINE REPRESENTS LINES BLAZED AND PAINTED WITH RED TREE MARKING PAINT WITH 6 FOOT GALVANIZED STEEL POSTS SET EVERY 200 FEET AND RED FLAGGING ALONG THE TRUE LINE
- M - MEASURED
 R - RECORD
- TREES CUT DOWN
- EXISTING FENCE LINE

SCALE 1" = 200 FEET
 DATE OF SURVEY JULY 17, 2007

SURVEY NARRATIVE

THIS SURVEY WAS CONDUCTED FOR ROSEBURG RESOURCES COMPANY FOR THE PURPOSE OF FOREST MANAGEMENT. BEARINGS ARE BASED ON THE 2001 BUREAU OF LAND MANAGEMENT SURVEY CONDUCTED IN 2001. THE BEARINGS ARE TRUE BEARINGS. THE MONUMENTS THAT CONTROLLED THE MONUMENT SET IN THIS SURVEY ARE SHOWN AS FOUND AND WERE ESTABLISHED BY METHODS PRESCRIBED IN THE 1973 MANUAL OF SURVEYING INSTRUCTIONS.


WE SET THE CW 1/16 CORNER AND RAN NORTH TO THE W 1/16 TO BLAZE, PAINT, FLAG AND POST THIS LINE AND PROVIDE A BASIS OF BEARING FROM THE 2001 BLM PLAT FOR THAT PORTION OF THE WORK. WE WERE ALSO ASKED TO BLAZE, PAINT, FLAG AND POST THE RECTANGULAR PORTION OF THE PROPERTY DESCRIBED IN THE DOUGLAS COUNTY DEED RECORDS IN BOOK 543 PAGE 770. WE DID NOT TIE THE TWO PORTIONS OF THIS SURVEY TOGETHER BUT DO SHOW THE RECORD 2001 BLM BEARING CONNECTING THE TWO PORTIONS OF THE SURVEY. WE DID SURVEY THE RECTANGULAR PORTION AND SHOW THE 2001 BLM BEARING COMPARED TO THE DEED BEARING AND COUNTY SURVEY FILE NO. 55/334-2.

REGISTERED
 PROFESSIONAL
 LAND SURVEYOR

Gary T. Smither

OREGON
 JANUARY 29, 1991
 GARY T. SMITHER
 2485

Renew 6/08

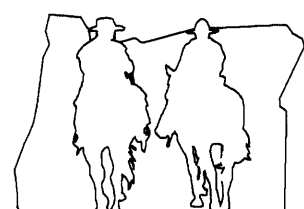

GARY T. SMITHER
 OREGON SURVEYOR

P.O. BOX 545, NORTH BEND, OREGON 97459
 FAX & PHONE: (541) 888-2214

SURVEY FOR THE OWNER:

ROSEBURG RESOURCES CO.
 P.O. BOX 1088
 ROSEBURG, OR 97470

SECTION 29
 SECTION 32

W 1/16

FOUND 2001 BLM BRASS CAP
 SET 6 FOOT POST ALONGSIDE
 22" D. FIR N 72 1/2°E, 23.8 FEET WITH
 HEALED FACE AND TAG
 8" W. FIR S26 1/2°E 16.1 FEET
 WITH HEALED FACE AND TAG

R N88°27'29"E 791.98'
 BLM 2001 SURVEY
 THIS LINE WAS NOT RUN THIS SURVEY

FOUND 2001 BLM BRASS CAP
 SET 6 FOOT POST ALONGSIDE
 1 1/2" MADRONE N73°E, 5.2 FEET WITH
 HEALED FACE AND TAG
 NEW BEARING TREE
 23" W. FIR S54°W 10.9 FEET
 TO SPIKE SET SIDE CENTER
 SCRIBED "PROP COR BT"

EXISTING FENCE LINE

M N01°55'39"W 1336.93'
 R SOUTH 1337.57'
 C.S. FILE NO. 55/334-2
 AND DEED
 BOOK 543 PAGE 770

BASIS OF BEARING FOR
 PARCEL DESCRIBED IN
 DEED RECORD
 BOOK 543 PAGE 770
 DEED WEST 52218
 BLM RECORD S88°27'29"W 521.82'
 M S88°27'29"W 521.86'

FOUND 2001 BLM 3 1/2"
 ALUMINUM CAP

SET 6 FOOT POST
 ALONGSIDE
 32" ROTTED FIR STUMP N6 1/4°E,
 55.9 FEET
 NO MARKS VISIBLE
 ROTTED MADRONE STUMP S38°E,
 118.8 FEET
 NO MARKS VISIBLE
 23" CEDAR N 11 1/4°E,
 52.9 FEET
 WITH HEALED FACE AND TAG
 14" D. FIR S66 1/2°E,
 56.9 FEET
 WITH HEALED FACE AND TAG

M S88°24'15"W 659.56'
 R EAST 660.00'
 C.S. FILE NO. 55/334-2
 AND DEED
 BOOK 543 PAGE 770

M S40°51'40"E 217.45'
 R N39°19'23"W 217.49'
 C.S. FILE NO. 55/334-2
 AND DEED
 BOOK 543 PAGE 770

FOUND 1 1/2" IRON PIPE BENT
 DEED BOOK 543 PAGE 770
 SET 6 FOOT POST ALONGSIDE
 NEW BEARING TREES

8" W. FIR S25°E, 14.6 FEET
 TO SPIKE SET SIDE CENTER
 SCRIBED "PROP COR BT"
 WITH ALUMINUM TAG

19" D. FIR N25°E, 31.4 FEET
 TO SPIKE SET SIDE CENTER
 SCRIBED "PROP COR BT"
 WITH ALUMINUM TAG

M S01°55'52"E 1168.08'
 R NORTH 1169.33'
 C.S. FILE NO. 55/334-2
 AND DEED
 BOOK 543 PAGE 770

FOUND 1 1/2" IRON PIPE
 SET 6 FOOT POST ALONGSIDE
 DEED BOOK 543 PAGE 770
 OLD BEARING TREES

14" D. FIR N87°E, 11.6 FEET
 WITH HEALED FACE AND TAG

NEW BEARING TREES

9" D. FIR S38°E, 6.6 FEET
 TO SPIKE SET SIDE CENTER
 SCRIBED "PROP COR BT"
 WITH ALUMINUM TAG

M N0°09'36"E 2634.63'

CW 1/16
 FALLS IN CREEK

WITNESS CORNER AT
 N0°09'36"E 15.00 FEET
 OF TRUE CENTER WEST 1/16 CORNER

SET 6 FOOT POST ALONGSIDE

1/4

FOUND 1958 BRASS CAP
 DCSO RECS VOL. 33 PAGE 13884

17" FIR N 19°E, 12.5 FEET WITH
 HEALED FACE AND TAG

29" CEDAR N55 1/2°W 40.9 FEET
 WITH HEALED FACE AND TAG

1 1/2" ALDER N30°W, 4.7 FEET
 TO SPIKE SET SIDE CENTER
 BARK SCRIBED "WC CW 1/16 S32 BT"

38" CEDAR S14°W, 24.1 FEET
 TO SPIKE SET SIDE CENTER
 SCRIBED "WC CW 1/16 S32 BT"
 WITH ALUMINUM TAG

M N0°09'36"E 15.00'

SECTION 31
 SECTION 32
 1/4

M N89°37'45"E 1308.30'

BASIS OF BEARING BLM 2001 SURVEY
 R S89°37'45"W 2616.26'
 M S89°37'45"W 2616.60'

M N89°37'45"E 1308.30'

C 1/4

FOUND 2001 ALUMINUM CAP
 DCSO RECS VOL. 54 PAGE 20962-3

19" D. FIR N 62 1/2°E, 3.4 FEET WITH
 VISIBLE SCRIBE AND TAG

17" D. FIR S 7°W 4.1 FEET
 WITH HEALED FACE AND TAG

2 1/2" BRASS CAP REFERENCE MONUMENT
 N42°W 9.9 FEET

MAP FILE M153-78