

PROPERTY LINE ADJUSTMENT

MAP OF SURVEY

LOCATED in the SE 1/4 of Section 21, T. 28 S., R. 6 W., W.M. in
the City of Winston, Douglas County, Oregon.

August 7, 2007

FILED

Date: 10-22-2007 By: JC
This survey consists of:
Map: M154-36
Narrative: _____
Corner Rpt: _____

DOUGLAS COUNTY
SURVEYOR



SURVEYED FOR: *DAVE AND KATHY HILL*
P.O. BOX 850
WINSTON, OREGON 97496

SURVEYED BY: *DAVID EDWARDS LAND SURVEYING*
P.O. BOX 361
OAKLAND, OREGON 97462
PHONE: (541) 459-0512

APPROVAL

PLANNING FILE: 07-W007

[Signature] 10/19/07
CITY OF WINSTON CITY ADMINISTRATOR DATE

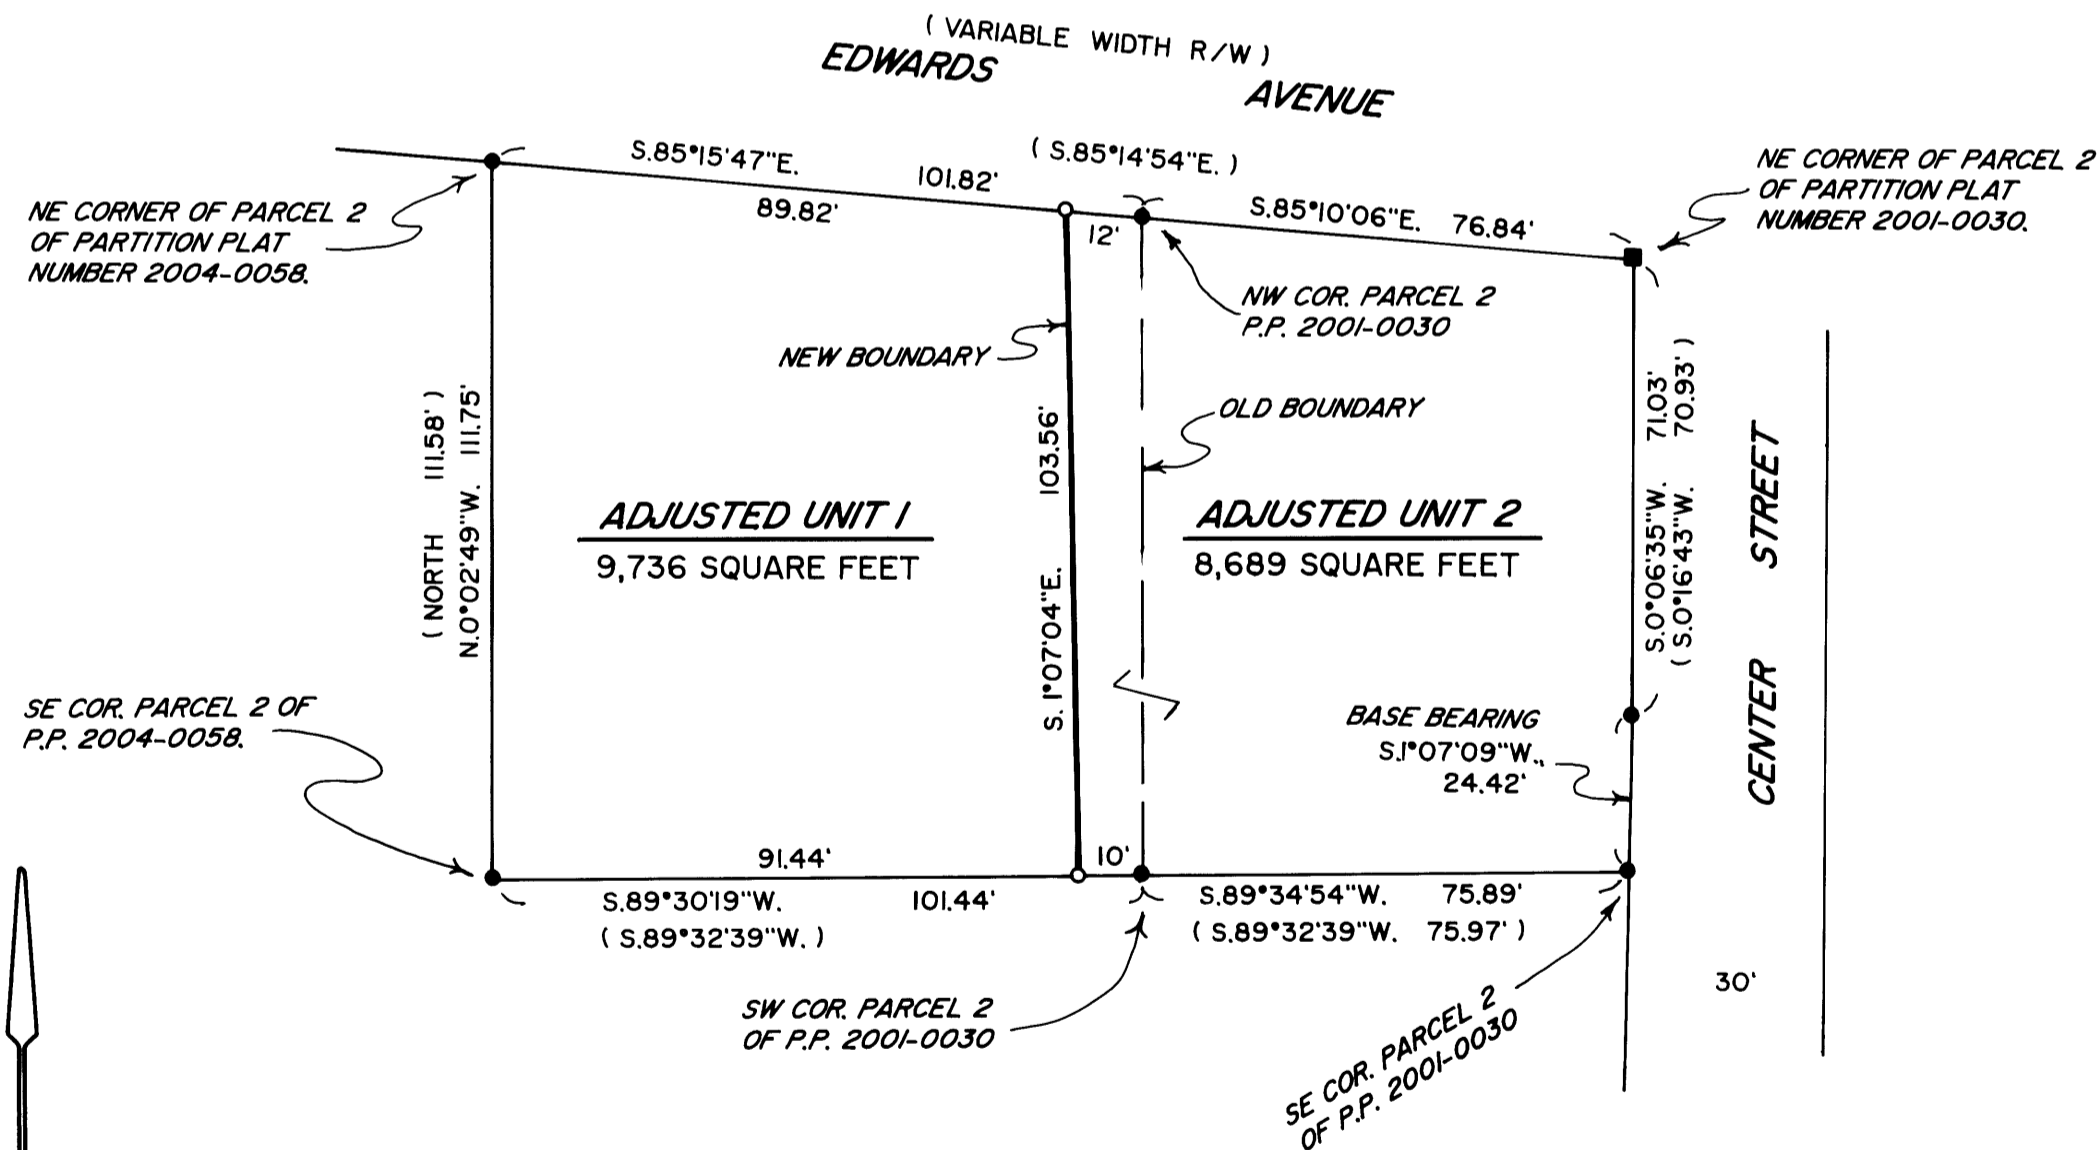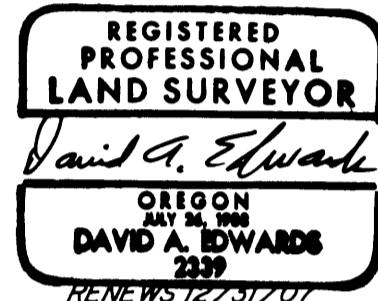

LEGEND

- INDICATES 5/8" DIAMETER IRON ROD FOUND.
 - INDICATES 1 1/2" DIAM. IRON PIPE FOUND AT THE NE CORNER OF PARCEL 2 OF PARTITION PLAT NUMBER 2001-0030.
 - INDICATES 5/8" X 30" STEEL REBAR W/RED PLASTIC CAP MKD. "D.A. EDWARDS-LS 2339" SET.
 - () DENOTES RECORD DATA PER EITHER P.P. 2001-0030 OR P.P. 2004-0058.
- P.P. = PARTITION PLAT.
SCALE: 1" = 30'
BASIS OF BEARINGS: PARTITION PLAT NUMBER 2001-0030 AS SHOWN.

DEED RECORDING NO. 2007-022379

NARRATIVE

THE PURPOSE OF THIS SURVEY IS TO MONUMENT THE NEW BOUNDARY SHOWN HEREON AND TO PREPARE LEGAL DESCRIPTIONS FOR THE ADJUSTED UNITS. FOUND MONUMENTS PER PARTITION PLAT NUMBER 2001-0030 AND PARTITION PLAT NUMBER 2004-0058 WERE HELD FOR THE EXTERIOR BOUNDARIES AS SHOWN.

FIELD CREW: BRANT MILLER AND ERIC SPRINKLE.

EQUIPMENT: NIKON TOTAL STATION.

COMPUTATIONS AND DRAFTING: DAVID EDWARDS.



MAP FILE M154-36

MAP FILE M154-36