


RECORD OF SURVEY
 FOR: SENECA JONES TIMBER COMPANY
 NW1/4, SECTION 8, T22S, R6W, W.M.
 DOUGLAS COUNTY, OREGON
 28 DECEMBER 2007

FILED
 Date: 1/4/2008 By: JP
 This survey consists of:
 Map: M154-72
 Narrative:
 Corner Rpt:



DOUGLAS COUNTY
 SURVEYOR

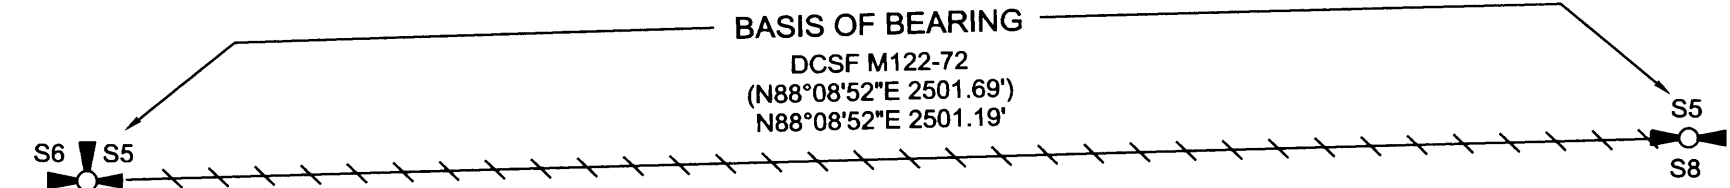

SECTION CORNER
 SECTIONS 5, 6, 7, 8
 FOUND DOUGLAS COUNTY
 BRASS CAP DATED 1961 WITH
 THE FOLLOWING ACCESSORIES:
 36" D. FIR BEARS S23°E 11.5' - HEALED FACE
 22" D. FIR BEARS S59°W 32.8' - HEALED FACE
 17" D. FIR BEARS N35°E 29.8' - HEALED FACE
 RECORD N35°W 29.8' - CORNER CARD #200600
 14" D. FIR BEARS N61°W 18.5' - HEALED FACE
 18" D. FIR SNAG BEARS N63°E 23.5' - SCRIBING VISIBLE
 26" D. FIR SNAG BEARS N41°E 21.1' - SCRIBING VISIBLE

1/4 CORNER
 SECTIONS 5, 8
 FOUND DOUGLAS COUNTY
 BRASS CAP DATED 1961 WITH
 THE FOLLOWING ACCESSORIES:
 11" D. FIR BEARS S40°E 22.1' - HEALED FACE
 14" X 12' BURNED D. FIR SNAG
 BEARS N5°W 31.7' - BURNED FACE
 48" ROTTEN INCENSE CEDAR STUMP
 BEARS S17°W 18.5' TO FACE - ROTTED FACE
 NEW BT THIS SURVEY:
 7" D. FIR BEARS N52°W 35.2' - BLAZED, SCRIBED "1/4 S5 BT"

NORTH 1317.675'
 N0°01'47"E 1318.37'

N1/16 CORNER
 SECTIONS 7, 8
 FOUND 5/8" REBAR WITH RED
 PLASTIC CAP MARKED
 "D.A. EDWARDS - LS 2339" WITH
 THE FOLLOWING ACCESSORIES:
 13" D. FIR BEARS N13-1/2°W 18.5' - HEALED FACE
 14" D. FIR SNAG BEARS S61°E 4.6' - HEALED FACE
 NEW BT THIS SURVEY:
 18" D. FIR BEARS N46°E 20.2' - BLAZED, SCRIBED "N1/16 S8 BT"

- LEGEND
- FOUND SECTION CORNER AS NOTED
 - FOUND 1/4 CORNER AS NOTED
 - FOUND 1/16 CORNER AS NOTED
 - POSTED LINE AS DEFINED IN NARRATIVE
 - DCSF DOUGLAS COUNTY SURVEY FILE
 - () RECORD DATA DCSF M122-72

NARRATIVE:
 THE PURPOSE OF THIS SURVEY WAS TO MARK THE LINES SHOWN AS POSTED HEREON. CONTROLLING CORNERS WERE TIED IN A CLOSED LOOP TRAVERSE. CORNERS WERE THEN HELD IN THEIR AS-TIED POSITIONS FOR THE POSTING OF TRUE LINE, WHICH WAS MARKED WITH RED PAINTED BLAZES, RED FLAGGING, AND 5-1/2' GALVANIZED STEEL POSTS SET AT 200' +/- INTERVALS. THE BASIS OF BEARING FOR THIS SURVEY WAS THE DCSF M122-72 RECORD FOR THE WEST HALF OF THE NORTH LINE OF SECTION 8. THIS SURVEY WAS PERFORMED USING A NIKON TOTAL STATION.

REGISTERED
 PROFESSIONAL
 LAND SURVEYOR
Ronald L. Rice
 OREGON
 JULY 9, 2002
 RONALD L. RICE
 54633LS

Ward NorthWest, Inc.
 P.O. BOX 105 FLORENCE, OR 97439
 (541) 997-9201 FAX: 541-997-3546

FILE NAME 07-97.TRV		
SCALE 300 Ft/In	DATE 12-28-2007	DRAWN BY JR
JOB 07-97	REVISION -----	SHEET 1/1

EXPIRATION DATE: 12-31-2008

This map drawn with TRAVERSE PC, Software

MAP FILE M154-72

MAP FILE M154-72