


FILED

RECORD OF SURVEY
 FOR: SENECA JONES TIMBER COMPANY
 SE1/4, NE1/4, SECTION 20, T31S, R4W, W.M.
 DOUGLAS COUNTY, OREGON
 27 JUNE 2008

Date: 7-2-2008 By: JC
 This survey consists of:
 Map: M156-22
 Narrative:
 Corner Rpt:

DOUGLAS COUNTY
 SURVEYOR

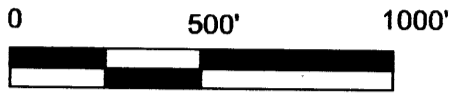


SECTION CORNER
 SECTIONS 16, 17, 20, 21
 FOUND 2-1/2" DCBC DATED 1966
 WITH THE FOLLOWING ACCESSORIES:
 39" D. FIR BEARS S71-1/2°E 15.5' - HEALED FACE
 24" HEMLOCK BEARS S62-1/2°W 11.3' - HEALED FACE
 20" D. FIR BEARS N69-1/2°W 20.2' - HEALED FACE
 NEW BT THIS SURVEY:
 8" HEMLOCK BEARS N55°E 32.8' - BLAZED,
 SCRIBED "T31S R4W S16 BT"



LEGEND

- FOUND SECTION CORNER AS NOTED
- FOUND QUARTER CORNER AS NOTED
- MARKED PROPERTY LINE AS DEFINED IN NARRATIVE
- () RECORD DATA PER 1893 GLO SURVEY
- [] RECORD DATA PER DOUGLAS COUNTY CORNER CARD #300300
- GLO GENERAL LAND OFFICE
- DCBC DOUGLAS COUNTY BRASS CAP

QUARTER CORNER
 SECTIONS 20 AND 21
 FOUND 2-1/2" DCBC DATED 1966
 WITH THE FOLLOWING ACCESSORIES:
 43" D. FIR BEARS N63°E 56.1' - HEALED FACE
 19" D. FIR BEARS N40°W 15.4' - HEALED FACE
 19" D. FIR BEARS S82°W 8.2' - HEALED FACE
 9" CHINQUAPIN BEARS N27°E 13.2' - ROTTED FACE

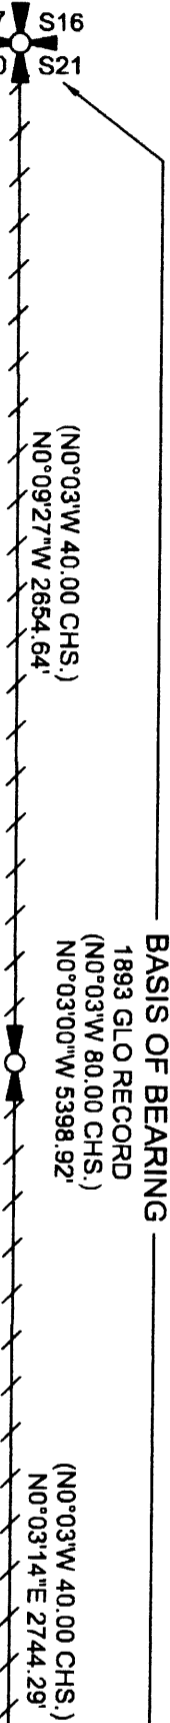

NARRATIVE

THE PURPOSE OF THIS SURVEY WAS TO MARK THE EAST BOUNDARY OF SECTION 20, TOWNSHIP 31 SOUTH, RANGE 4 WEST, WILLAMETTE MERIDIAN. CONTROLLING CORNERS WERE TIED IN A RANDOM TRAVERSE BEFORE TRUE LINE WAS MARKED WITH RED PAINTED BLAZES, RED FLAGGING, AND 5-1/2' GALVANIZED STEEL POSTS SET AT INTERVALS NOT TO EXCEED 200'. ALL CORNERS HAVE A GALVANIZED STEEL POST ADJACENT TO THEM AND ALL BEARING TREES HAVE RED PAINTED BANDS AND BT TAGS. THE BASIS OF BEARING FOR THIS SURVEY WAS THE 1893 GLO RECORD BEARING FOR THE EAST BOUNDARY OF THE SECTION. THIS SURVEY WAS PERFORMED USING A NIKON TOTAL STATION.

REGISTERED PROFESSIONAL LAND SURVEYOR
Ronald L. Rice
 OREGON JULY 9, 2002
 RONALD L. RICE
 54633LS

SECTION CORNER
 SECTIONS 20, 21, 28, 29
 FOUND 2-1/2" DCBC DATED 1966
 WITH THE FOLLOWING ACCESSORIES:
 47" D. FIR BEARS S30-1/2°W 30.0' - HEALED FACE [RECORD S30-1/2°W 27.4']
 37" D. FIR BEARS S53-1/2°E 49.0' - HEALED FACE
 32" D. FIR BEARS N58°W 30.0' - HEALED FACE
 26" CHINQUAPIN BEARS N29°W 9.9' - BURNED FACE [RECORD N58°W 9.9']



EXPIRATION DATE: 12-31-2008

FILE NAME		
08-36.TRV		
SCALE	DATE	DRAWN BY
500 Ft/In	6-27-08	JR
JOB	REVISION	SHEET
08-36	-----	1/1

This map drawn with TRAVERSE PC, Software

Ward NorthWest, Inc.
 P.O. BOX 105 FLORENCE, OR 97439
 (541) 997-9201 FAX: 541-997-3546