

FILED
 Date: 9/9/2011 By: hw
 This survey consists of:
 Map: M157-48
 Narrative: _____
 Corner Rpt: _____
 DOUGLAS COUNTY
 SURVEYOR

LEGEND

- SET 5/8" x 30" IR w/CAP MARKED "I.E. ENGINEERING"
- FOUND 5/8" IRON ROD
- ⊙ FOUND BRASS CAP - SECTION CORNER 27, 28, 33 & 34
- △ CALCULATED POSITION
- () R1 RECORD AS PER M133-37
- () R2 RECORD AS PER DEED (INST. #2004-021343)

LINE	BEARING	LENGTH
1	S00°32'59"W	249.04'
R2	NORTH	246.60'
2	S85°45'17"E	165.83'
R2	S85°52'E	165.10'
3	S70°54'17"E	313.20'
R2	S71°01'E	313.20'
4	N85°13'43"E	258.00'
R2	N85°07'E	258.00'
5	N04°07'34"E	126.40'

NARRATIVE:

THE PURPOSE OF THIS MAP IS TO ADJUST THE BOUNDARY BETWEEN THAT LAND DESCRIBED IN INSTRUMENT NUMBER 1999-12422 AND INSTRUMENT NUMBER 2004-21343, DEED RECORDS OF DOUGLAS COUNTY.

PROCEDURE WAS AS FOLLOWS:

MONUMENTS OF RECORD WERE TIED AND HELD AS SHOWN. ALL CALCULATED POINTS WERE ESTABLISHED BY HOLDING RECORD ANGLE AND DISTANCE FROM FOUND MONUMENTS. MONUMENTS WERE THEN SET TO DELINEATE THE NEW BOUNDARY AS SHOWN.


APPROVALS:

[Signature] 9/9/11 DATE
 DOUGLAS COUNTY PLANNING DIRECTOR

RECORDING:

ADJUSTED PORTION RECORDED AS INSTRUMENT NO. ~~2011-012370~~ 2011-012576 DOUGLAS COUNTY DEED RECORDS.

PLANNING DEPARTMENT FILE NO. 11-M030

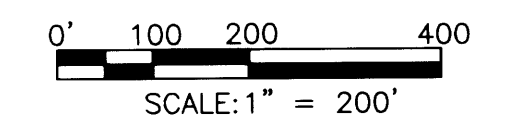

<p>REGISTERED PROFESSIONAL LAND SURVEYOR</p> <p><i>[Signature]</i></p> <p>OREGON JULY 14, 1978 RONALD A. GIMBY 1954</p> <p>EXPIRES: 12/31/2012</p>	<p>BOUNDARY LINE ADJUSTMENT</p> <p>IN THE SW 1/4 OF S. 27, SE 1/4 OF S. 28, NE 1/4 OF S. 33 & THE NW 1/4 OF S. 34, T30S, R6W, W.M., DOUGLAS COUNTY, OR.</p>	
	<p>SURVEYED FOR:</p> <p>FRED GREEN 454 GRAVEL PIT LANE RIDGLE, OR 97469</p>	<p>SURVEYED BY:</p> <p><i>[Signature]</i> 809 SE Pine Street Roseburg, Oregon 97470 PHONE (541) 673-0166 FAX (541) 440-9392 iemail@ieengineering.com</p>
<p>SCALE: AS NOTED</p>	<p>JOB NO: 2501-01</p>	<p>DWG. BY: DAF</p>
<p>DATE: JULY, 2011</p>	<p>PM: RAQ</p>	<p>PAGE: 1 OF 1</p>

