

SURVEY FOR Roseburg Resources Co.

In the NE 1/4 of Section 33, T.24 S., R.7 W. W.M.
Douglas County, Oregon

December 03, 2008

FILED
Date: 2/18/2009 By: hw
This survey consists of:
Map: M 158-62
Narrative: _____
Corner Rpt: _____
DOUGLAS COUNTY
SURVEYOR

NARRATIVE

This survey was made to remark a portion of the lines marked in a survey by the B.L.M. in 1979, under Group Number 988, at the request of Ron O'Neal, Forest Engineer, Roseburg Resources Co. The above mentioned survey was accepted by the B.L.M. Portland Office on January 26, 1983.

Monuments held or set in the B.L.M. survey, were held as shown on this map.

The lines marked in this survey, were marked with glo red ribbon and 6' metal posts placed at intervals along the line. Trees within 5 feet on both sides of the line were 1/4 blazed with an ax. The blazes were painted red.


NOTES

Bearings and distances to bearing trees were obtained or checked with a hand compass and a buckers tape. Record info. is reported for the found bearing trees, since no major variations were found. Distances are measured to the side center of the trees. All bearing trees found or established have faces and a 6" band around them, painted red.


New 3" aluminum nails have been placed into the existing B.L.M. BT tags.

All bearing trees established have Roseburg Resources BT tags attached to them.

CENTER NORTH 1/16
3 1/4" BRASS CAP ON
A 2 1/2" IRON PIPE
[B.L.M. 1983]

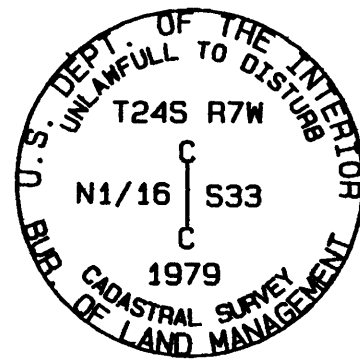

NORTH 1/16
2 1/2" BRASS CAP
ON A 1" IRON PIPE
UP 14"
[SHANER, CS M49-7]

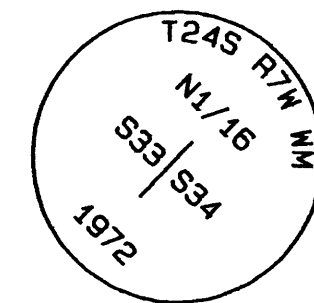

BASIS OF BEARINGS
N89°48'00"W 2633.24'
N89°48'W 39.92 CHAINS (2634.72') - B.L.M.)



SCALE 1" = 200'


REGISTERED
PROFESSIONAL
LAND SURVEYOR

Kent Ryan Inman

OREGON
JULY 13, 2004
KENT RYAN INMAN
60050LS

Expiration Date: 6/30/2009

S00°04'50"W 1327.13'
(NO°04'E 20.09 CHAINS (1325.94') - B.L.M.)

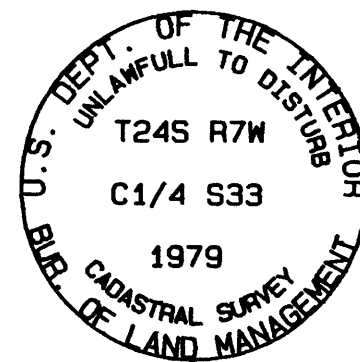

CENTER 1/4
3 1/4" BRASS CAP ON
A 2 1/2" IRON PIPE
[B.L.M. 1983]

BEARING TREES FOUND

- 24" Grand Fir with a healed face and B.L.M. BT tag bears N43°E 6.3'
- 9" Douglas fir with a healed face and B.L.M. BT tag bears S41°W 5.6'

BEARING TREE FOUND

- 30" Douglas fir with a healed face and B.L.M. BT tag bears N35°W 15.8'. The B.L.M. BT tag is unreadable. I attached a new Roseburg Resources BT tag.

BEARING TREE ESTABLISHED

- 10" Douglas fir bears S28°W 29.7' scribed N1/16 S33 BT

BEARING TREES FOUND

- 12" Yew with a partly healed face and B.L.M. BT tag bears S24 1/2°W 30.0'
- 29" Grand Fir with a healed face and B.L.M. BT tag bears N67 1/2°E 19.2'

BEARING TREES ESTABLISHED

- 8" Grand Fir bears S40°E 45.2' scribed C1/4 S33 BT
- 27" Grand Fir bears N22°W 14.9' scribed C1/4 S33 BT

LEGEND

- = Found Monument as noted
- () = Data of Record from Record Document or other source as noted
- { } = Data Computed from one or more Record Sources as noted
- [] = Surveyor, File Number for survey in which monument probably originated
- B.L.M. = Bureau of Land Management
- BT = Bearing Tree
- CS = Douglas County Surveyor's Office record reference number
- ////// = Line marked in this survey

Inman Surveying, LLC
1325 Aude1 Avenue
Eugene, OR 97404
(541) 607-9559

MAP FILE M158-62

MAP FILE M158-62