
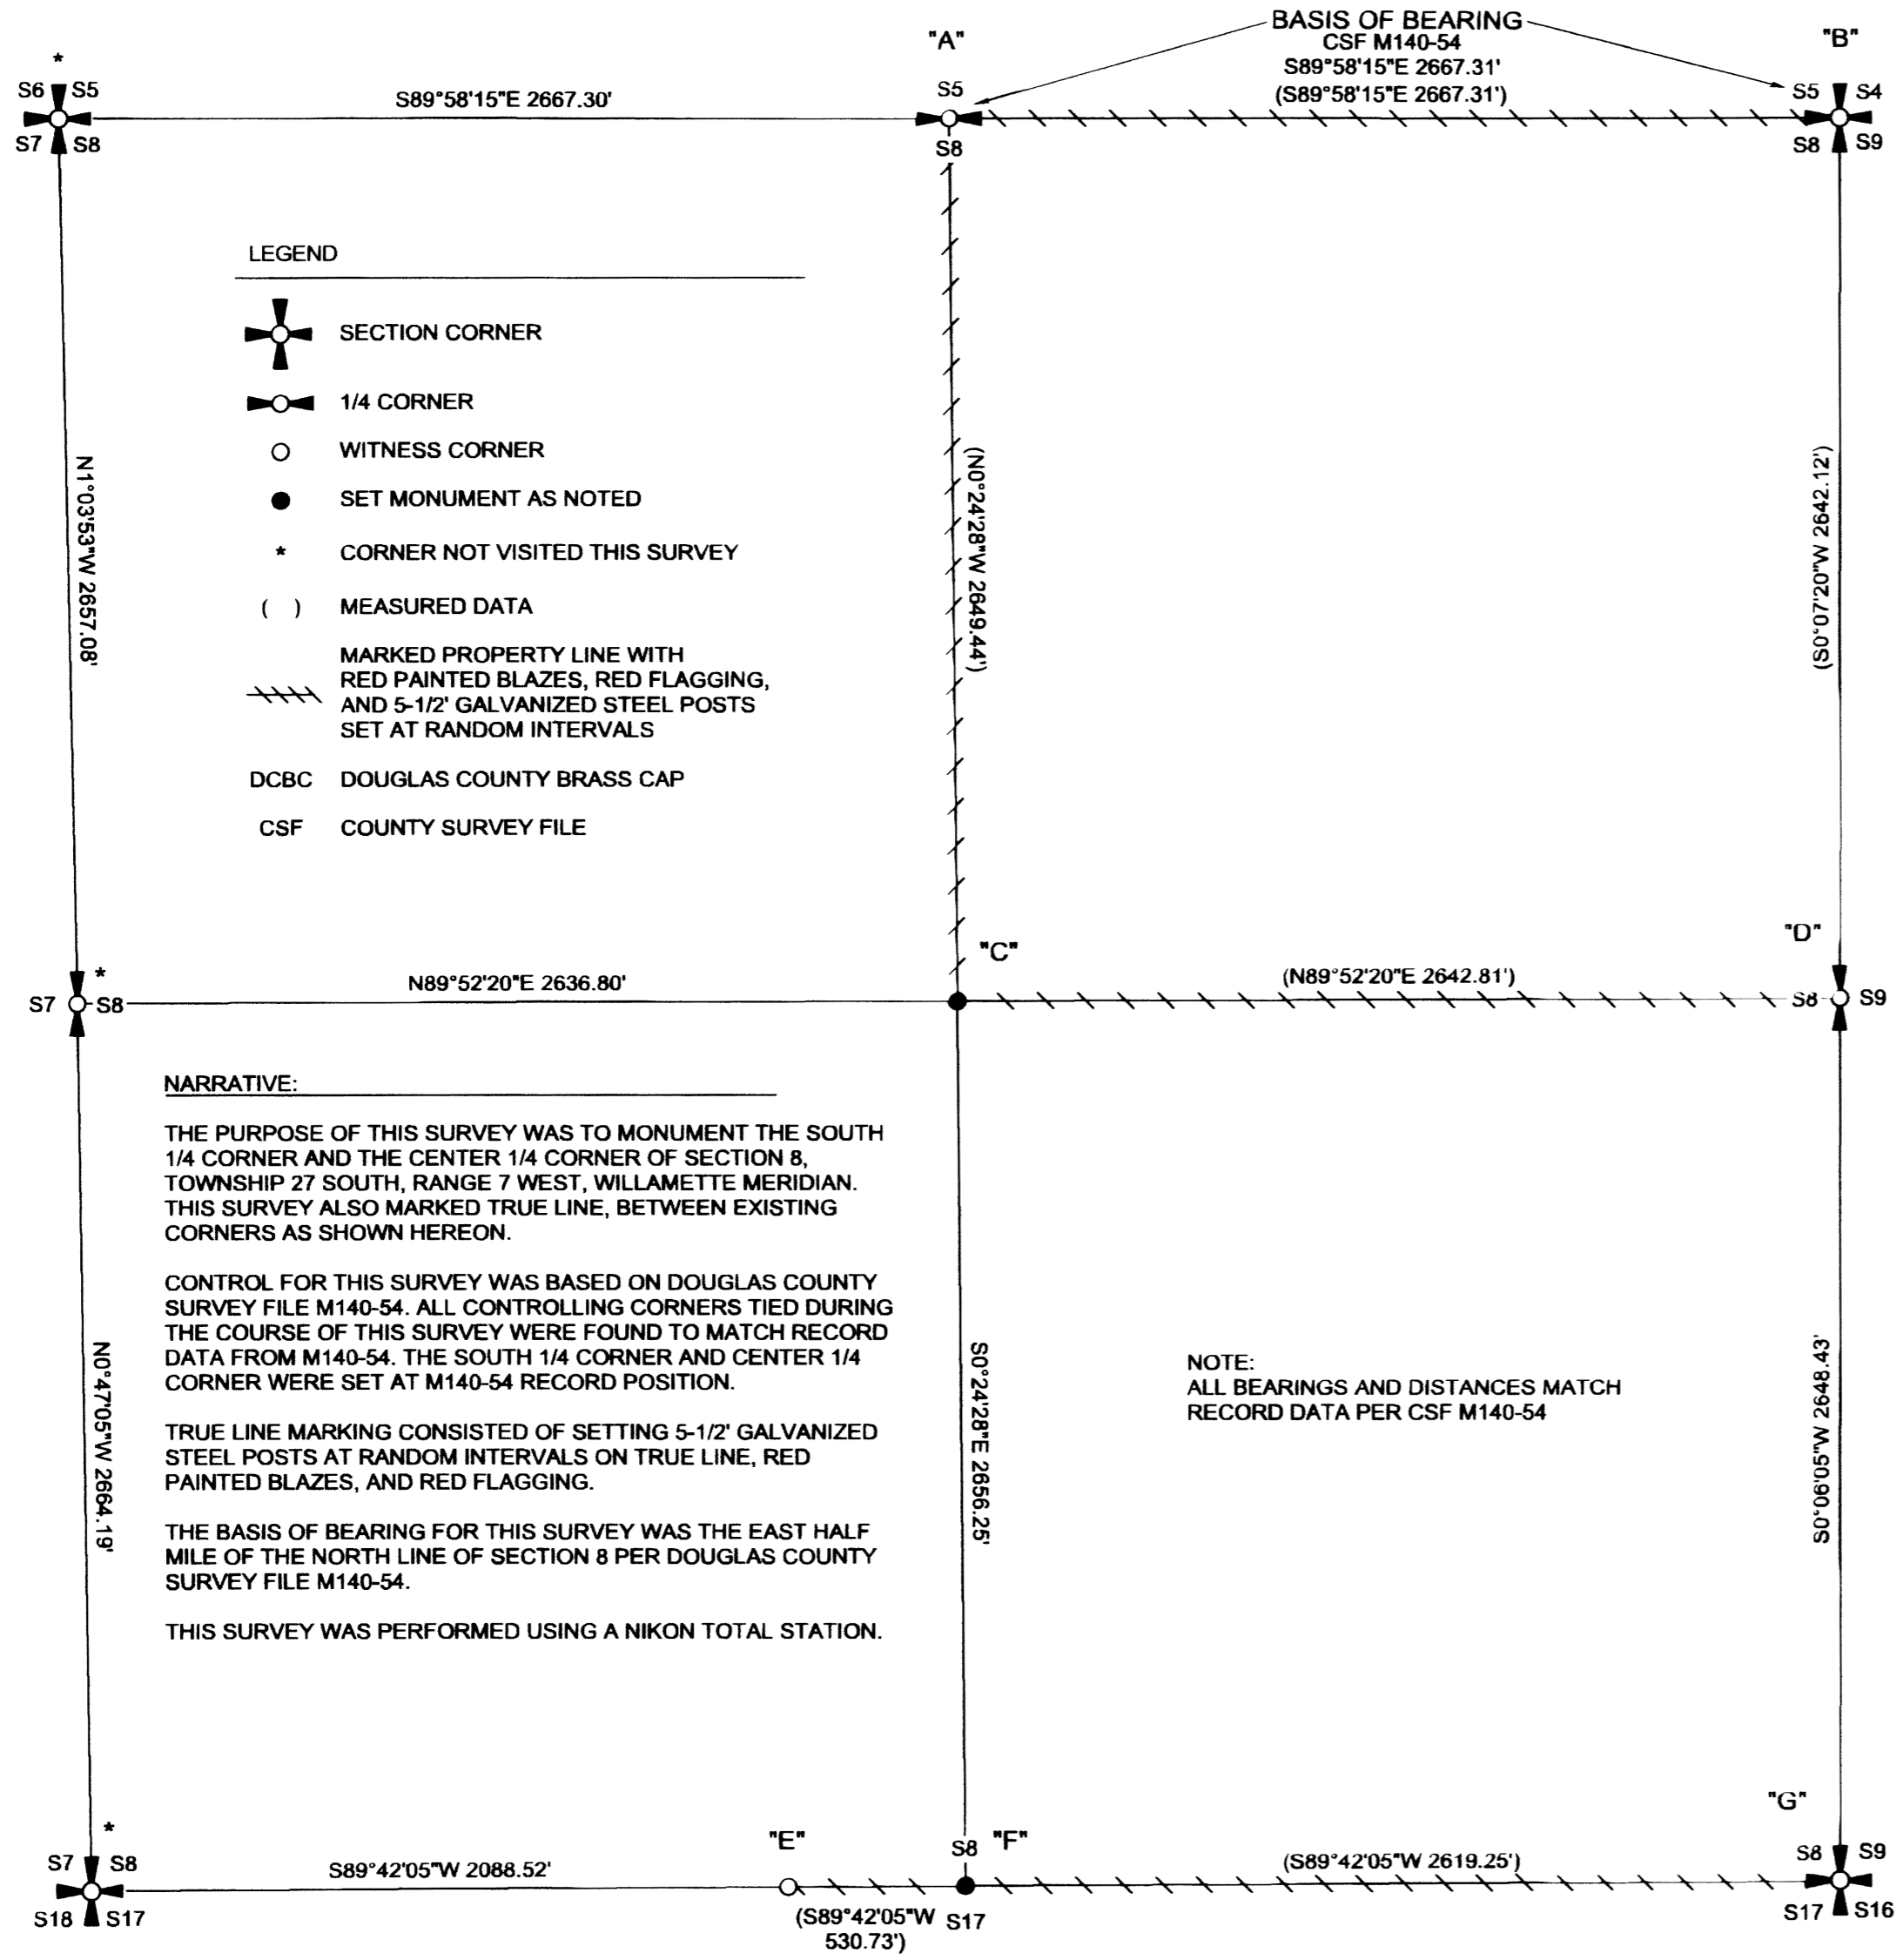


RECORD OF SURVEY  
 FOR: SENECA JONES TIMBER COMPANY  
 AND ROSEBURG RESOURCES COMPANY  
 NE1/4, SE1/4, SW1/4 SEC. 8, T.27S., R.7W., W.M.  
 DOUGLAS COUNTY, OREGON  
 16 MARCH 2009

FILED  
 Date: 3/20/2009 By: JLP  
 This survey consists of:  
 Map: M158-80  
 Narrative: \_\_\_\_\_  
 Corner Rpt: \_\_\_\_\_

DOUGLAS COUNTY  
 SURVEYOR

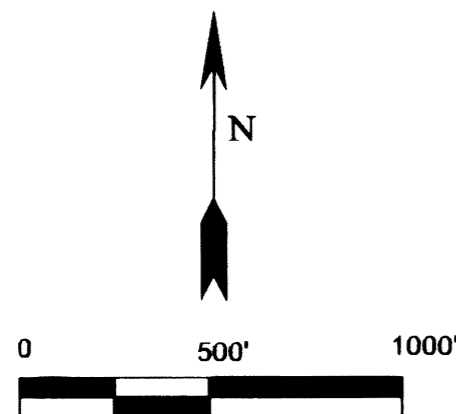

- LEGEND
- SECTION CORNER
  - 1/4 CORNER
  - WITNESS CORNER
  - SET MONUMENT AS NOTED
  - CORNER NOT VISITED THIS SURVEY
  - MEASURED DATA
  - MARKED PROPERTY LINE WITH RED PAINTED BLAZES, RED FLAGGING, AND 5-1/2\"/>
- DCBC DOUGLAS COUNTY BRASS CAP  
 CSF COUNTY SURVEY FILE

NARRATIVE:

THE PURPOSE OF THIS SURVEY WAS TO MONUMENT THE SOUTH 1/4 CORNER AND THE CENTER 1/4 CORNER OF SECTION 8, TOWNSHIP 27 SOUTH, RANGE 7 WEST, WILLAMETTE MERIDIAN. THIS SURVEY ALSO MARKED TRUE LINE, BETWEEN EXISTING CORNERS AS SHOWN HEREON.

CONTROL FOR THIS SURVEY WAS BASED ON DOUGLAS COUNTY SURVEY FILE M140-54. ALL CONTROLLING CORNERS TIED DURING THE COURSE OF THIS SURVEY WERE FOUND TO MATCH RECORD DATA FROM M140-54. THE SOUTH 1/4 CORNER AND CENTER 1/4 CORNER WERE SET AT M140-54 RECORD POSITION.

TRUE LINE MARKING CONSISTED OF SETTING 5-1/2\"/>

NOTE:  
 ALL BEARINGS AND DISTANCES MATCH  
 RECORD DATA PER CSF M140-54

- "A"  
 1/4 CORNER  
 SECTIONS 5 AND 8  
 FOUND 5/8\"/>

"B"  
 SECTION CORNER  
 SECTIONS 4, 5, 8, 9  
 FOUND 2-1/2\"/>



"C"  
 CENTER 1/4 CORNER  
 SECTION 8  
 SET 2-1/2\"/>

"D"  
 1/4 CORNER  
 SECTIONS 8 AND 9  
 FOUND 5/8\"/>

"E"  
 WITNESS CORNER TO 1/4 CORNER  
 SECTIONS 8 AND 17  
 FOUND 5/8\"/>

"F"  
 1/4 CORNER  
 SECTIONS 8 AND 17  
 SET 2-1/2\"/>

"G"  
 SECTION CORNER  
 SECTIONS 8, 9, 16, 17  
 FOUND 2-1/2\"/>

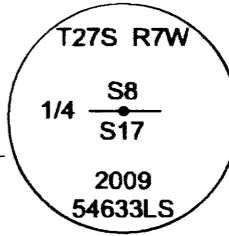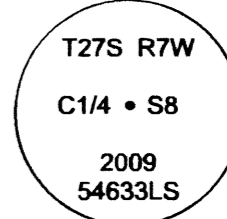

REGISTERED  
 PROFESSIONAL  
 LAND SURVEYOR  
*Ronald L. Rice*  
 OREGON  
 JULY 9, 2002  
 RONALD L. RICE  
 54633LS

Ward NorthWest, Inc.  
 P.O. BOX 105 FLORENCE, OR 97439  
 (541) 997-9201 FAX: 541-997-3546

FILE NAME 09-02.TRV		
SCALE 500 F/In	DATE 3-16-09	DRAWN BY JR
JOB 09-02	REVISION	SHEET 1/1

RENEWALS: 12-31-2010

This map drawn with TRAVERSE PC, Software

MAP FILE M158-80

MAP FILE M158-80