
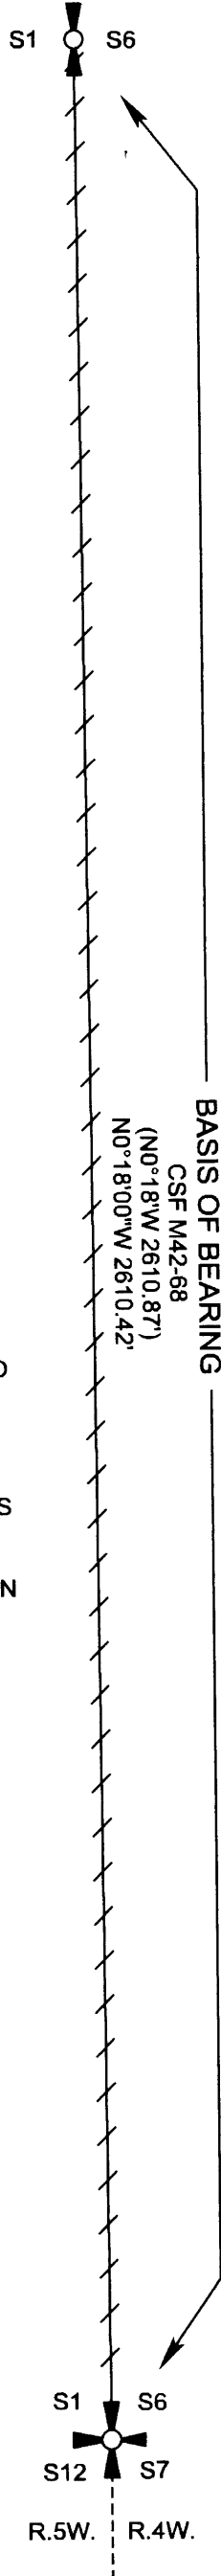


RECORD OF SURVEY
 FOR: SENECA JONES TIMBER COMPANY
 SW1/4, SEC. 6, T.22S., R.4W., W.M.
 DOUGLAS COUNTY, OREGON
 20 MARCH 2009

FILED
 Date: 4-14-2009 By: DLW
 This survey consists of:
 Map: M 159-12
 Narrative: _____
 Corner Rpt: _____

DOUGLAS COUNTY
 SURVEYOR

1/4 CORNER
 SECTIONS 1 AND 6
 FOUND 2-1/2" BRASS CAP DATED 1972
 WITH THE FOLLOWING ACCESSORIES:
 15" D. FIR BEARS S78-1/2°W 42.0' - HEALED FACE
 25" D. FIR STUMP BEARS N82°E 9.9' - HEALED FACE
 37" X 10' D. FIR STAUB BEARS N80°W 24.4' - ROTTED FACE

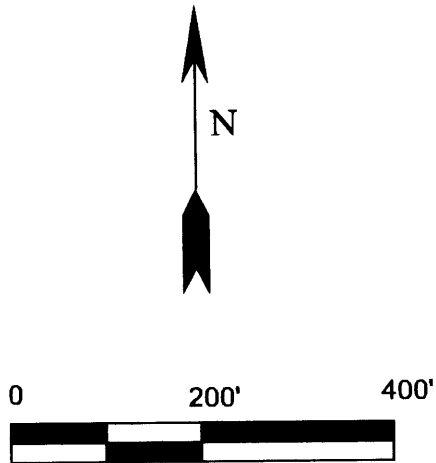

NARRATIVE:

THE PURPOSE OF THIS SURVEY WAS TO RETRACE AND MARK THE LINE AS SHOWN HEREON. CONTROLLING CORNERS WERE TIED BEFORE TRUE LINE WAS MARKED WITH RED PAINTED BLAZES, RED FLAGGING, AND 5-1/2' GALVANIZED STEEL POSTS SET AT RANDOM INTERVALS.
 THE BASIS OF BEARING FOR THIS SURVEY WAS THE RECORD FOR THE LINE SHOWN HEREON PER COUNTY SURVEY FILE M42-68.
 THIS SURVEY WAS PERFORMED USING A NIKON TOTAL STATION.

LEGEND

- FOUND SECTION CORNER AS NOTED
- FOUND 1/4 CORNER AS NOTED
- PROPERTY LINE MARKED WITH RED PAINTED BLAZES, RED FLAGGING, AND 5-1/2' GALVANIZED STEEL POSTS SET AT RANDOM INTERVALS
- () RECORD DATA CSF M42-68
- CSF COUNTY SURVEY FILE
- DCBC DOUGLAS COUNTY BRASS CAP

SECTION CORNER
 SECTIONS 1, 6, 7, 12
 FOUND 2-1/2" DCBC DATED 1959 WITH THE FOLLOWING ACCESSORIES:
 32" R. CEDAR BEARS N16°E 46.9' - HEALED FACE
 29" HEMLOCK BEARS S26°W 112.4' - HEALED FACE
 28" D. FIR BEARS N63-3/4°W 13.2' - HEALED FACE
 18" CHINQUAPIN BEARS S29-1/2°E 14.2' - HEALED FACE
 17" D. FIR BEARS S34-1/2°E 32.7' - HEALED FACE
 14" D. FIR STAUB BEARS S26-3/4°W 21.4' - ROTTED FACE

Ward NorthWest, Inc.
 P.O. BOX 105 FLORENCE, OR 97439
 (541) 997-9201 FAX: 541-997-3546

FILE NAME		
09-10.TRV		
SCALE	DATE	DRAWN BY
200 Ft/In	3-20-09	JR
JOB	REVISION	SHEET
09-10		1/1

This map drawn with TRAVERSE PC, Software

REGISTERED
 PROFESSIONAL
 LAND SURVEYOR

Ronald L. Rice

OREGON
 JULY 9, 2002
 RONALD L. RICE
 54633LS

RENEWS: 12-31-2010