

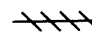

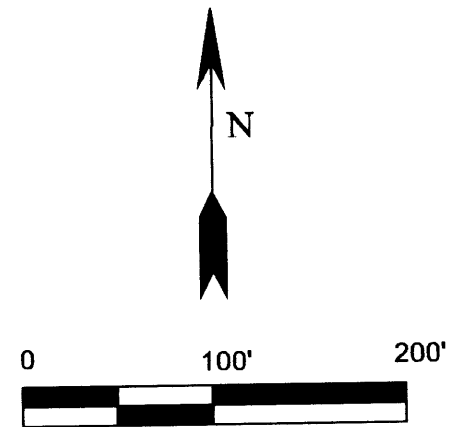


RECORD OF SURVEY
 FOR: SENECA JONES TIMBER COMPANY
 SW1/4, SEC. 6, T.22S., R.4W., W.M.
 DOUGLAS COUNTY, OREGON
 20 MARCH 2009

FILED
 Date: 4-14-2009 By: NW
 This survey consists of:
 Map: M 159-13
 Narrative: _____
 Corner Rpt: _____
 DOUGLAS COUNTY
 SURVEYOR

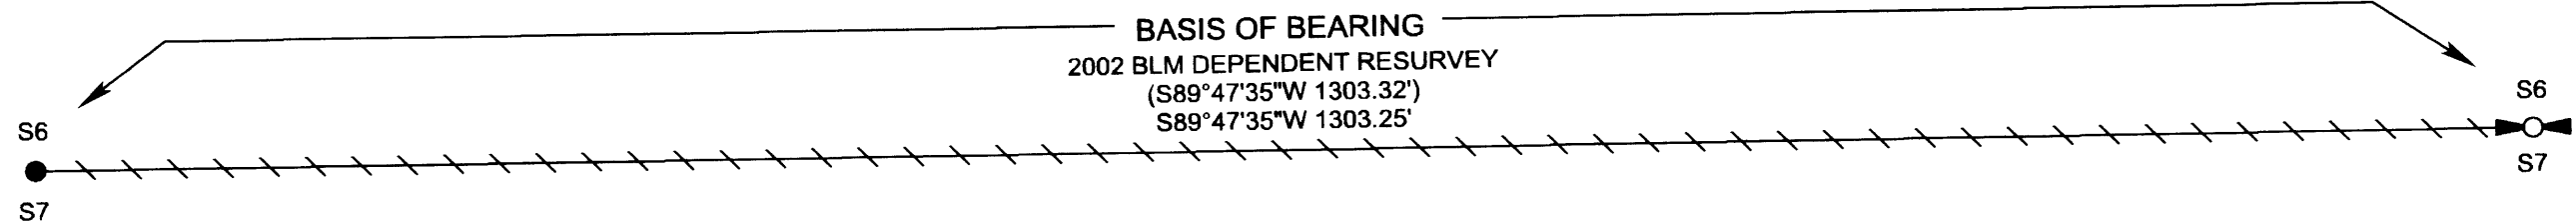
LEGEND

-  FOUND 1/4 CORNER
AS NOTED
-  FOUND 1/16 CORNER
AS NOTED
-  PROPERTY LINE MARKED WITH
RED PAINTED BLAZES, RED FLAGGING,
AND 5-1/2' GALVANIZED STEEL POSTS
SET AT RANDOM INTERVALS
-  () RECORD DATA
2002 BLM DEPENDENT RESURVEY




WEST 1/16 CORNER
 SECTIONS 6 AND 7
 FOUND 3-1/4" BLM BRASS CAP DATED 2002
 WITH THE FOLLOWING ACCESSORIES:
 14" D. FIR BEARS N82°W 35.3' - HEALED FACE
 11" D. FIR BEARS S5-1/4°W 28.8' - SCRIBING VISIBLE

1/4 CORNER
 SECTIONS 6 AND 7
 FOUND 3-1/4" BLM BRASS CAP DATED 2002
 WITH THE FOLLOWING ACCESSORIES:
 20" D. FIR BEARS N68-1/2°E 44.1' - HEALED FACE
 16" D. FIR BEARS S45-1/2°W 20.2' - HEALED FACE



NARRATIVE:

THE PURPOSE OF THIS SURVEY WAS TO RETRACE AND MARK THE LINE AS SHOWN HEREON. CONTROLLING CORNERS WERE TIED BEFORE TRUE LINE WAS MARKED WITH RED PAINTED BLAZES, RED FLAGGING, AND 5-1/2' GALVANIZED STEEL POSTS SET AT RANDOM INTERVALS.
 THE BASIS OF BEARING FOR THIS SURVEY WAS THE 2002 BLM DEPENDENT RESURVEY RECORD FOR THE LINE SHOWN HEREON.
 THIS SURVEY WAS PERFORMED USING A NIKON TOTAL STATION.



Ward NorthWest, Inc.
 P.O. BOX 105 FLORENCE, OR 97439
 (541) 997-9201 FAX: 541-997-3546

FILE NAME		
09-10.TRV		
SCALE	DATE	DRAWN BY
100 Ft/In	3-20-09	JR
JOB	REVISION	SHEET
09-10	-----	1/1

This map drawn with TRAVERSE PC, Software

REGISTERED
 PROFESSIONAL
 LAND SURVEYOR
Ronald L. Rice
 OREGON
 JULY 9, 2002
 RONALD L. RICE
 54633LS

RENEWS: 12-31-2010