

FILED
 Date: 10/1/2009 By: JC
 This survey consists of:
 Map: M159-78
 Narrative:
 Corner Rpt:
 DOUGLAS COUNTY
 SURVEYOR

LINE TABLE		
LINE	BEARING	LENGTH
①	N10°07'22"E	57.69'
R1	(N10°07'22"E	57.69')
②	N62°30'22"E	53.27'
R1	(N62°30'22"E	53.27')
③	S77°31'36"E	90.67'
R1	(S77°31'36"E	90.67')
④	S48°21'00"E	139.51'
	(139.51')	
BASIS OF BEARING PER LP 2009-0037		
⑤	S84°42'00"E	54.65'
R1	(S84°42'00"E	54.65')
⑥	S15°23'21"W	328.37'
R2	(N15°14'10"E	328.31')
⑦	S75°12'27"E	257.81'
R2	(S75°21'38"E	257.77')
⑧	S6°19'58"W	288.49'
R2	(S6°10'47"W	288.44')
⑨	S68°05'49"E	105.83'
R1	(S68°05'49"E	105.83')
⑩	N12°20'17"E	91.13'
⑪	S38°55'53"W	194.12'
⑫	N68°26'41"W	142.36'
⑬	S13°06'19"W	55.08'
⑭	N76°36'07"W	262.06'
⑮	S20°05'15"W	251.00'
⑯	N20°05'11"W	140.00'

NARRATIVE:


THE PURPOSE OF THIS MAP IS TO ADJUST THE BOUNDARY BETWEEN INSTRUMENT NUMBERS 2006-19579, 2007-004318 AND 1998-22004, DEED RECORDS OF DOUGLAS COUNTY.

PROCEDURE WAS AS FOLLOWS:

MONUMENTS OF RECORD WERE TIED AND HELD AS SHOWN. THE ORIGINAL BOUNDARY OF UNIT 1 WAS RE-CREATED BY PROPORTIONING BETWEEN FOUND MONUMENTS. MONUMENTS WERE THEN SET TO DELINEATE THE NEW BOUNDARY AS SHOWN.

LEGEND:

- SET 5/8" x 30" IRON ROD w/CAP MARKED "I.E. ENGINEERING"
- FOUND 5/8" IRON ROD
- △ CALCULATED POSITION
- () R1 RECORD AS PER LP 2009-0037A
- () R2 RECORD AS PER M125-49

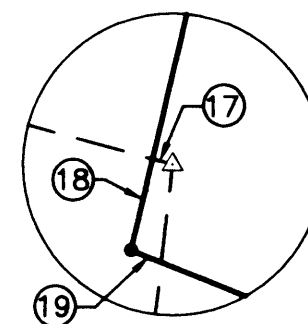

⑰	S75°12'27"E	0.72'
⑱	S13°06'19"W	3.24'
⑲	N68°26'41"W	1.14'

DETAIL A
(NOT TO SCALE)

FIELD CREW: RYAN PALMER AND JEREMY LEONARD

EQUIPMENT: TOPCON TOTAL STATION AND TDS RANGER DATA COLLECTOR

OFFICE: DEREK FEIGEL

DRAFTING: DEREK FEIGEL



0' 100 200 400
 SCALE: 1" = 200'

PLANNING DEPARTMENT FILE NO. BLA-09-03

APPROVALS:

[Signature]
 PLANNING DIRECTOR
 CITY OF SUTHERLIN

9-8-09

DATE

RECORDING:

ADJUSTED PORTION RECORDED AS
 INSTRUMENT NO. 2009-017302
 DOUGLAS COUNTY DEED RECORDS.

REGISTERED
 PROFESSIONAL
 LAND SURVEYOR

[Signature]
 OREGON
 JULY 14, 1978
 RONALD A. QUMBY
 1854

EXPIRES: 12/31/2010

BOUNDARY LINE ADJUSTMENT

IN THE SE 1/4 OF S 13 & NE 1/4 OF S 24, T25S, R6W & THE SW 1/4 OF S 18 & NW 1/4 OF S 19, T25S, R5W, W.M., D.C., OREGON

SURVEYED FOR:
 L & H LUMBER
 859 W. LOOKINGGLASS RD.
 ROSEBURG, OR. 97471

SURVEYED BY:
[Signature]
i.e.
 ENGINEERING
 809 SE Pine Street
 Roseburg, Oregon 97470
 PHONE (541) 673-0166
 FAX (541) 440-9392
 iemail@ieengineering.com

SCALE: AS NOTED
 DATE: SEPT., 2009

JOB NO: 140-94
 DWG. BY: DAF
 PM: SNL

PAGE: 1 OF 1