


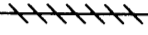
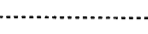


RECORD OF SURVEY
 FOR: SENECA JONES TIMBER COMPANY
 E 1/2, SECTION 16, T.26S., R.7W., W.M.
 DOUGLAS COUNTY, OREGON
 3 DECEMBER 2009

FILED
 Date: 12/16/2009 By: JC
 This survey consists of:
 Map: M160-20
 Narrative:
 Corner Rpt:
 DOUGLAS COUNTY
 SURVEYOR

LEGEND

-  SECTION CORNER
-  1/4 CORNER
-  1/16 CORNER
-  MARKED PROPERTY LINE AS DEFINED IN NARRATIVE
-  DELAPIDATED FENCE
- () RECORD DATA - 1855 GLO
- [] RECORD DATA - 1974 BLM DEPENDENT RESURVEY
- DCSO DOUGLAS COUNTY SURVEYOR'S OFFICE
- GLO GENERAL LAND OFFICE
- BLM BUREAU OF LAND MANAGEMENT

NARRATIVE:





THE PURPOSE OF THIS SURVEY WAS TO MARK THE PROPERTY LINES AS SHOWN HEREON. ALL CONTROLLING CORNERS WERE TIED IN A CONTROL TRAVERSE BEFORE THE MARKING OF TRUE LINE. TRUE LINE WAS MARKED WITH RED PAINTED BLAZES, RED FLAGGING, AND 5-1/2' GALVANIZED STEEL POSTS SET AT RANDOM INTERVALS.
 THE BASIS OF BEARING FOR THIS SURVEY WAS THE 1855 GLO RECORD FOR THE EAST LINE OF SECTION 16.
 THIS SURVEY WAS PERFORMED USING A NIKON TOTAL STATION.

"A"
 SECTION CORNER
 SECTIONS 9, 10, 15, 16
 FOUND 3-1/4" BLM BRASS CAP DATED 1963
 WITH THE FOLLOWING ACCESSORIES:
 33" D. FIR STUMP BEARS N 78° E 9.9' BARK SCRIBE VISIBLE
 53" D. FIR BEARS S 18-1/2° E 29.0' BARK SCRIBE VISIBLE
 39" D. FIR BEARS N 59° E 46.9' HEALED FACE
 37" D. FIR BEARS S 89° W 24.4' HEALED FACE
 20" W. FIR BEARS N 48° W 7.6' HEALED FACE

"B"
 1/4 CORNER
 SECTIONS 15, 16
 FOUND 3" DCSO BRASS CAP DATED 1966
 WITH THE FOLLOWING ACCESSORIES:
 29" D. FIR BEARS N85°E 8.6' - HEALED FACE
 21" MADRONE BEARS N17°W 63.4' - HEALED FACE
 42" X 30' D. FIR STAUB BEARS N10°W 26.4' - OPENED FACE
 31" X 8' D. FIR STAUB BEARS N58°E 49.2' - SCRIBING VISIBLE

"C"
 SECTION CORNER
 SECTIONS 15, 16, 21, 22
 FOUND 3-1/4" BLM BRASS CAP DATED 1959
 WITH THE FOLLOWING ACCESSORIES:
 20" I. CEDAR BEARS N43°W 21.2' - HEALED FACE
 18" W. FIR BEARS N44°E 12.7' - HEALED FACE
 16" W. FIR (RECORD HEMLOCK) BEARS N54°W 9.2' - HEALED FACE
 14" D. FIR BEARS S21°W 19.8' - HEALED FACE
 14" W. FIR BEARS S41°E 11.5' - HEALED FACE

"D"
 EAST 1/16 CORNER
 SECTIONS 16, 21
 FOUND 20" D. FIR CORNER TREE WITH
 THE FOLLOWING ACCESSORIES:
 28" D. FIR BEARS N9°E 35.6' - HEALED FACE
 24" D. FIR BEARS S83°E 29.7' - HEALED FACE
 3-1/4" BLM REFERENCE MONUMENT BRASS CAP
 DATED 1974 BEARS S83°E 19.8'

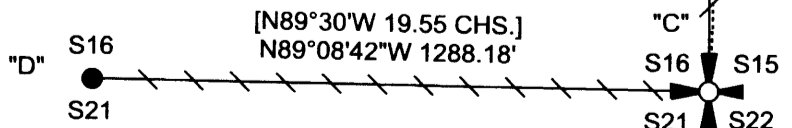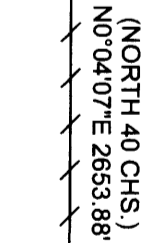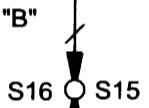
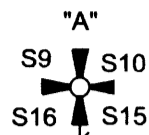


(NORTH 40 CHS.)
 N0°04'09" W 2630.37'

BASIS OF BEARING
 1855 GLO RECORD
 (NORTH 80 CHS.)
 NORTH 5284.25'

(NORTH 40 CHS.)
 N0°04'07" E 2653.88'

[N89°30'W 19.55 CHS.]
 N89°08'42"W 1288.18'

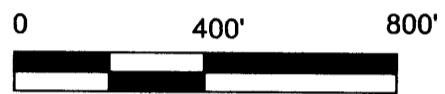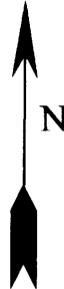

REGISTERED
 PROFESSIONAL
 LAND SURVEYOR

Ronald L. Rice

OREGON
 JULY 9, 2002
 RONALD L. RICE
 54633LS

RENEWAL DATE: 12-31-2010



Ward NorthWest, Inc.

P.O. BOX 105 FLORENCE, OR 97439
 (541) 997-9201 FAX: 541-997-3546

FILE NAME		
09-66.TRV		
SCALE	DATE	DRAWN BY
400 Ft/In	12-3-2009	JR
JOB	REVISION	SHEET
09-66		1/1

This map drawn with TRAVERSE PC, Software