

FILED

Date: 3-2-2010 By: JC
This survey consists of:
Map: M160-42
Narrative:
Corner Rpt:

MAP OF SURVEY

LOCATED in the SE 1/4 of Section 8, T. 27 S., R. 3 W., W.M.
in Douglas County, Oregon.

SURVEYED FOR: *SENECA JONES TIMBER CO.*
P.O. BOX 2129
ROSEBURG, OREGON 97470

March 1, 2010


DOUGLAS COUNTY
SURVEYOR

REGISTERED
PROFESSIONAL
LAND SURVEYOR

David A. Edwards
OREGON
JULY 26, 1988
DAVID A. EDWARDS
RENEWS 12731711

SURVEYED BY: *DAVID EDWARDS LAND SURVEYING*
P.O. BOX 361
OAKLAND, OREGON 97462
PHONE: (541)459-0512

1/4 CORNER
THE 4 B.T.'S SHOWN
ON C.S. 65/34-8 ARE
ALL NOW HIGH STUMPS.
NO TREES WITHIN 200'

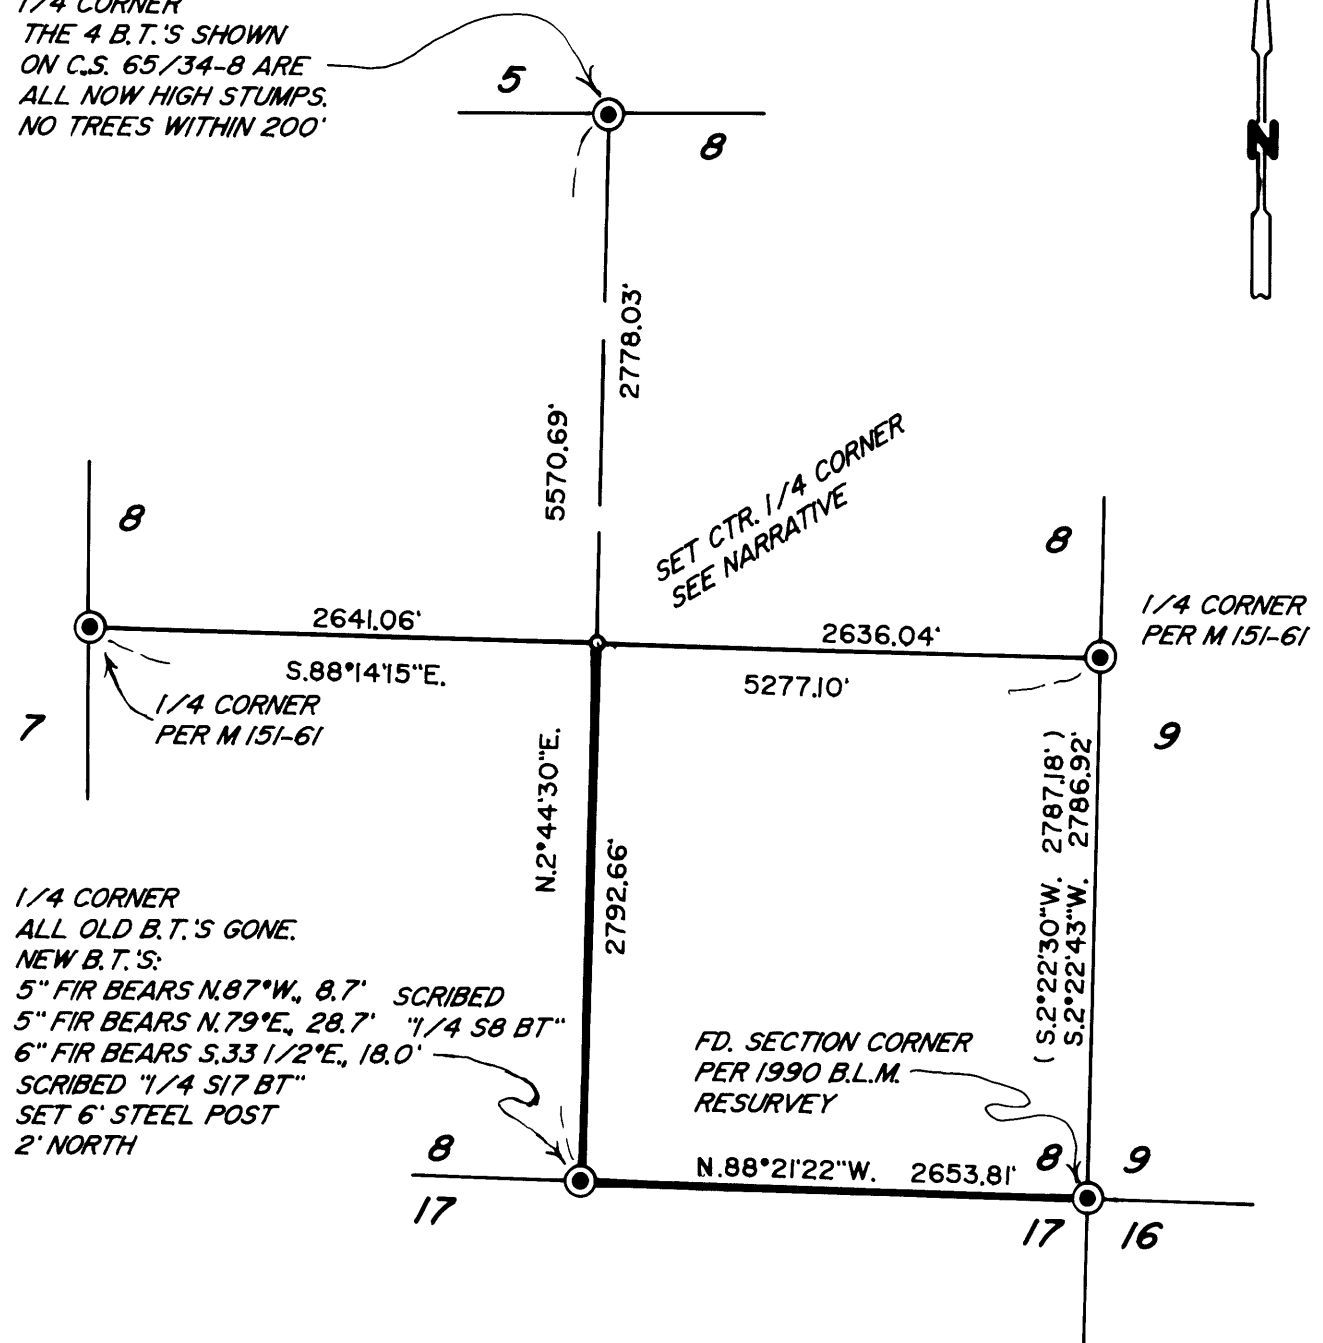

LEGEND

- ⊙ INDICATES COUNTY SURVEYOR OR B.L.M. BRASS CAP FOUND.
- INDICATES 5/8" X 30" STEEL REBAR WITH 2 1/2" DIAM. ALUM. CAP STAMPED PER 1973 MANUAL AND STAMPED "LS 2339" AND "2010".
- () DENOTES B.L.M. RECORD DATA.
- INDICATES LINE BLAZED AND POSTED THIS SURVEY.

SCALE: 1" = 1000'

BASIS OF BEARINGS: EXISTING CONTROL PER MY SURVEY M 151-61.

NARRATIVE

THE PURPOSE OF THIS SURVEY IS TO MARK THE WEST AND SOUTH LINES OF THE SE 1/4 OF SECTION 8. EXISTING CONTROL POINTS FROM MY SURVEY M 151-61 WERE FOUND AND USED TO TIE IN THE NORTH 1/4 COR., SOUTH 1/4 COR. AND SE SECTION CORNER. MY PREVIOUS POSITIONS FOR THE EAST AND WEST 1/4 CORNERS WERE HELD TO COMPUTE THE CENTER 1/4 CORNER. THE SUBJECT BOUNDARIES WERE MARKED BY BLAZING TREES ON EACH SIDE OF LINE, BY SETTING 6 FOOT STEEL POSTS ALONG THE LINE AT INTERVALS OF 200 FEET OR LESS AND BY HANGING LIBERAL AMOUNTS OF RED FLAGGING ALONG THE TRUE LINE.

BEARING TREES ESTABLISHED AT THE CENTER 1/4 CORNER ARE SCRIBED "C 1/4 S8 BT", ARE MEASURED TO CENTER OF TREE AT ROOT CROWN AND ARE SITUATED AS FOLLOWS:

- A 13" DIAM. CEDAR BEARS N.49°E., 15.7 FEET.
- A 6" DIAM. CEDAR BEARS S.45°W., 19.9 FEET.
- A 6" DIAM. CEDAR BEARS N.83°W., 35.2 FEET.
- A 6 FOOT STEEL POST IS SET 2 FEET SOUTH.

FIELD CREW: BRANT MILLER AND ERIC SPRINKLE.

EQUIPMENT: NIKON TOTAL STATION.

COMPUTATIONS AND DRAFTING: DAVID EDWARDS.

MAP FILE M160-42

MAP FILE M160-42